

# SYMBOL LEGEND


- (R) - RECORD DATA
- (M) - MEASURED DATA
- ⊕ - UTILITY POLE
- OHW- - OVERHEAD WIRES
- ⊙ - AIR CONDITIONER
- - CLEANOUT
- ⊕ - CATCHBASIN
- - YARD DRAIN
- - CATCHBASIN
- FENCE LINE
- - BUFFALO BOX
- - STORM SEWER
- EXIST. CONTOURS
- XXX.XX - EXISTING ELEVATION
- - CONCRETE SURFACE

"AS-BUILT"

# PLAT OF SURVEY

PROFESSIONAL LAND SURVEYING, INC.

3080 OGDEN AVENUE SUITE 307  
LISLE, ILLINOIS 60532  
PHONE 630-778-1757  
PROF. DESIGN FIRM # 184 004196  
E-MAIL info@pls.net

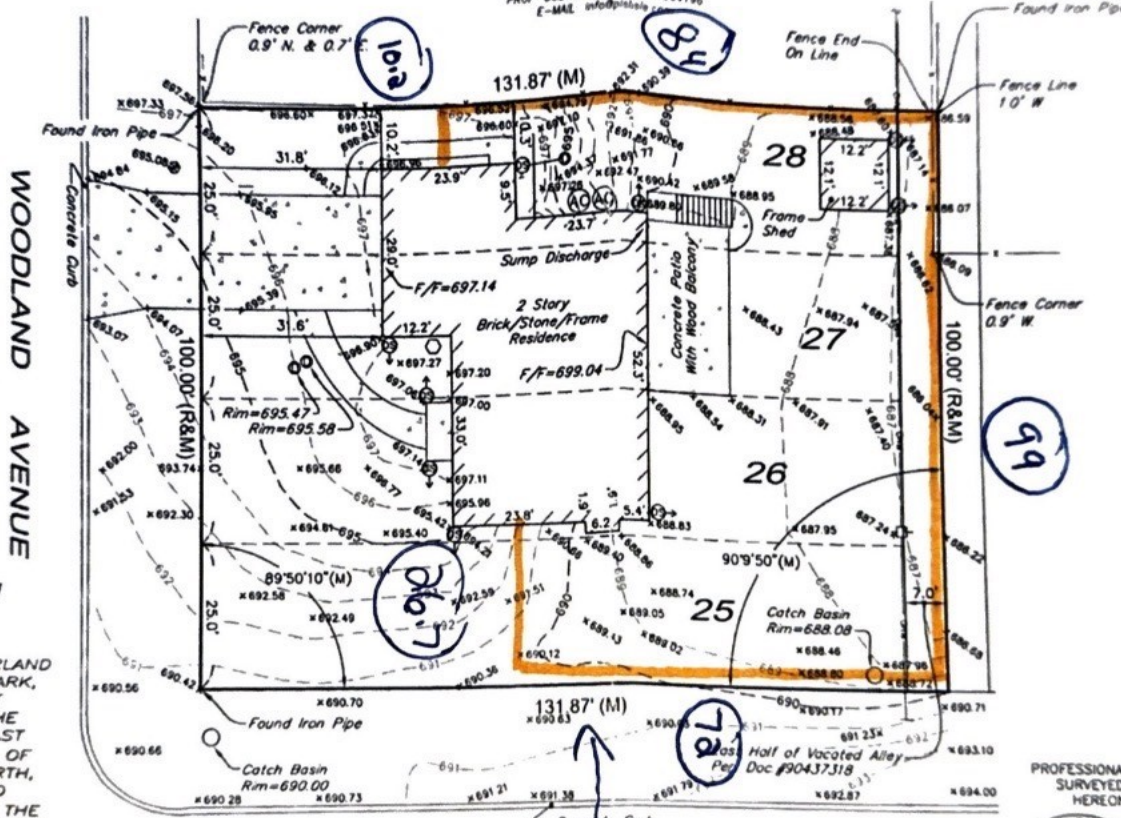

PARCEL NO. 18, MAP 27-09-111-014

## IMPERVIOUS SURFACE AREA

RESIDENCE: 2,343± SQ. FT.  
SHED: 148± SQ. FT.  
CONCRETE DRIVEWAY, WALKWAY & STOPS: 987± SQ. FT.  
REAR PATIO, WALLS & BASEMENT ENTRY: 458± SQ. FT.

(SURFACE AREA CALCULATION ABOVE INCLUDE ONLY THOSE AREAS WITHIN PARCEL. ALSO INCLUDES ONLY THOSE SPECIFICALLY DESCRIBED AND DO NOT INCLUDE OTHER AREAS SUCH AS CONCRETE AIR CONDITIONER PADS)

SURVEYED AREA: 13,187± SQ. FT.

REFER TO YOUR DEED, ABSTRACT, TITLE POLICY AND LOCAL BUILDING AND ZONING ORDINANCE FOR ITEMS NOT SHOWN HEREON.

NO MEASUREMENTS ARE TO BE ASSUMED BY SCALING

STATE OF ILLINOIS }  
COUNTY OF DUPAGE } 35

PROFESSIONAL LAND SURVEYING, INC. HEREBY CERTIFIES THAT IT HAS SURVEYED THE TRACT OF LAND ABOVE DESCRIBED, AND THAT THE HEREON DRAWN PLAT IS A CORRECT REPRESENTATION THEREOF.

FIELD WORK COMPLETED AND DATED THIS 20TH DAY OF JULY 2016.



PLS No. 3483  
MY LICENSE EXPIRES 11/30/2016

THIS PROFESSIONAL SERVICE CONFORMS TO THE CURRENT ILLINOIS MINIMUM STANDARDS FOR A BOUNDARY SURVEY

## LEGAL DESCRIPTION

LOTS 25, 26, 27 AND 28 IN BLOCK 6 IN THE PEOPLES ORLAND PARK ADDITION, IN ORLAND PARK, BEING A SUBDIVISION OF THAT PART NORTH AND WEST OF THE WABASH RAILROAD, OF THE EAST 1/2 OF THE NORTHWEST 1/4 OF SECTION 9, TOWNSHIP 36 NORTH, RANGE 12 EAST OF THE THIRD PRINCIPAL MERIDIAN, (EXCEPT THE NORTH FOUR ACRES THEREOF), IN COOK COUNTY, ILLINOIS.



PREPARED FOR: BURDELIK BUILDERS  
ADDRESS: 14461 WOODLAND AVENUE, ORLAND PARK, ILLINOIS  
BOOK & PG. \_\_\_\_\_ DATE: 6/22/2016 JOB NO: 105942  
DRAWN BY: JHH CHECK BY: SAR  
REVISED \_\_\_\_\_

145TH STREET

(66' ± O.W.)  
1 FOOT  
STAY  
OFF  
PROP.  
LINE