



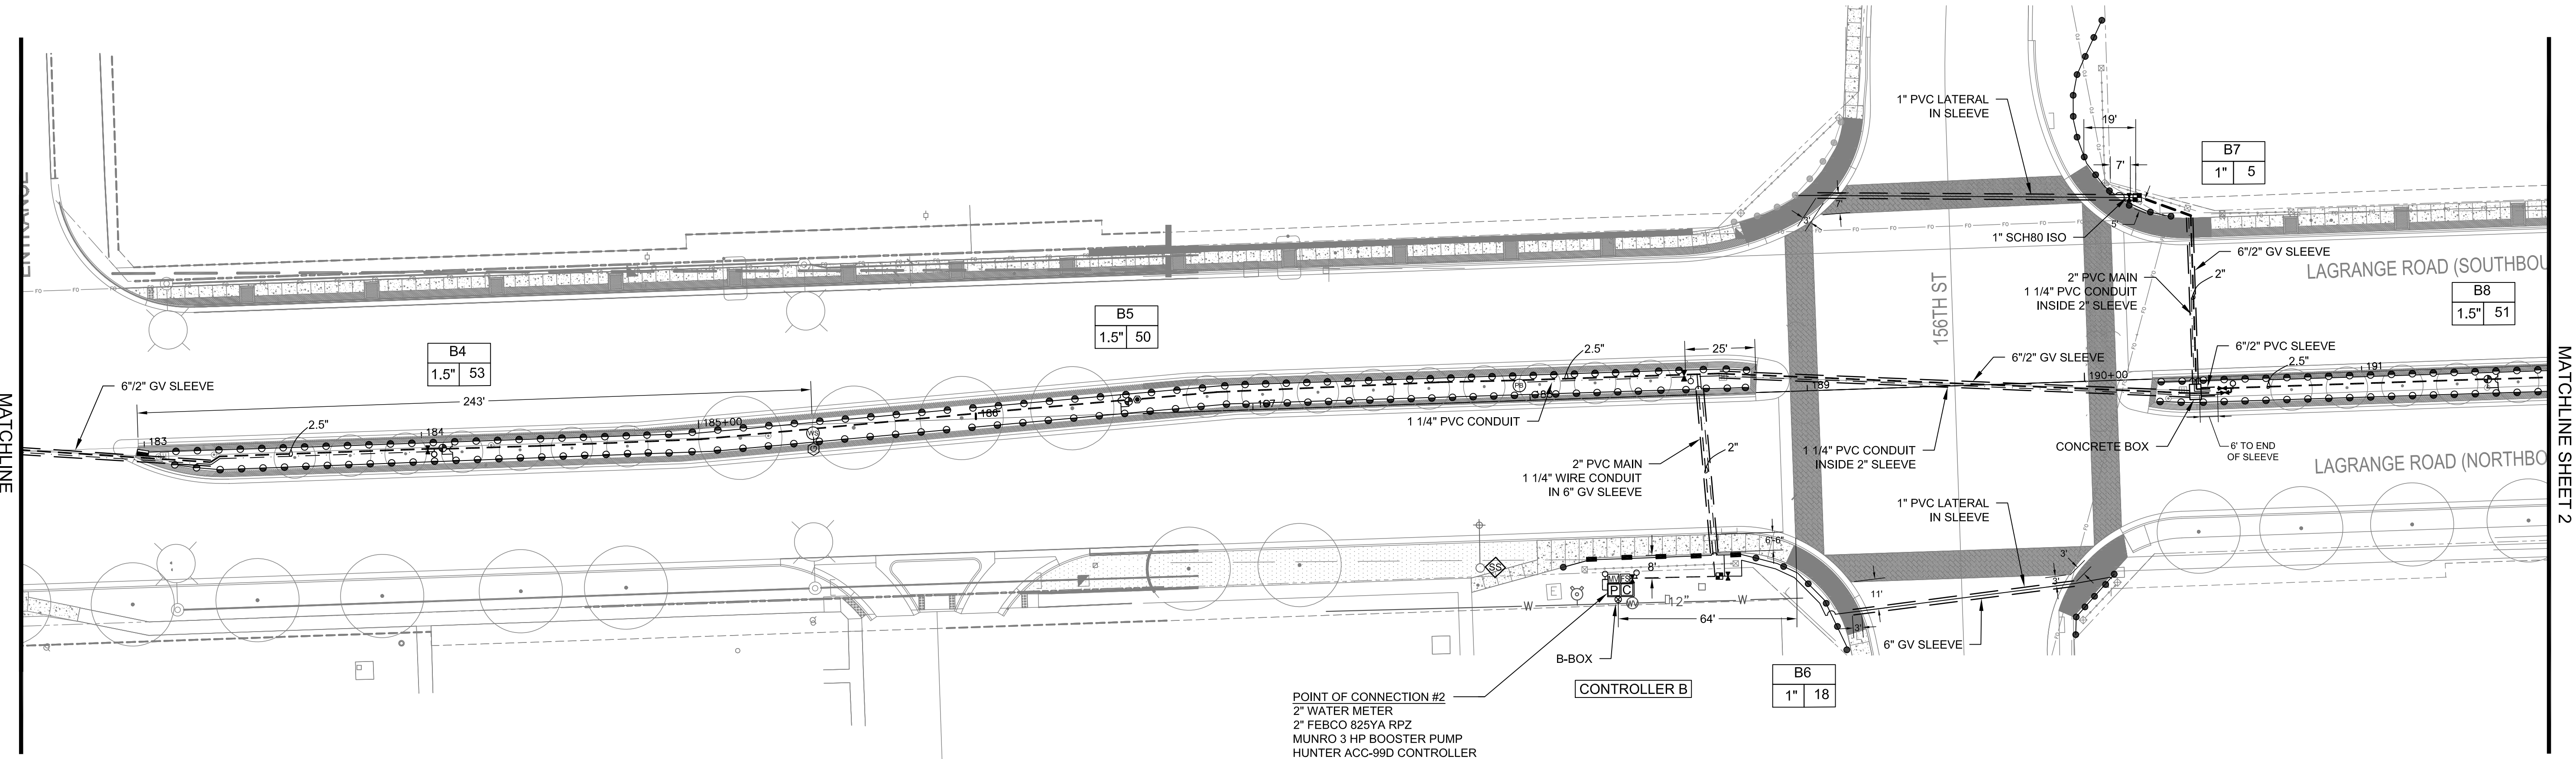

SCALE: 1"=30'-0"

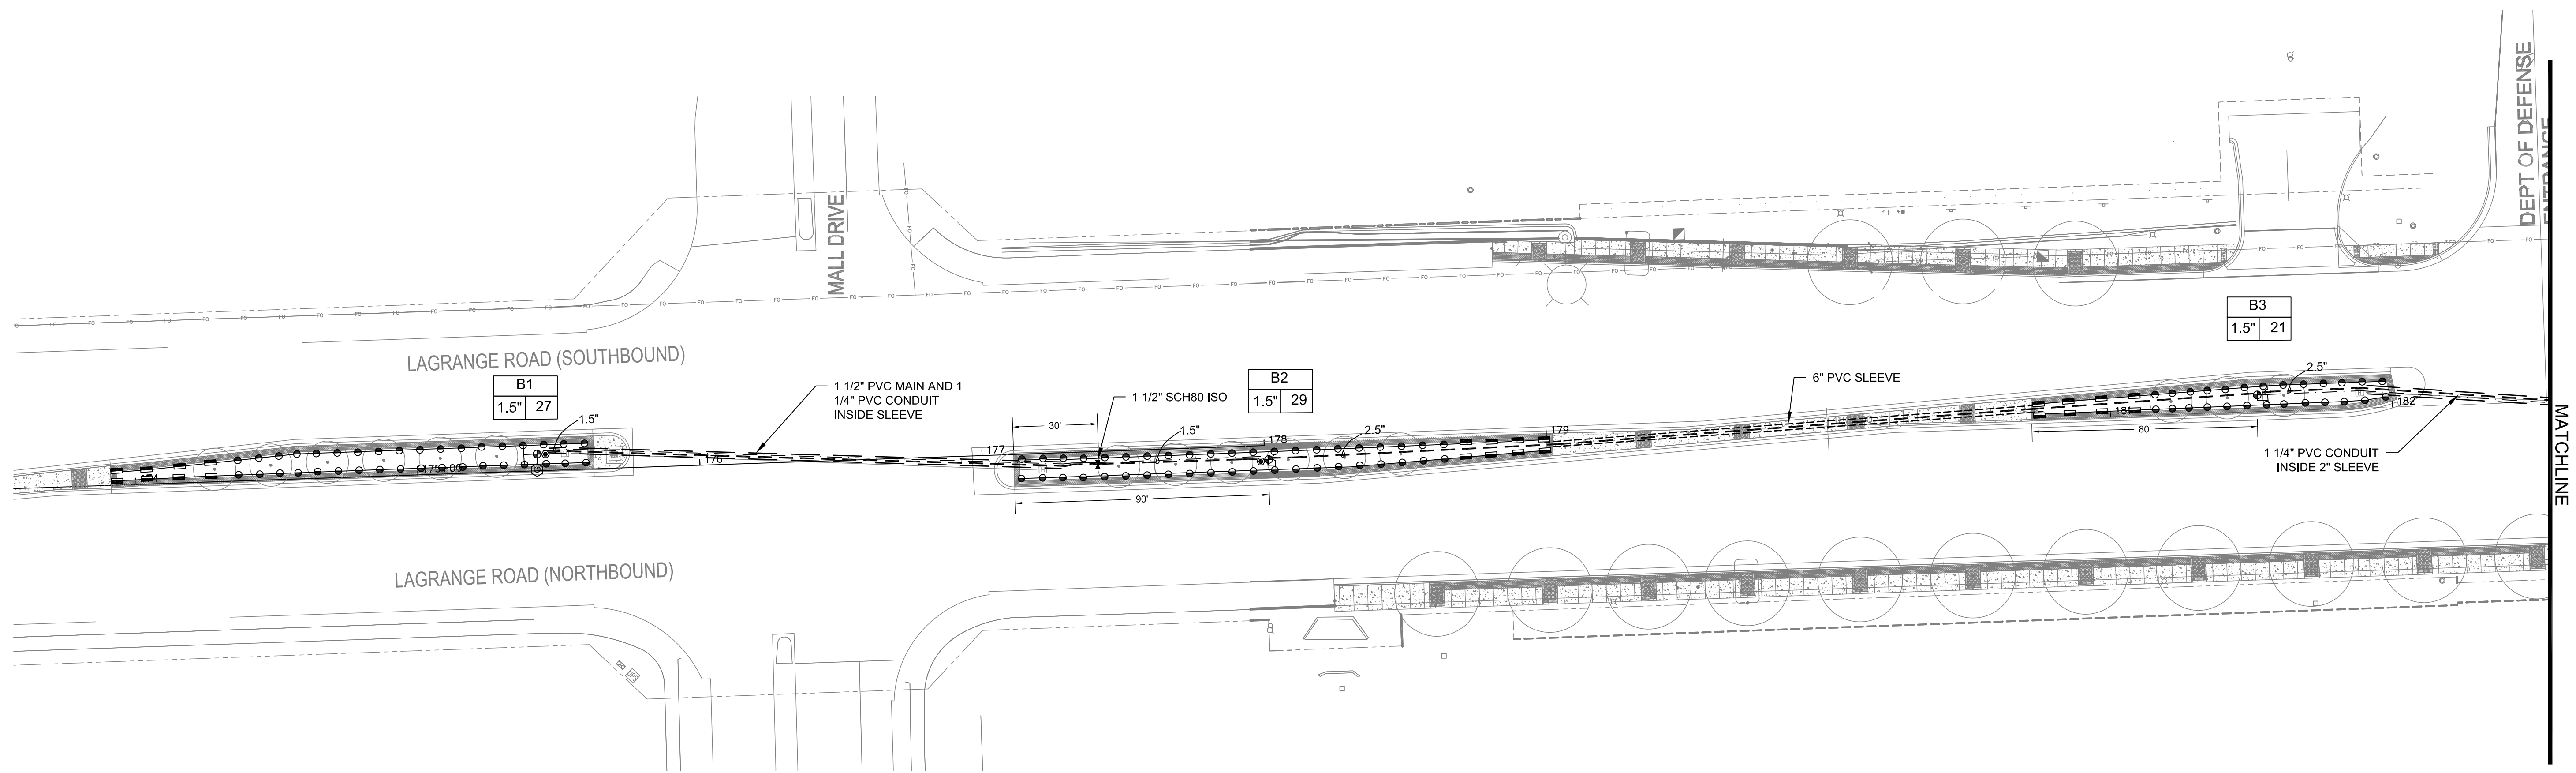

**LEGEND**

● HUNTER 4" SPRAY HEAD, 8' - 17' RADIUS	— POLY HD LATERAL PIPE
● HUNTER 12" SPRAY HEAD, 8' - 17' RADIUS	— 3" PVC CL200 SDR21 MAINLINE PIPE
▬ HUNTER 4" SPRAY HEAD 15' STRIP	— IRRIGATION SLEEVE
▬ HUNTER 12" SPRAY HEAD 15' STRIP	□ HUNTER ACC-D DECODER CONTROLLER
⊕ HUNTER ICV 1.5" ELECTRIC VALVE	⊕ HUNTER SOLAR SYNC WEATHER SENSOR
⊕ HUNTER ICV 1" ELECTRIC VALVE	□ IRRIGATION BOOSTER PUMP STATION
▶ LEEMCO MANUAL ISOLATION VALVE	⊗ B-BOX
⊕ HUNTER 1" QUICK COUPLER	

**CENTRAL**  
Lawn Sprinklers Inc.



239 King Street • Elk Grove Village, IL 60007 • Phone: (847) 364-6900 • Fax: (847) 364-9774

**LAGRANGE ROAD IMPROVEMENTS**  
**ORLAND PARK, ILLINOIS**  
Segment 2 - 159th St to 143rd St  
**IRRIGATION AS-BUILT**

PROJECT NO.	15780
DESIGNED BY:	KM
DRAWN BY:	KM
CHECKED BY:	JC
DATE:	OCT 31, 2017
SCALE:	1" = 30'
SHEET	1



SCALE: 1"=30'-0"

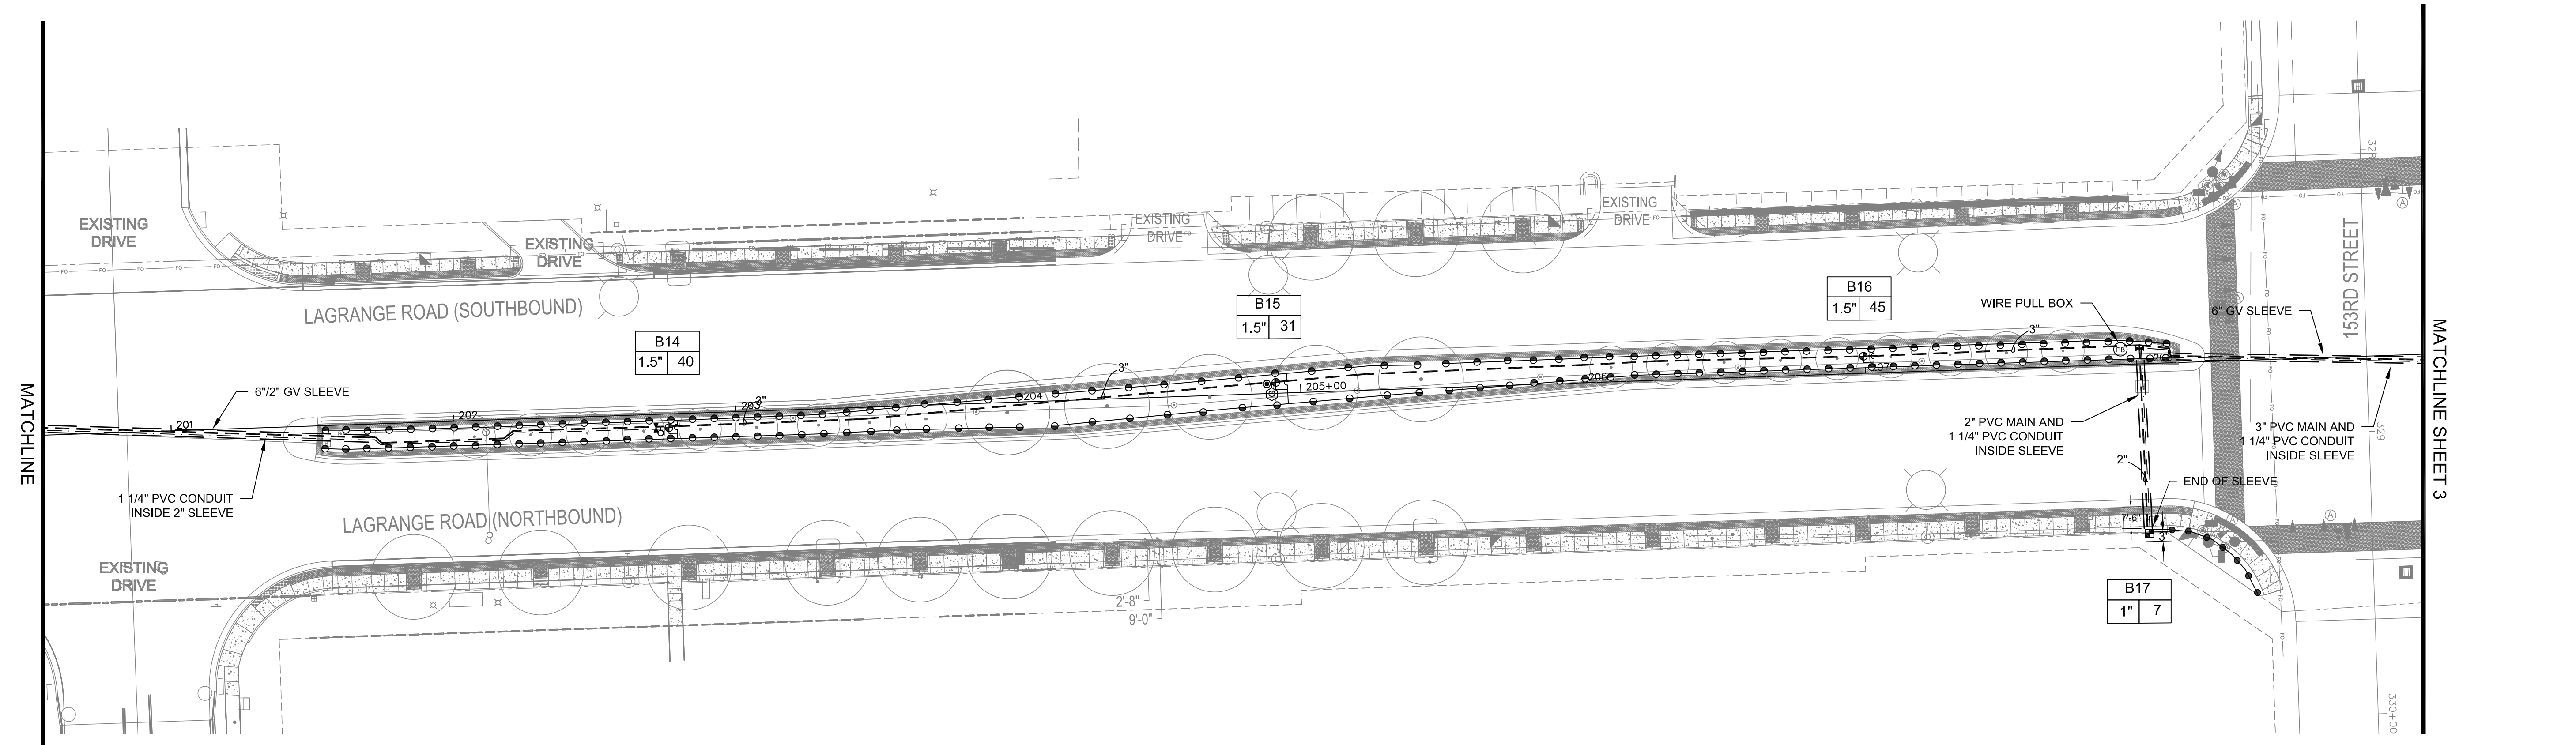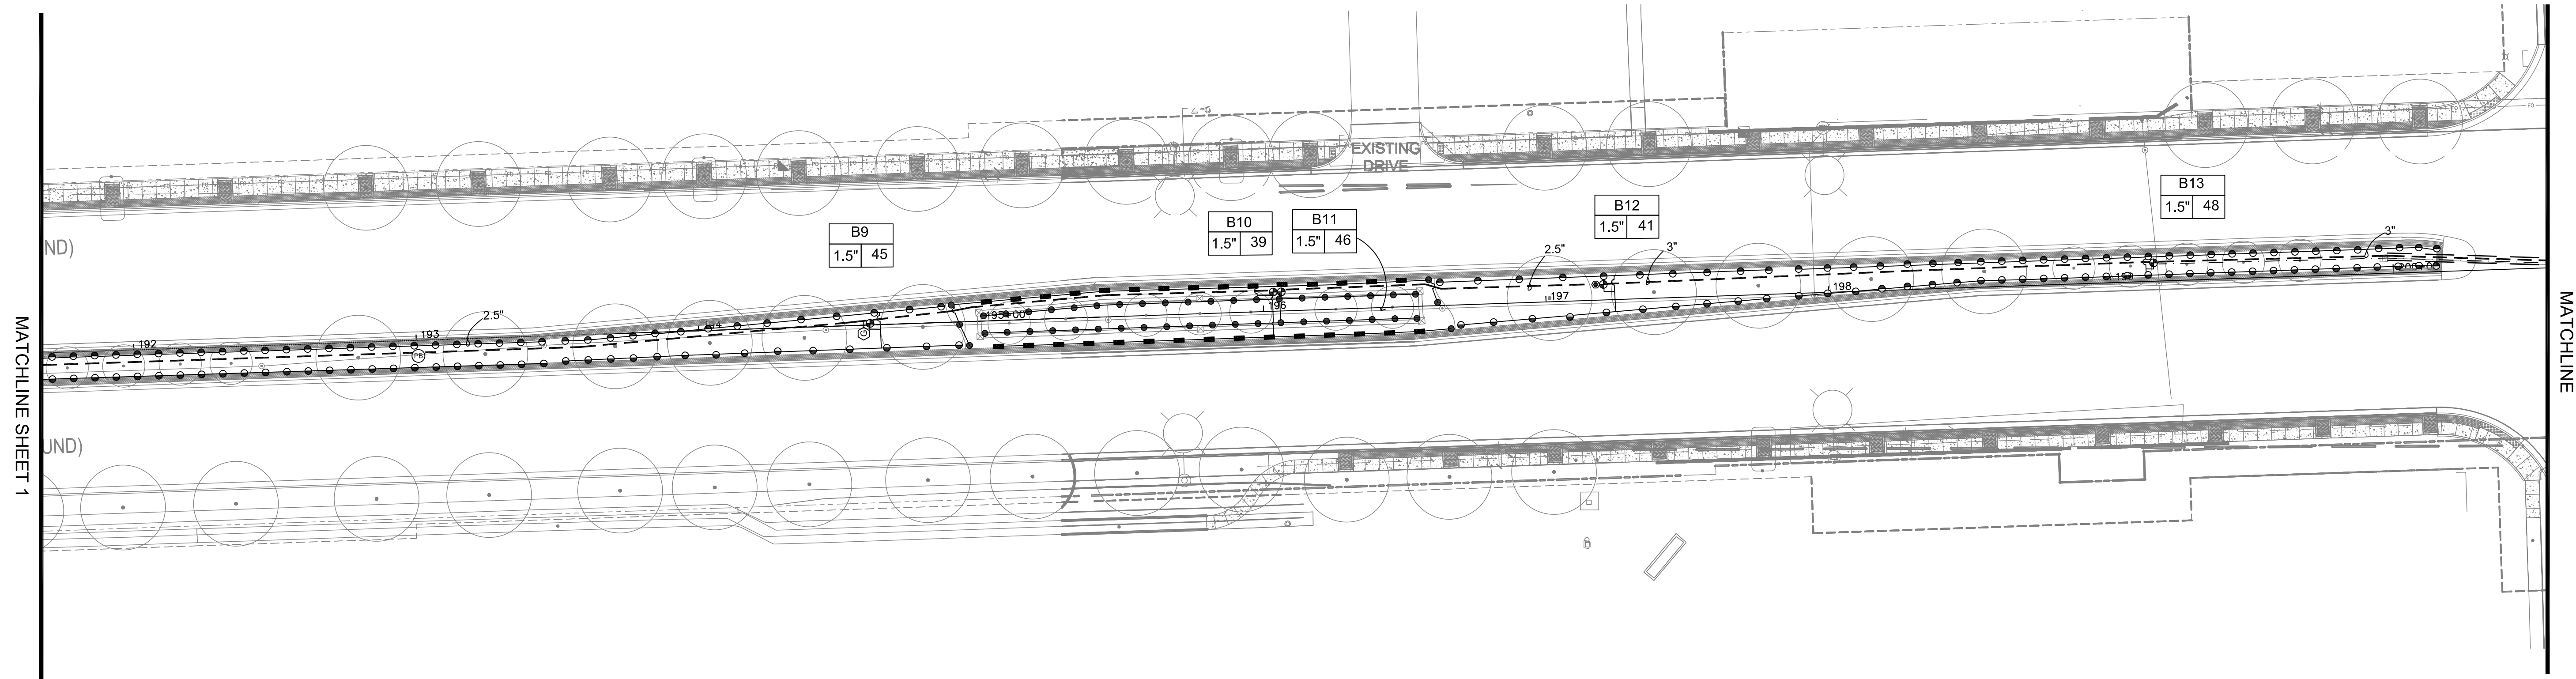

**LEGEND**

- HUNTER 4" SPRAY HEAD, 8' - 17' RADIUS
- HUNTER 12" SPRAY HEAD, 8' - 17' RADIUS
- ▬ HUNTER 4" SPRAY HEAD 15' STRIP
- ▬ HUNTER 12" SPRAY HEAD 15' STRIP
- ⊕ HUNTER ICV 1.5" ELECTRIC VALVE
- ⊕ HUNTER ICV 1" ELECTRIC VALVE
- ⊕ LEEMCO MANUAL ISOLATION VALVE
- ⊕ HUNTER 1" QUICK COUPLER
- POLY HD LATERAL PIPE
- 3" PVC CL200 SDR21 MAINLINE PIPE
- IRRIGATION SLEEVE
- ⊠ HUNTER ACC-D DECODER CONTROLLER
- ⊠ HUNTER SOLAR SYNC WEATHER SENSOR
- ⊠ IRRIGATION BOOSTER PUMP STATION
- ⊠ B-BOX




**CENTRAL**  
Lawn Sprinklers Inc.

239 King Street • Elk Grove Village, IL 60007 • Phone: (847) 364-6900 • Fax: (847) 364-9774

**LAGRANGE ROAD IMPROVEMENTS**  
**ORLAND PARK, ILLINOIS**  
Segment 2 - 159th St to 143rd St  
**IRRIGATION AS-BUILT**

PROJECT NO.	15780
DESIGNED BY:	KM
DRAWN BY:	KM
CHECKED BY:	JC
DATE:	OCT 31, 2017
SCALE:	1" = 30'
SHEET	2



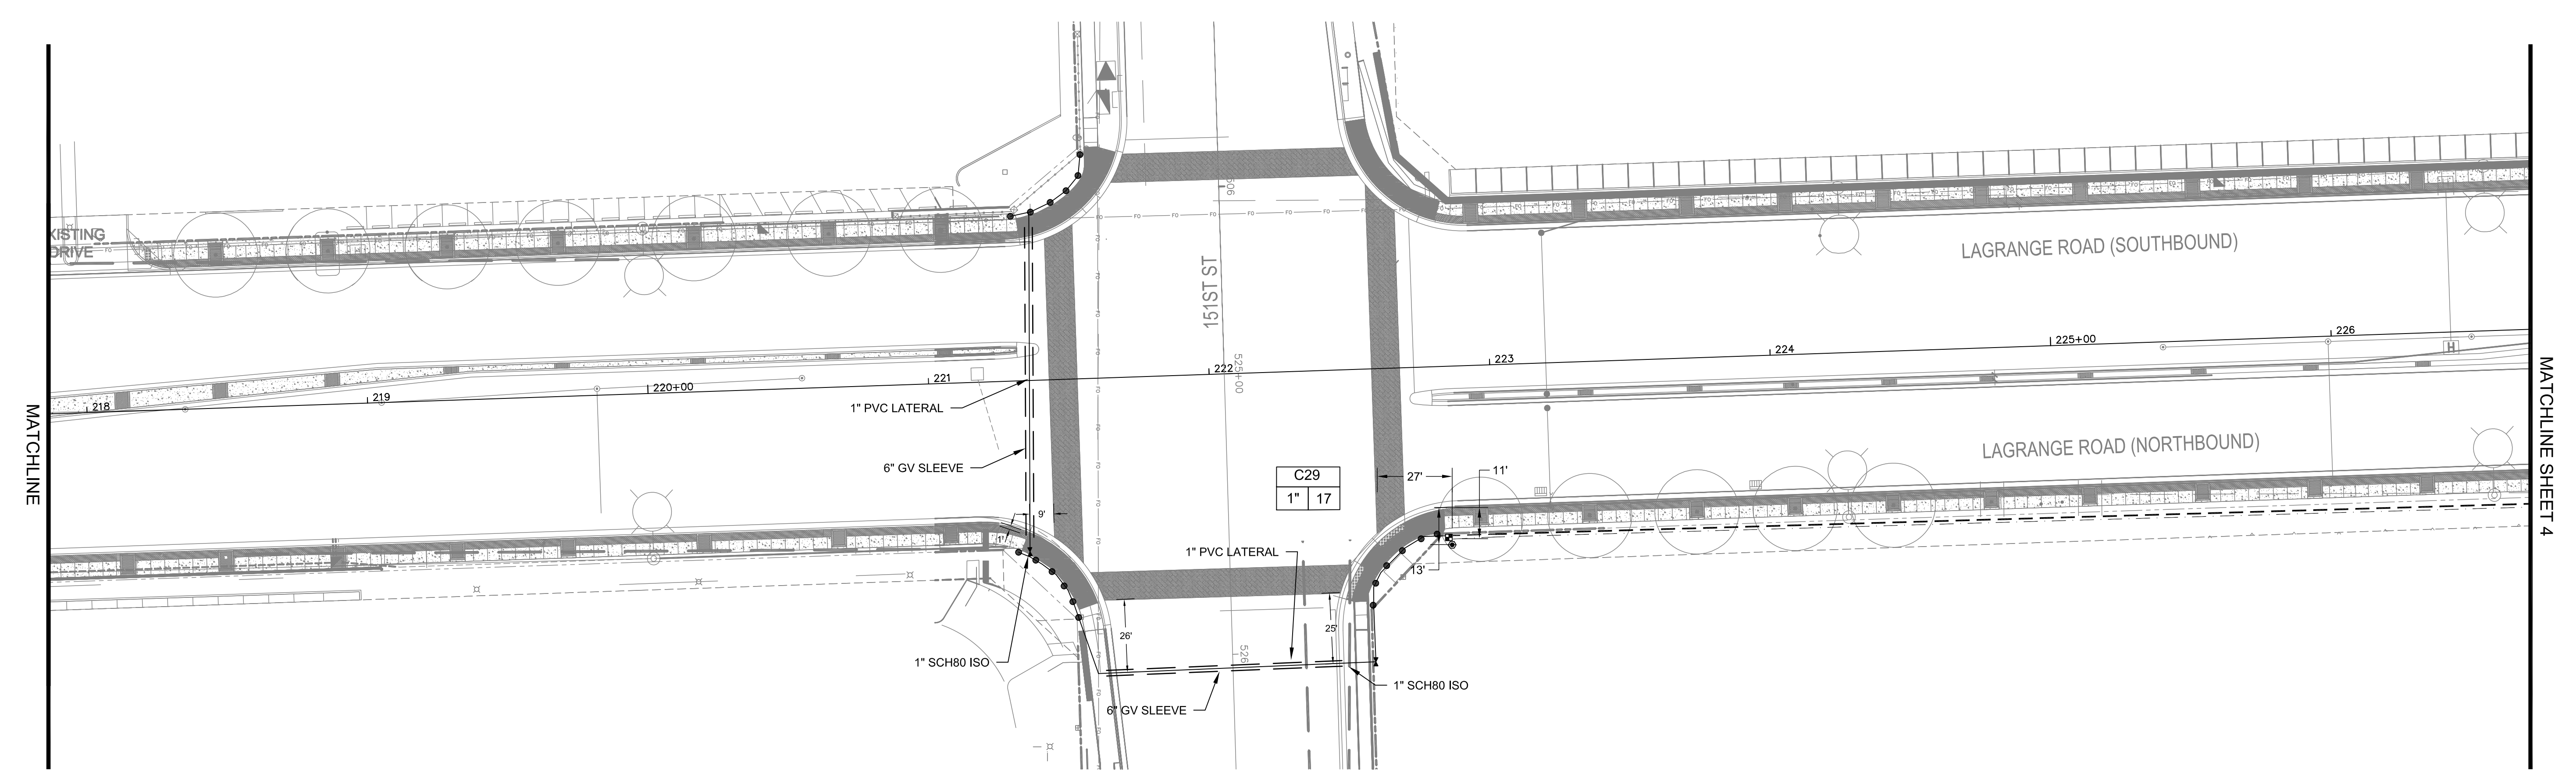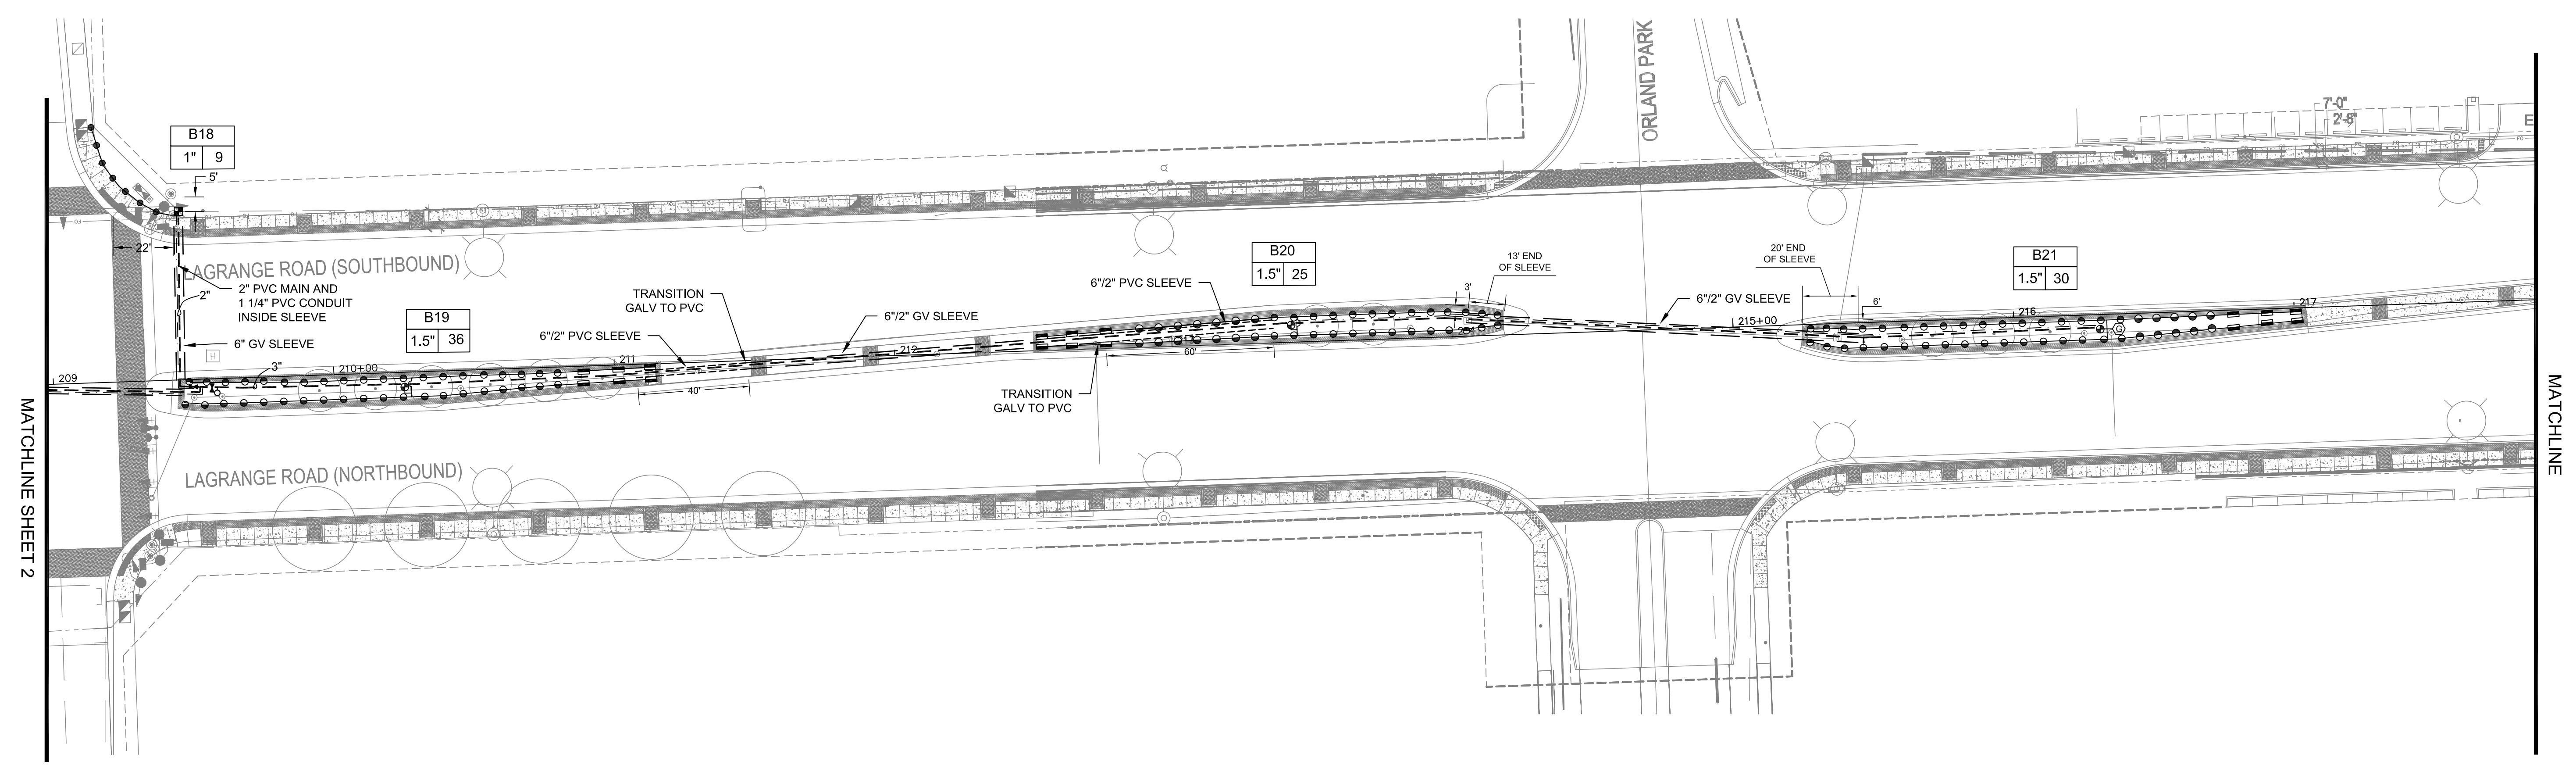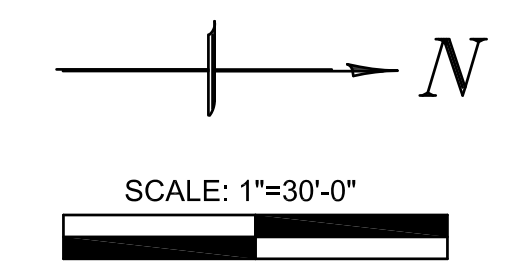


**LEGEND**

● HUNTER 4" SPRAY HEAD, 8' - 17' RADIUS	— POLY HD LATERAL PIPE
● HUNTER 12" SPRAY HEAD, 8' - 17' RADIUS	— 3" PVC CL200 SDR21 MAINLINE PIPE
▬ HUNTER 4" SPRAY HEAD 15' STRIP	— IRRIGATION SLEEVE
▬ HUNTER 12" SPRAY HEAD 15' STRIP	□ HUNTER ACC-D DECODER CONTROLLER
⊕ HUNTER ICV 1.5" ELECTRIC VALVE	⊕ HUNTER SOLAR SYNC WEATHER SENSOR
⊕ HUNTER ICV 1" ELECTRIC VALVE	□ IRRIGATION BOOSTER PUMP STATION
▶ LEEMCO MANUAL ISOLATION VALVE	⊗ B-BOX
⊕ HUNTER 1" QUICK COUPLER	



**CENTRAL**  
Lawn Sprinklers Inc.  
239 King Street • Elk Grove Village, IL 60007 • Phone: (847) 364-6900 • Fax: (847) 364-9774

**LAGRANGE ROAD IMPROVEMENTS**  
**ORLAND PARK, ILLINOIS**  
Segment 2 - 159th St to 143rd St  
**IRRIGATION AS-BUILT**

PROJECT NO.	15780
DESIGNED BY:	KM
DRAWN BY:	KM
CHECKED BY:	JC
DATE:	OCT 31, 2017
SCALE:	1" = 30'
SHEET	3

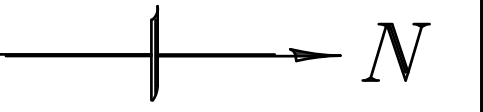

SCALE: 1"=30'-0"

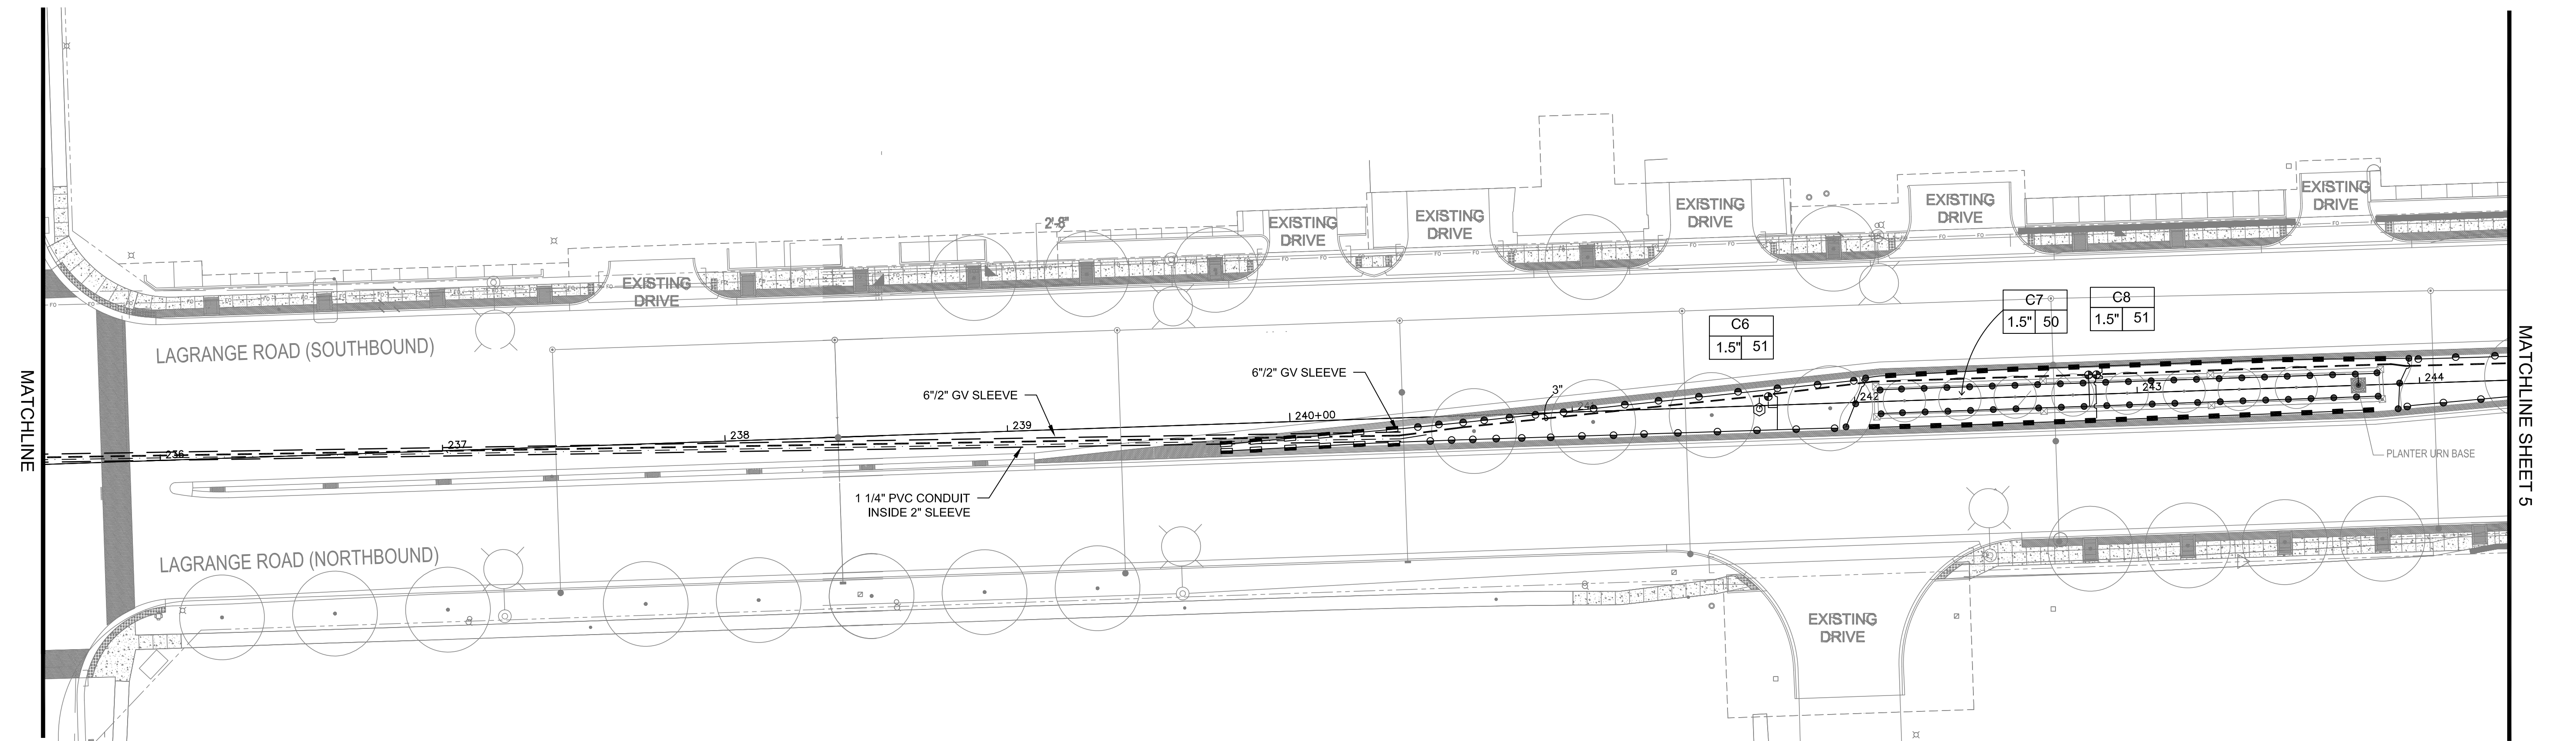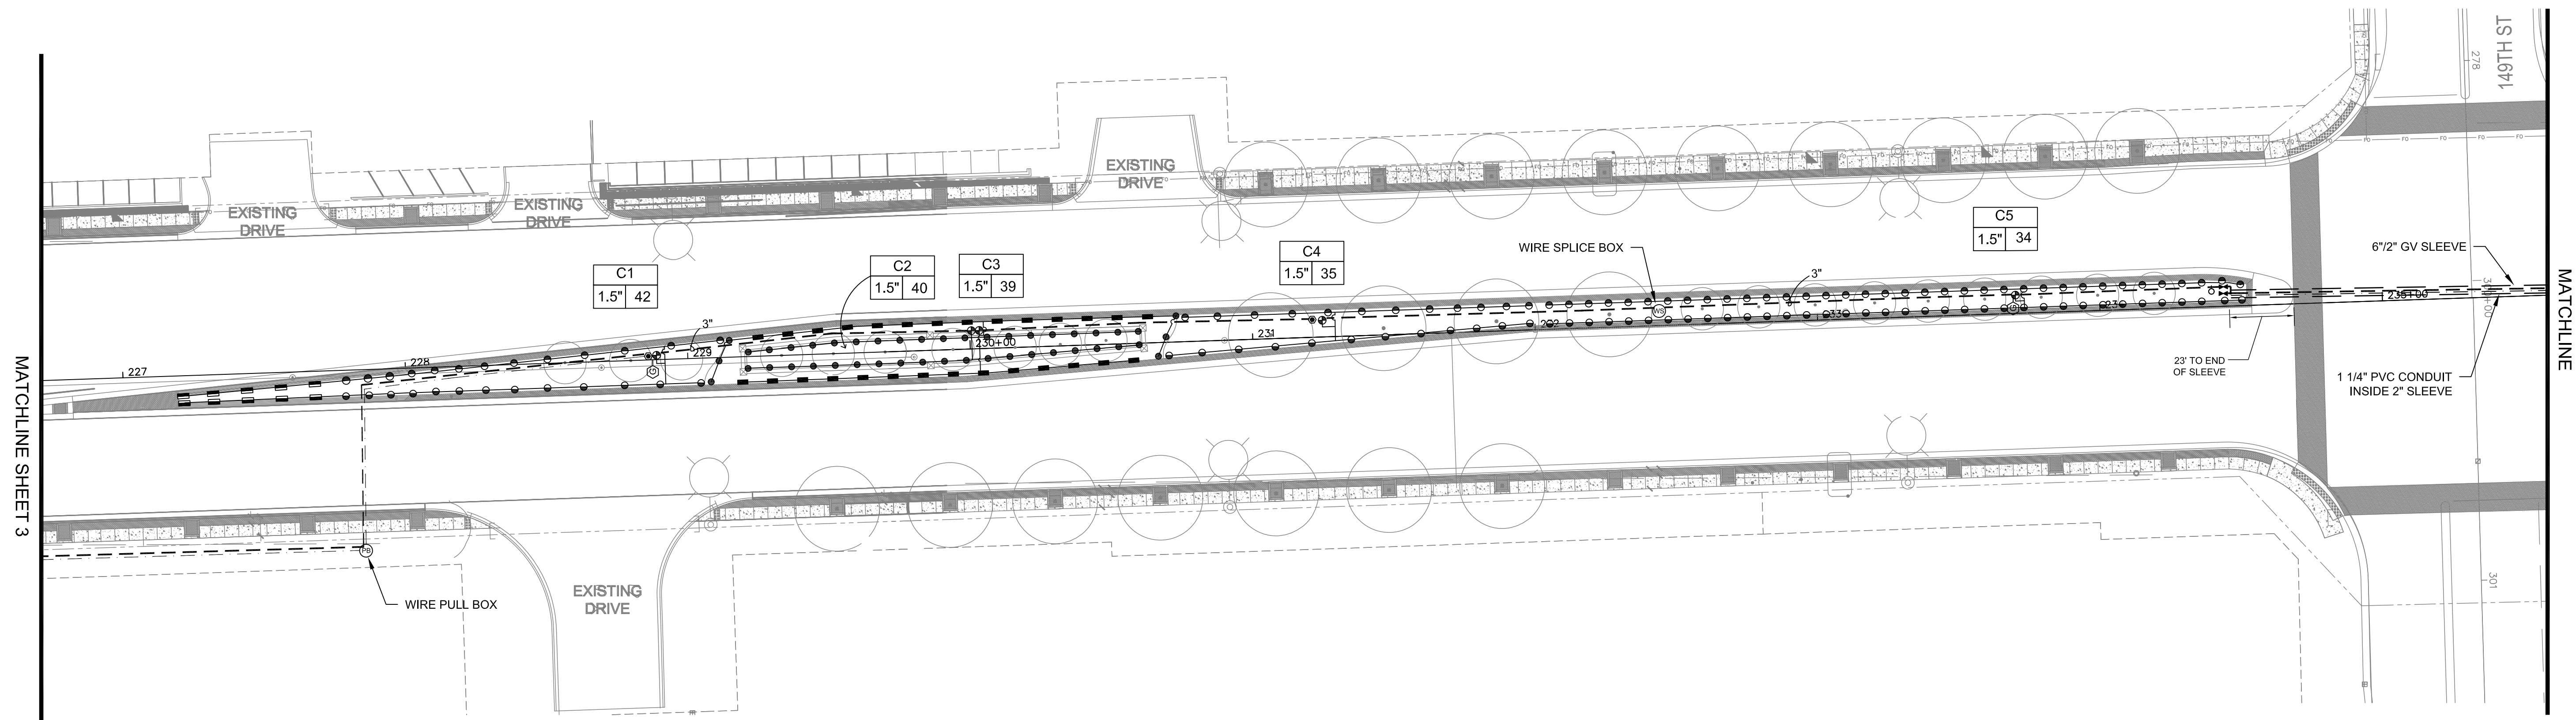

LEGEND

- HUNTER 4" SPRAY HEAD, 8' - 17' RADIUS
- HUNTER 12" SPRAY HEAD, 8' - 17' RADIUS
- ▬ HUNTER 4" SPRAY HEAD 15' STRIP
- ▬ HUNTER 12" SPRAY HEAD 15' STRIP
- ⊕ HUNTER ICV 1.5" ELECTRIC VALVE
- ⊕ HUNTER ICV 1" ELECTRIC VALVE
- ⊕ LEEMCO MANUAL ISOLATION VALVE
- ⊕ HUNTER 1" QUICK COUPLER
- POLY HD LATERAL PIPE
- 3" PVC CL200 SDR21 MAINLINE PIPE
- IRRIGATION SLEEVE
- ⊠ HUNTER ACC-D DECODER CONTROLLER
- ⊠ HUNTER SOLAR SYNC WEATHER SENSOR
- ⊠ IRRIGATION BOOSTER PUMP STATION
- ⊠ B-BOX


**CENTRAL**  
Lawn Sprinklers Inc.

239 King Street • Elk Grove Village, IL 60007 • Phone: (847) 364-6900 • Fax: (847) 364-9774



**LAGRANGE ROAD IMPROVEMENTS**  
**ORLAND PARK, ILLINOIS**  
Segment 2 - 159th St to 143rd St  
**IRRIGATION AS-BUILT**

PROJECT NO.	15780
DESIGNED BY:	KM
DRAWN BY:	KM
CHECKED BY:	JC
DATE:	OCT 31, 2017
SCALE:	1" = 30'
SHEET	4



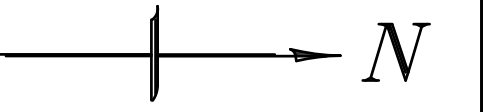

SCALE: 1"=30'-0"

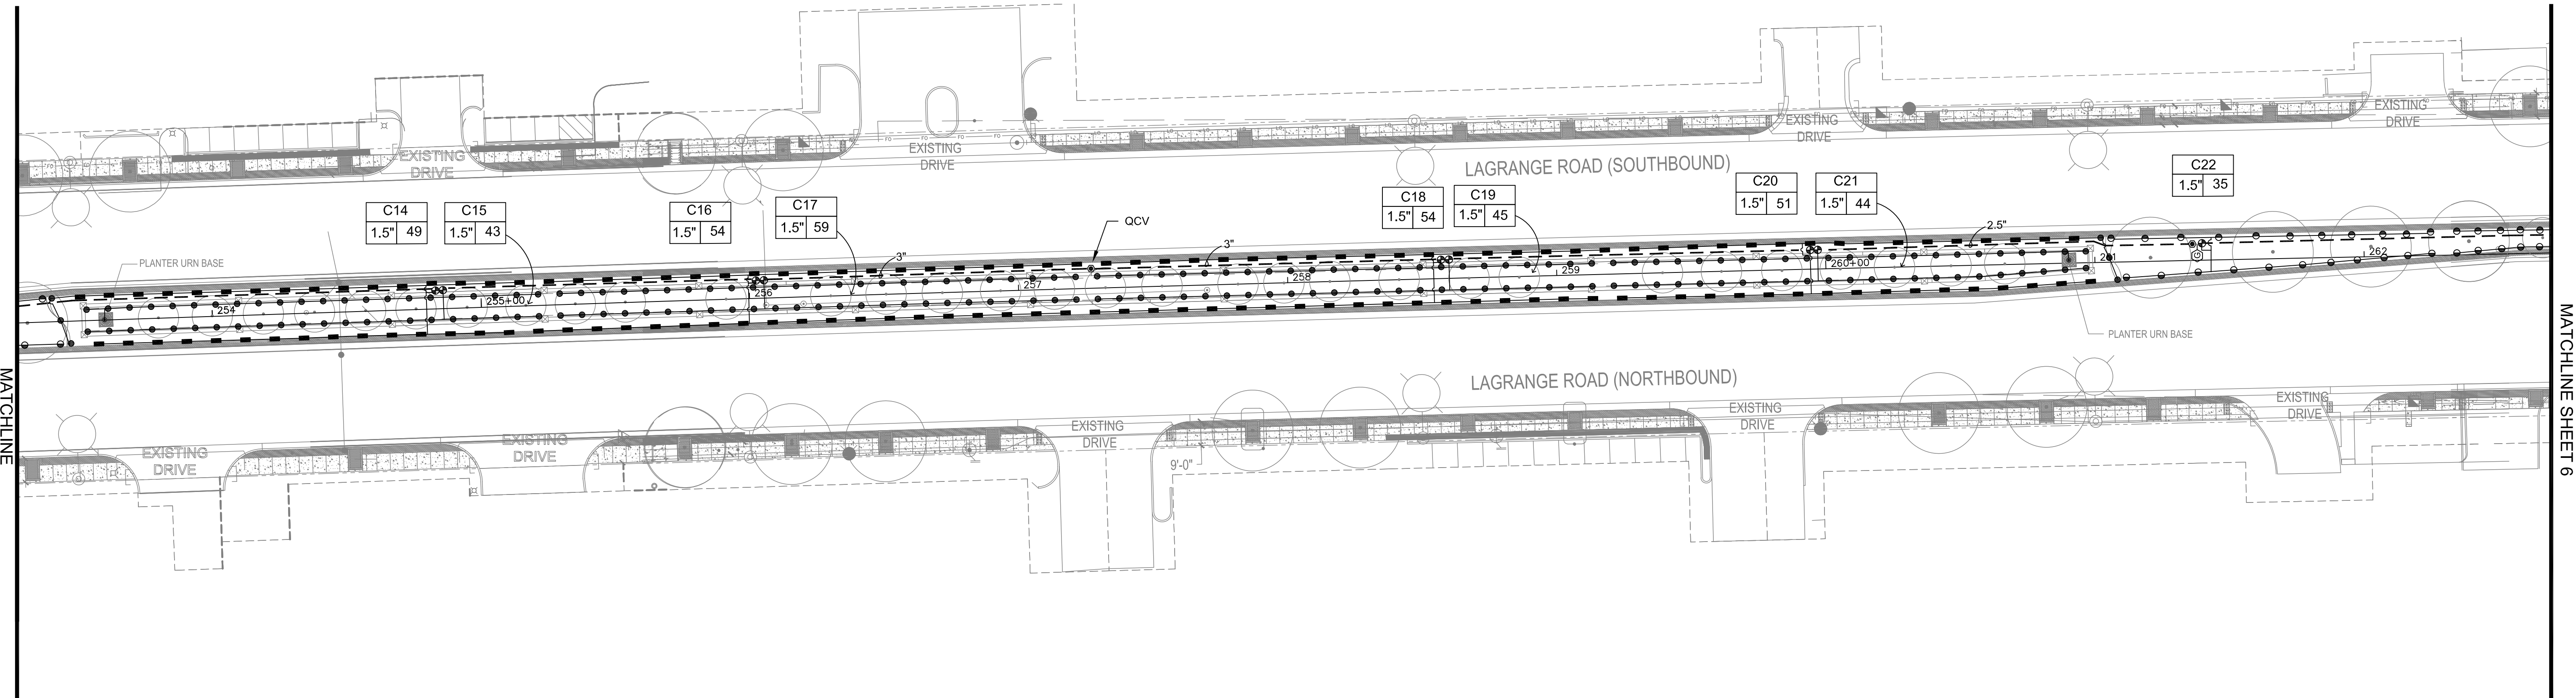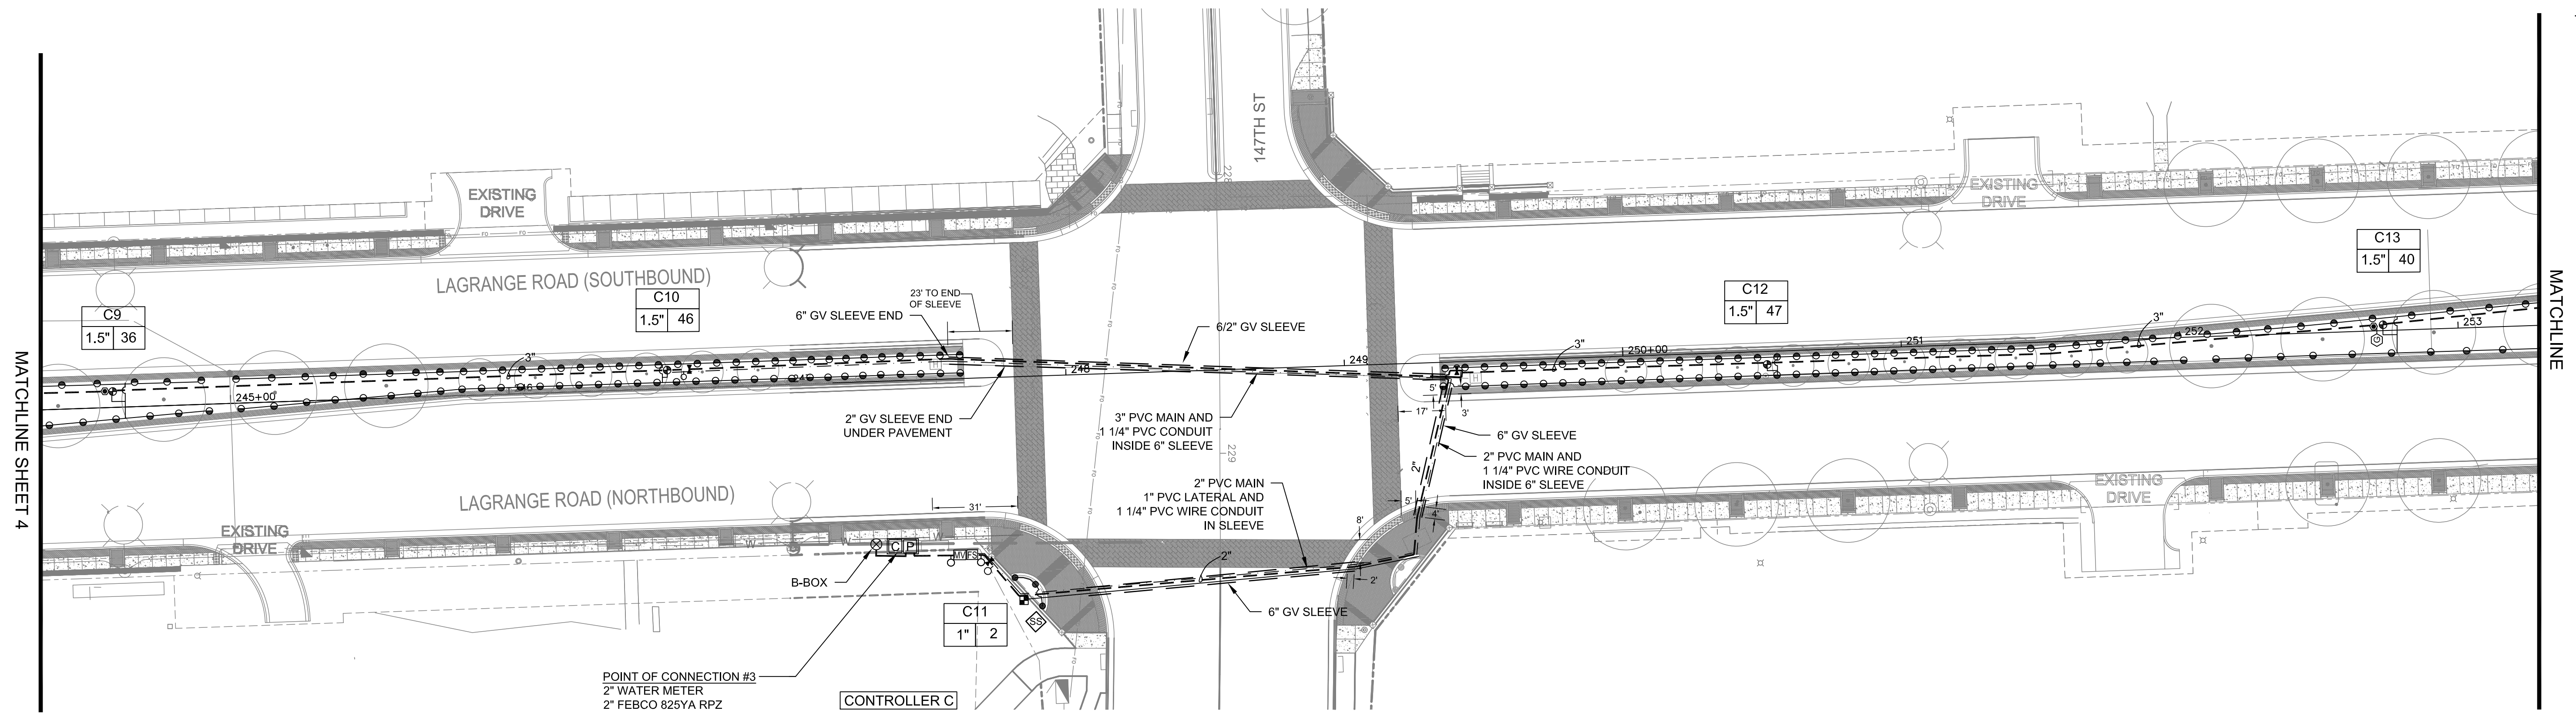

**LEGEND**


● HUNTER 4" SPRAY HEAD, 8' - 17' RADIUS	— POLY HD LATERAL PIPE
● HUNTER 12" SPRAY HEAD, 8' - 17' RADIUS	— 3" PVC CL200 SDR21 MAINLINE PIPE
▬ HUNTER 4" SPRAY HEAD 15' STRIP	— IRRIGATION SLEEVE
▬ HUNTER 12" SPRAY HEAD 15' STRIP	□ HUNTER ACC-D DECODER CONTROLLER
⊕ HUNTER ICV 1.5" ELECTRIC VALVE	⊕ HUNTER SOLAR SYNC WEATHER SENSOR
⊕ HUNTER ICV 1" ELECTRIC VALVE	□ IRRIGATION BOOSTER PUMP STATION
▶ LEEMCO MANUAL ISOLATION VALVE	⊗ B-BOX
⊕ HUNTER 1" QUICK COUPLER	

**CENTRAL**  
Lawn Sprinklers Inc.

239 King Street • Elk Grove Village, IL 60007 • Phone: (847) 364-6900 • Fax: (847) 364-9774

**LAGRANGE ROAD IMPROVEMENTS**  
**ORLAND PARK, ILLINOIS**  
Segment 2 - 159th St to 143rd St  
**IRRIGATION AS-BUILT**

PROJECT NO.	15780
DESIGNED BY:	KM
DRAWN BY:	KM
CHECKED BY:	JC
DATE:	OCT 31, 2017
SCALE:	1" = 30'
SHEET	5

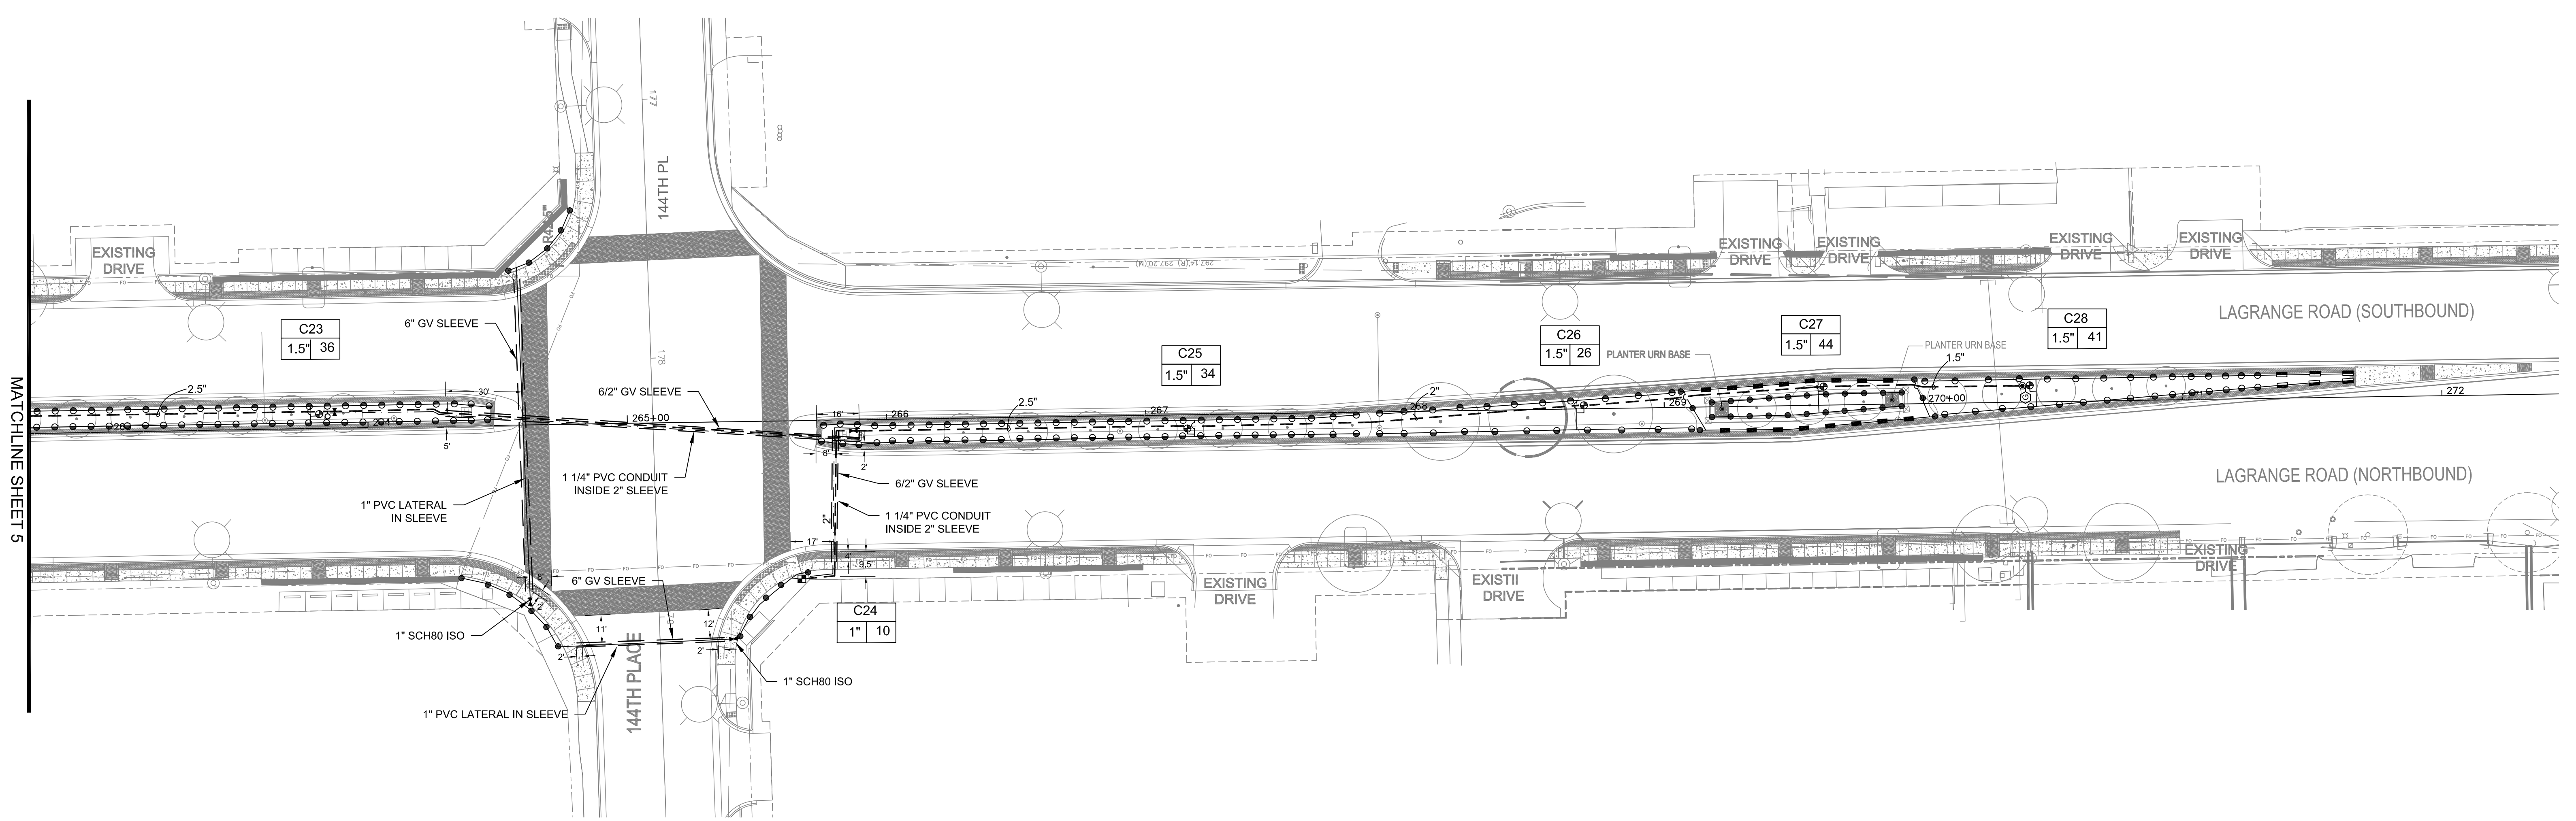

MATCHLINE SHEET 5

**LEGEND**

● HUNTER 4" SPRAY HEAD, 8' - 17' RADIUS	— POLY HD LATERAL PIPE
● HUNTER 12" SPRAY HEAD, 8' - 17' RADIUS	— 3" PVC CL200 SDR21 MAINLINE PIPE
— HUNTER 4" SPRAY HEAD 15' STRIP	— IRRIGATION SLEEVE
— HUNTER 12" SPRAY HEAD 15' STRIP	□ HUNTER ACC-D DECODER CONTROLLER
⊕ HUNTER ICV 1.5" ELECTRIC VALVE	⊕ HUNTER SOLAR SYNC WEATHER SENSOR
⊕ HUNTER ICV 1" ELECTRIC VALVE	□ IRRIGATION BOOSTER PUMP STATION
⊕ LEEMCO MANUAL ISOLATION VALVE	⊗ B-BOX
⊕ HUNTER 1" QUICK COUPLER	

# CENTRAL

*Lawn Sprinklers Inc.*

239 King Street • Elk Grove Village, IL 60007 • Phone: (847) 364-6900 • Fax: (847) 364-9774

## LAGRANGE ROAD IMPROVEMENTS

### ORLAND PARK, ILLINOIS

Segment 2 - 159th St to 143rd St

#### IRRIGATION AS-BUILT

PROJECT NO.	15780
DESIGNED BY:	KM
DRAWN BY:	KM
CHECKED BY:	JC
DATE:	OCT 31, 2017
SCALE:	1" = 30'
SHEET	6