


BOARD APPROVED

CASE NO. 2008-0689

11-3-08

CONDITIONS ✓

CONDITIONS

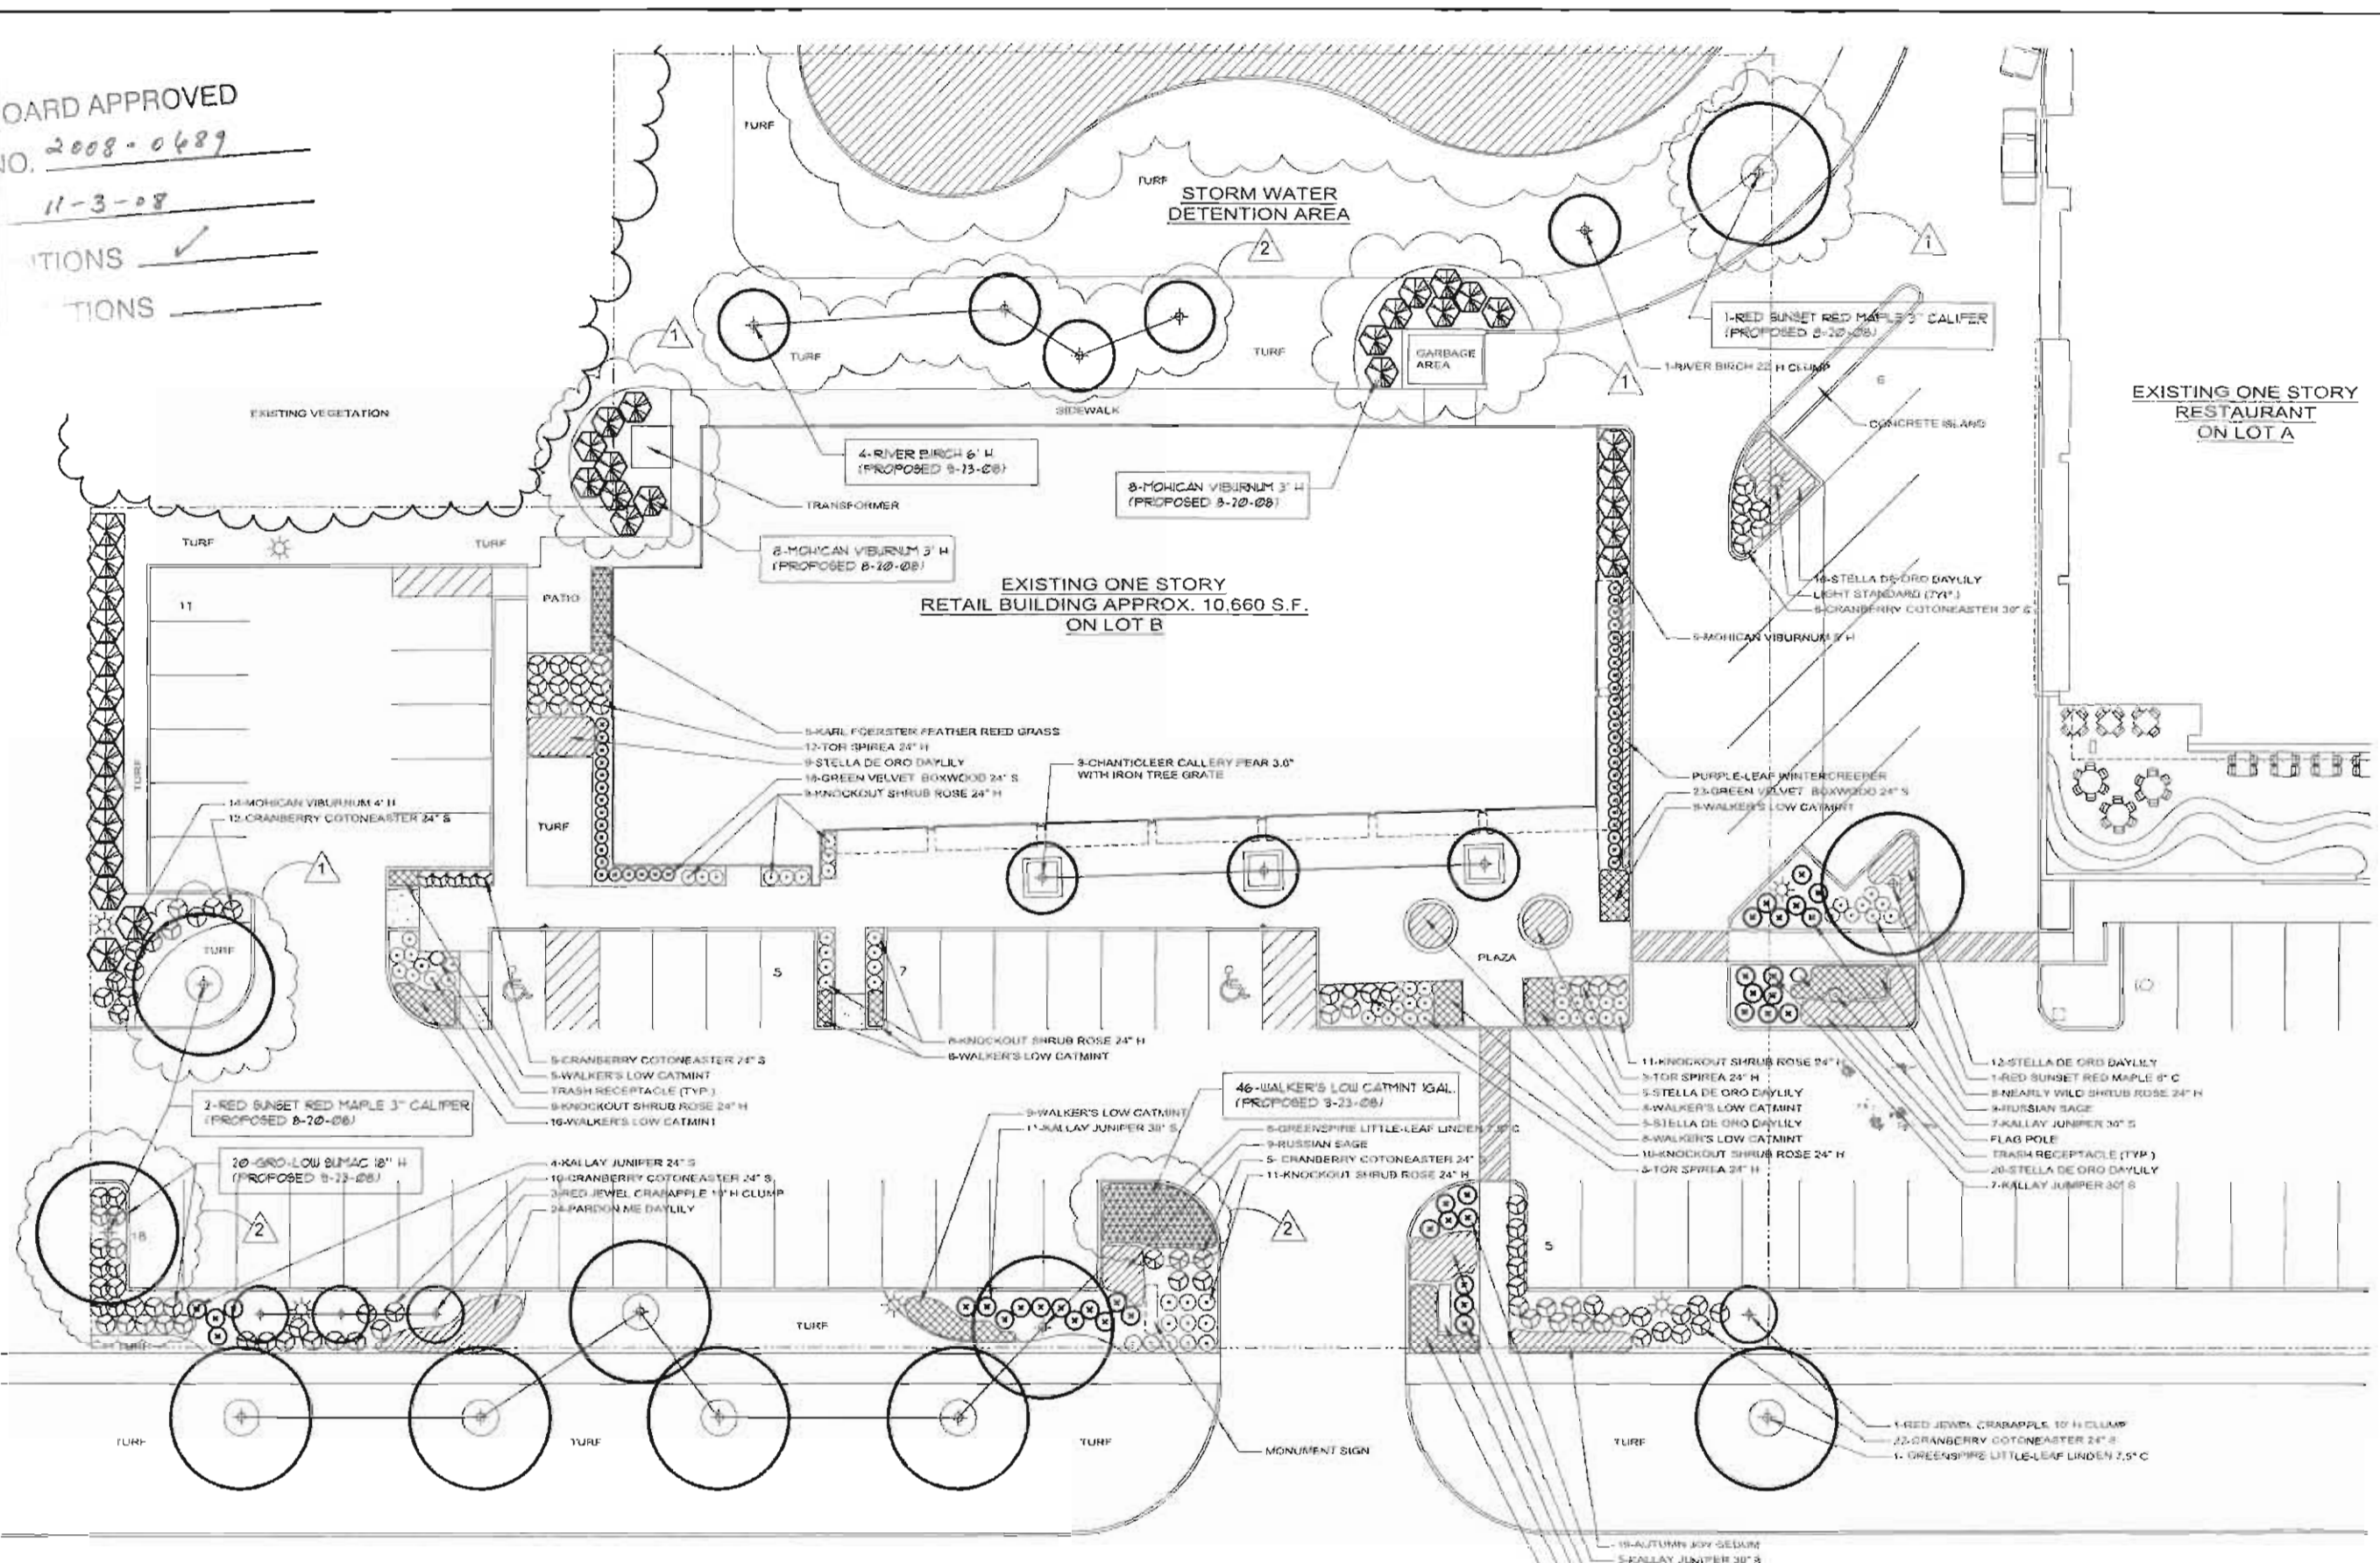

LANDSCAPE DEVELOPMENT PLAN - "AS-BUILT" CONDITIONS  
SCALE: 1"=10'-0"

159 TH STREET

<p>CLIENT: JEK DEVELOPMENT 222 S. WILSON ST. SUITE 100 SPRINGFIELD, IL 62761</p>	<p>DESIGNER: trippedi design, p.c. LANDSCAPE ARCHITECTURE 800 S. NEWPORT AVE. AURORA, ILLINOIS 60009 630-213-8500 FAX 630-319-8400</p>	<p>STATUS: VILLAGE REVIEW SUBMITTAL DATE: 8-20-2008 REVISED: 8-23-2008</p>	<p>PROJECT: LANDSCAPE DEVELOPMENT PLAN - "AS-BUILT" CONDITIONS</p>	<p>PROJECT NAME: NEW PATIO RETAIL CENTER 7850 WEST 159TH STREET ORLAND PARK, ILLINOIS</p>	<p>DATE: 8/23/08 DRAWN BY: [Name] CHECKED BY: [Name] SCALE: 1"=10'-0" SHEET NO.: L1</p>
--	--	--	--	---	---