
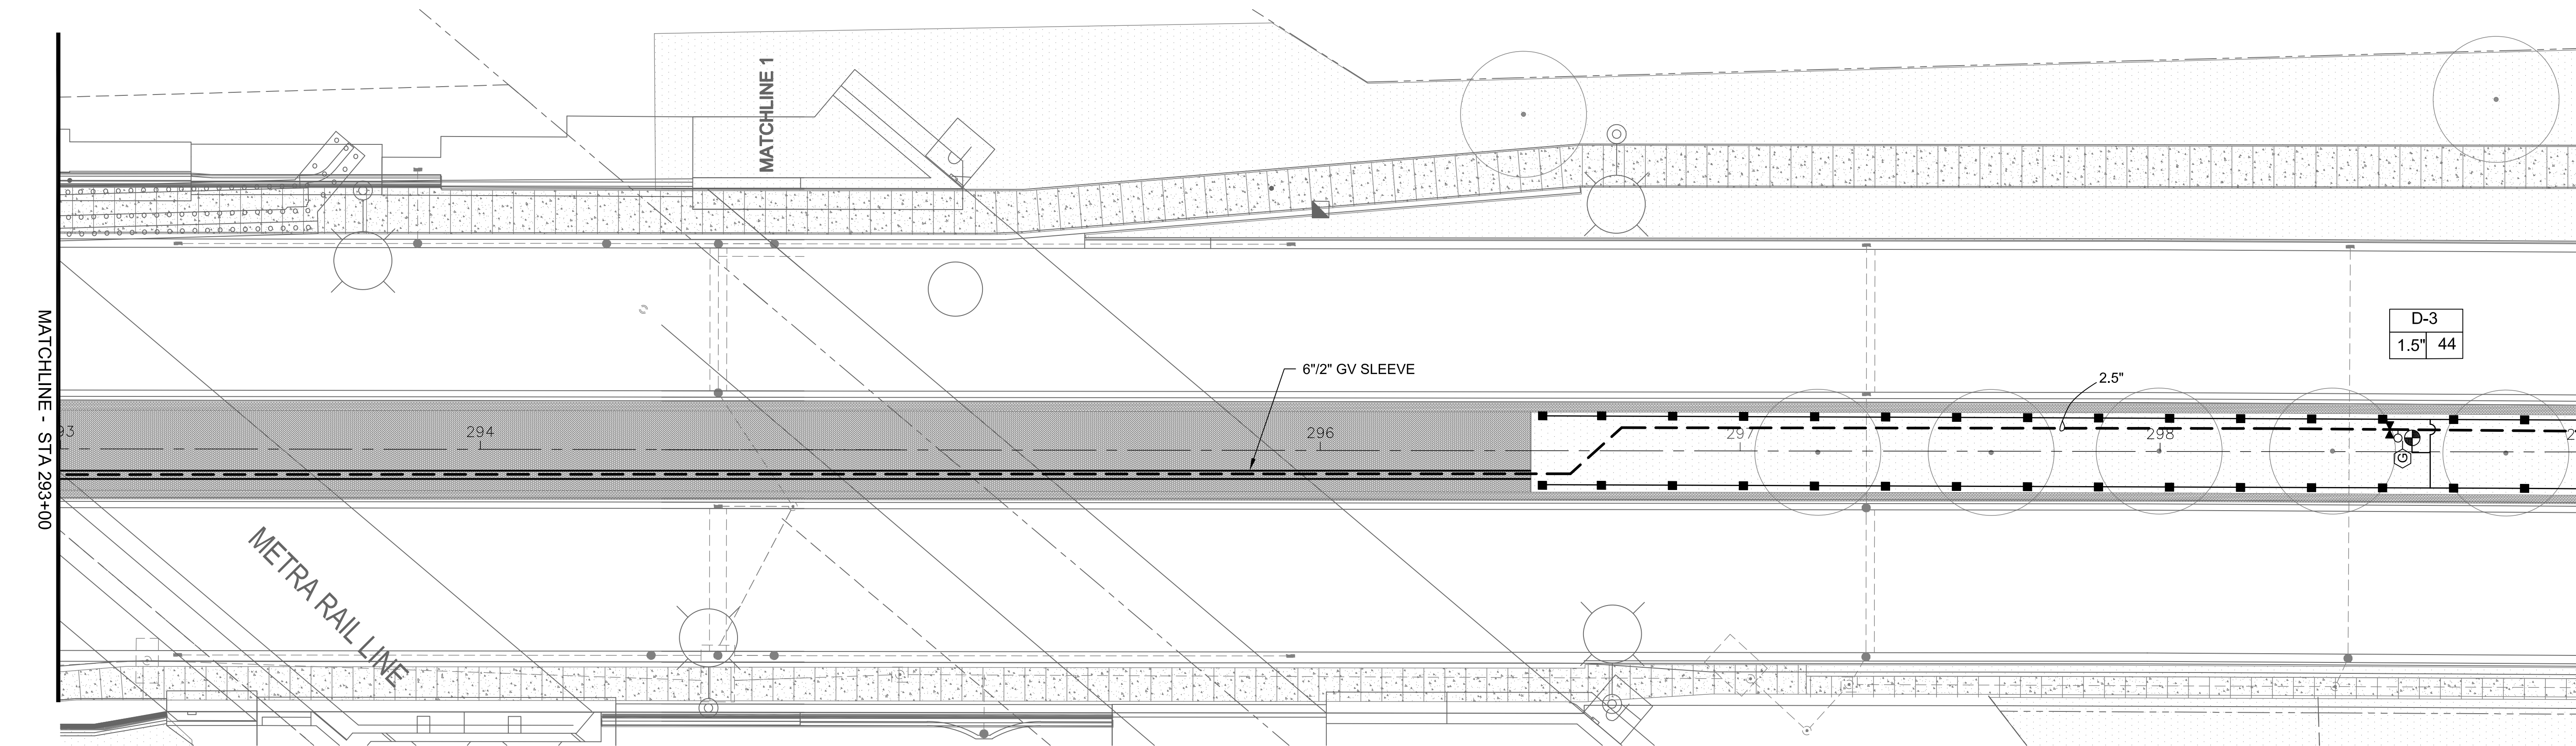
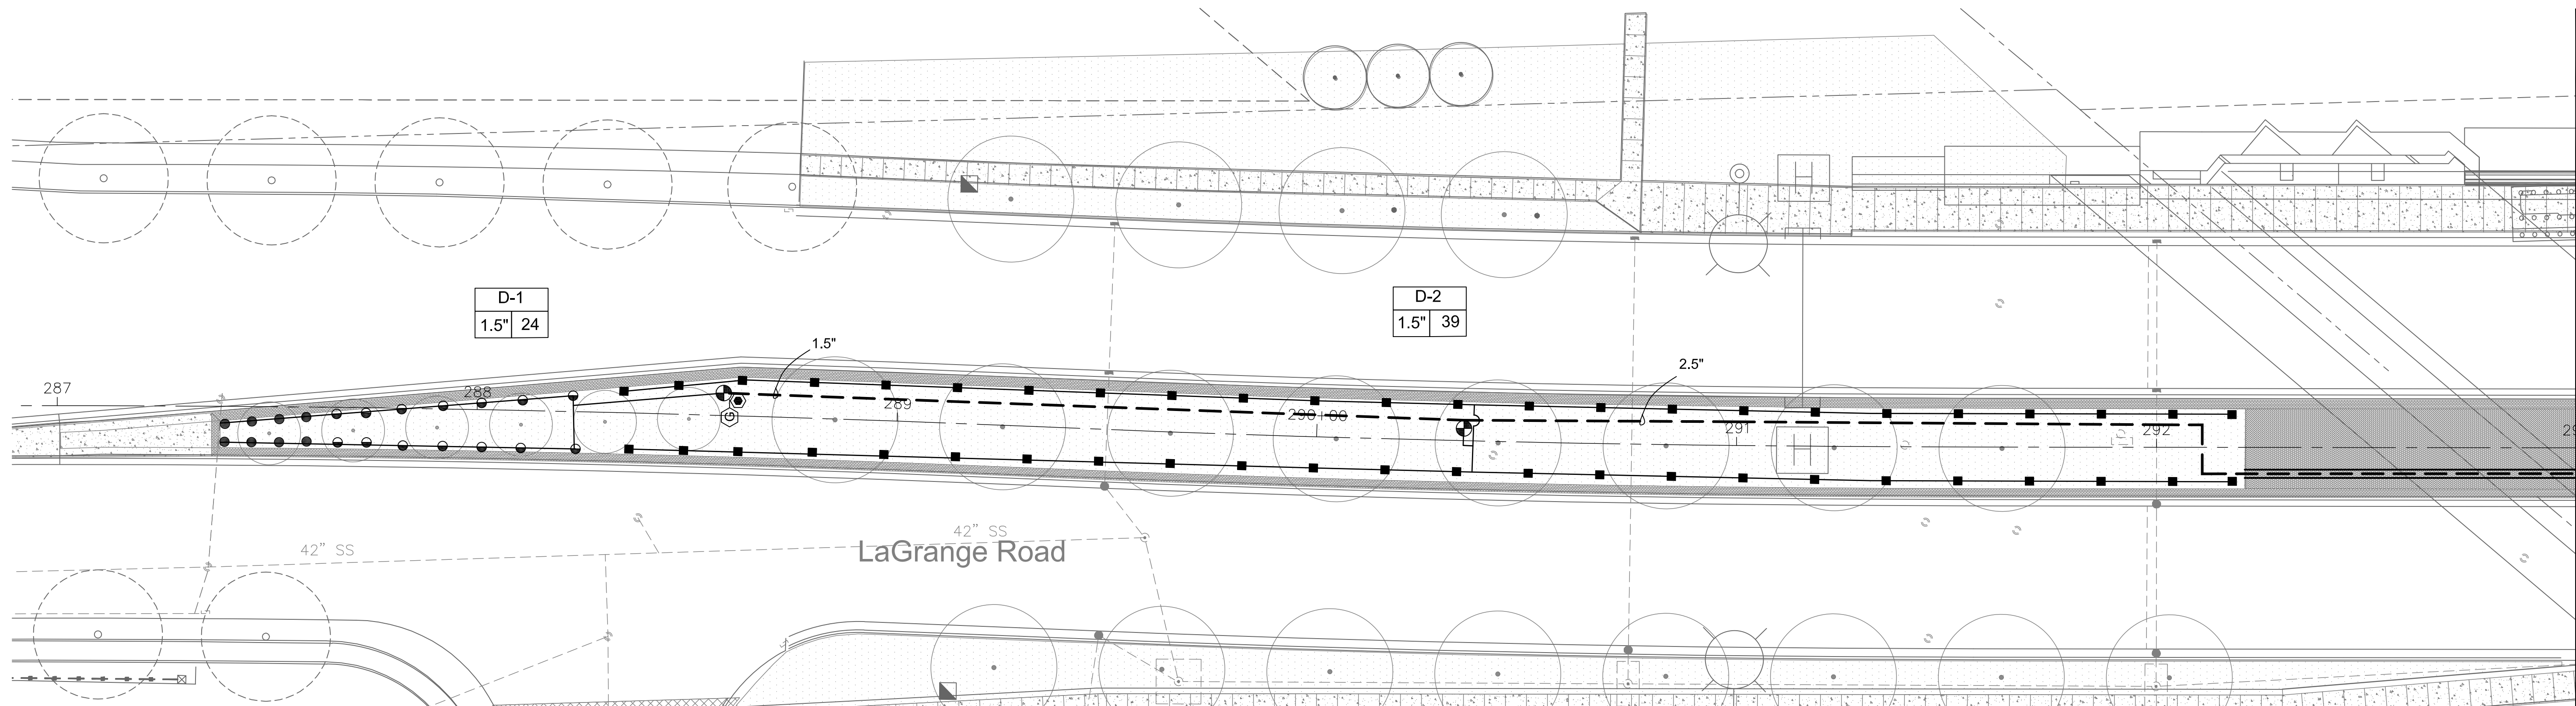


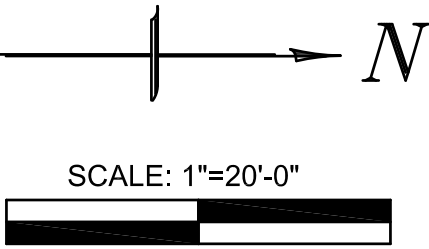

LEGEND



- | | | |
|---|------------------------------------|--------------------------------|
| ○ HUNTER 4" PRS30 SPRAY HEAD 5H | ▶ LEEMCO MANUAL ISOLATION VALVE | BOOSTER PUMP STATION |
| ● HUNTER 4" PRS30 SPRAY HEAD 8H | ● HUNTER LRC 1" QUICK COUPLER | FEBCO 825YA BACKFLOW PREVENTER |
| ● HUNTER 4" PRS30 SPRAY HEAD 10H-12H | — LATERAL PIPE | WATER METER (PROVIDED BY CITY) |
| ▬ HUNTER 4" PRS 30 15' STRIP SPRAY HEAD | — 3" PVC CL200 SDR21 MAINLINE PIPE | — BLOW OUT TEE |
| ⊙ HUNTER 12" PRS30 SPRAY | HUNTER ACC-D DECODER CONTROLLER | GROUND ROD |
| ■ HUNTER MP 2000 ROTATOR 4" PRS40 | HUNTER SOLAR SYNC WEATHER SENSOR | |
| ▲ HUNTER MP 1000 ROTATOR 4" PRS40 | FLOW SENSOR | |
| ⊕ HUNTER ICV 1.5" ELECTRIC VALVE | MASTER VALVE | |
| ■ HUNTER ICV 1" ELECTRIC VALVE | | |

CENTRAL
Lawn Sprinklers Inc.

239 King Street • Elk Grove Village, IL 60007 • Phone: (847) 364-6900 • Fax: (847) 364-9774

LAGRANGE ROAD IMPROVEMENTS
ORLAND PARK, ILLINOIS
Segment 3 - 143rd St to 131st St
IRRIGATION AS-BUILT DRAWING

PROJECT NO.	15780
DESIGNED BY:	KM
DRAWN BY:	KM
CHECKED BY:	JC
DATE:	OCT 25, 2017
SCALE:	1" = 20'
SHEET	1

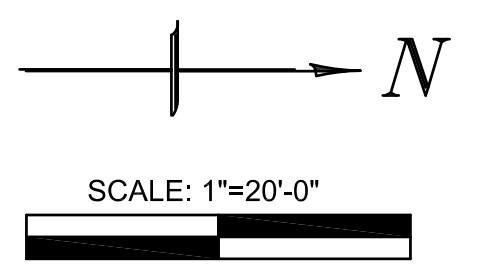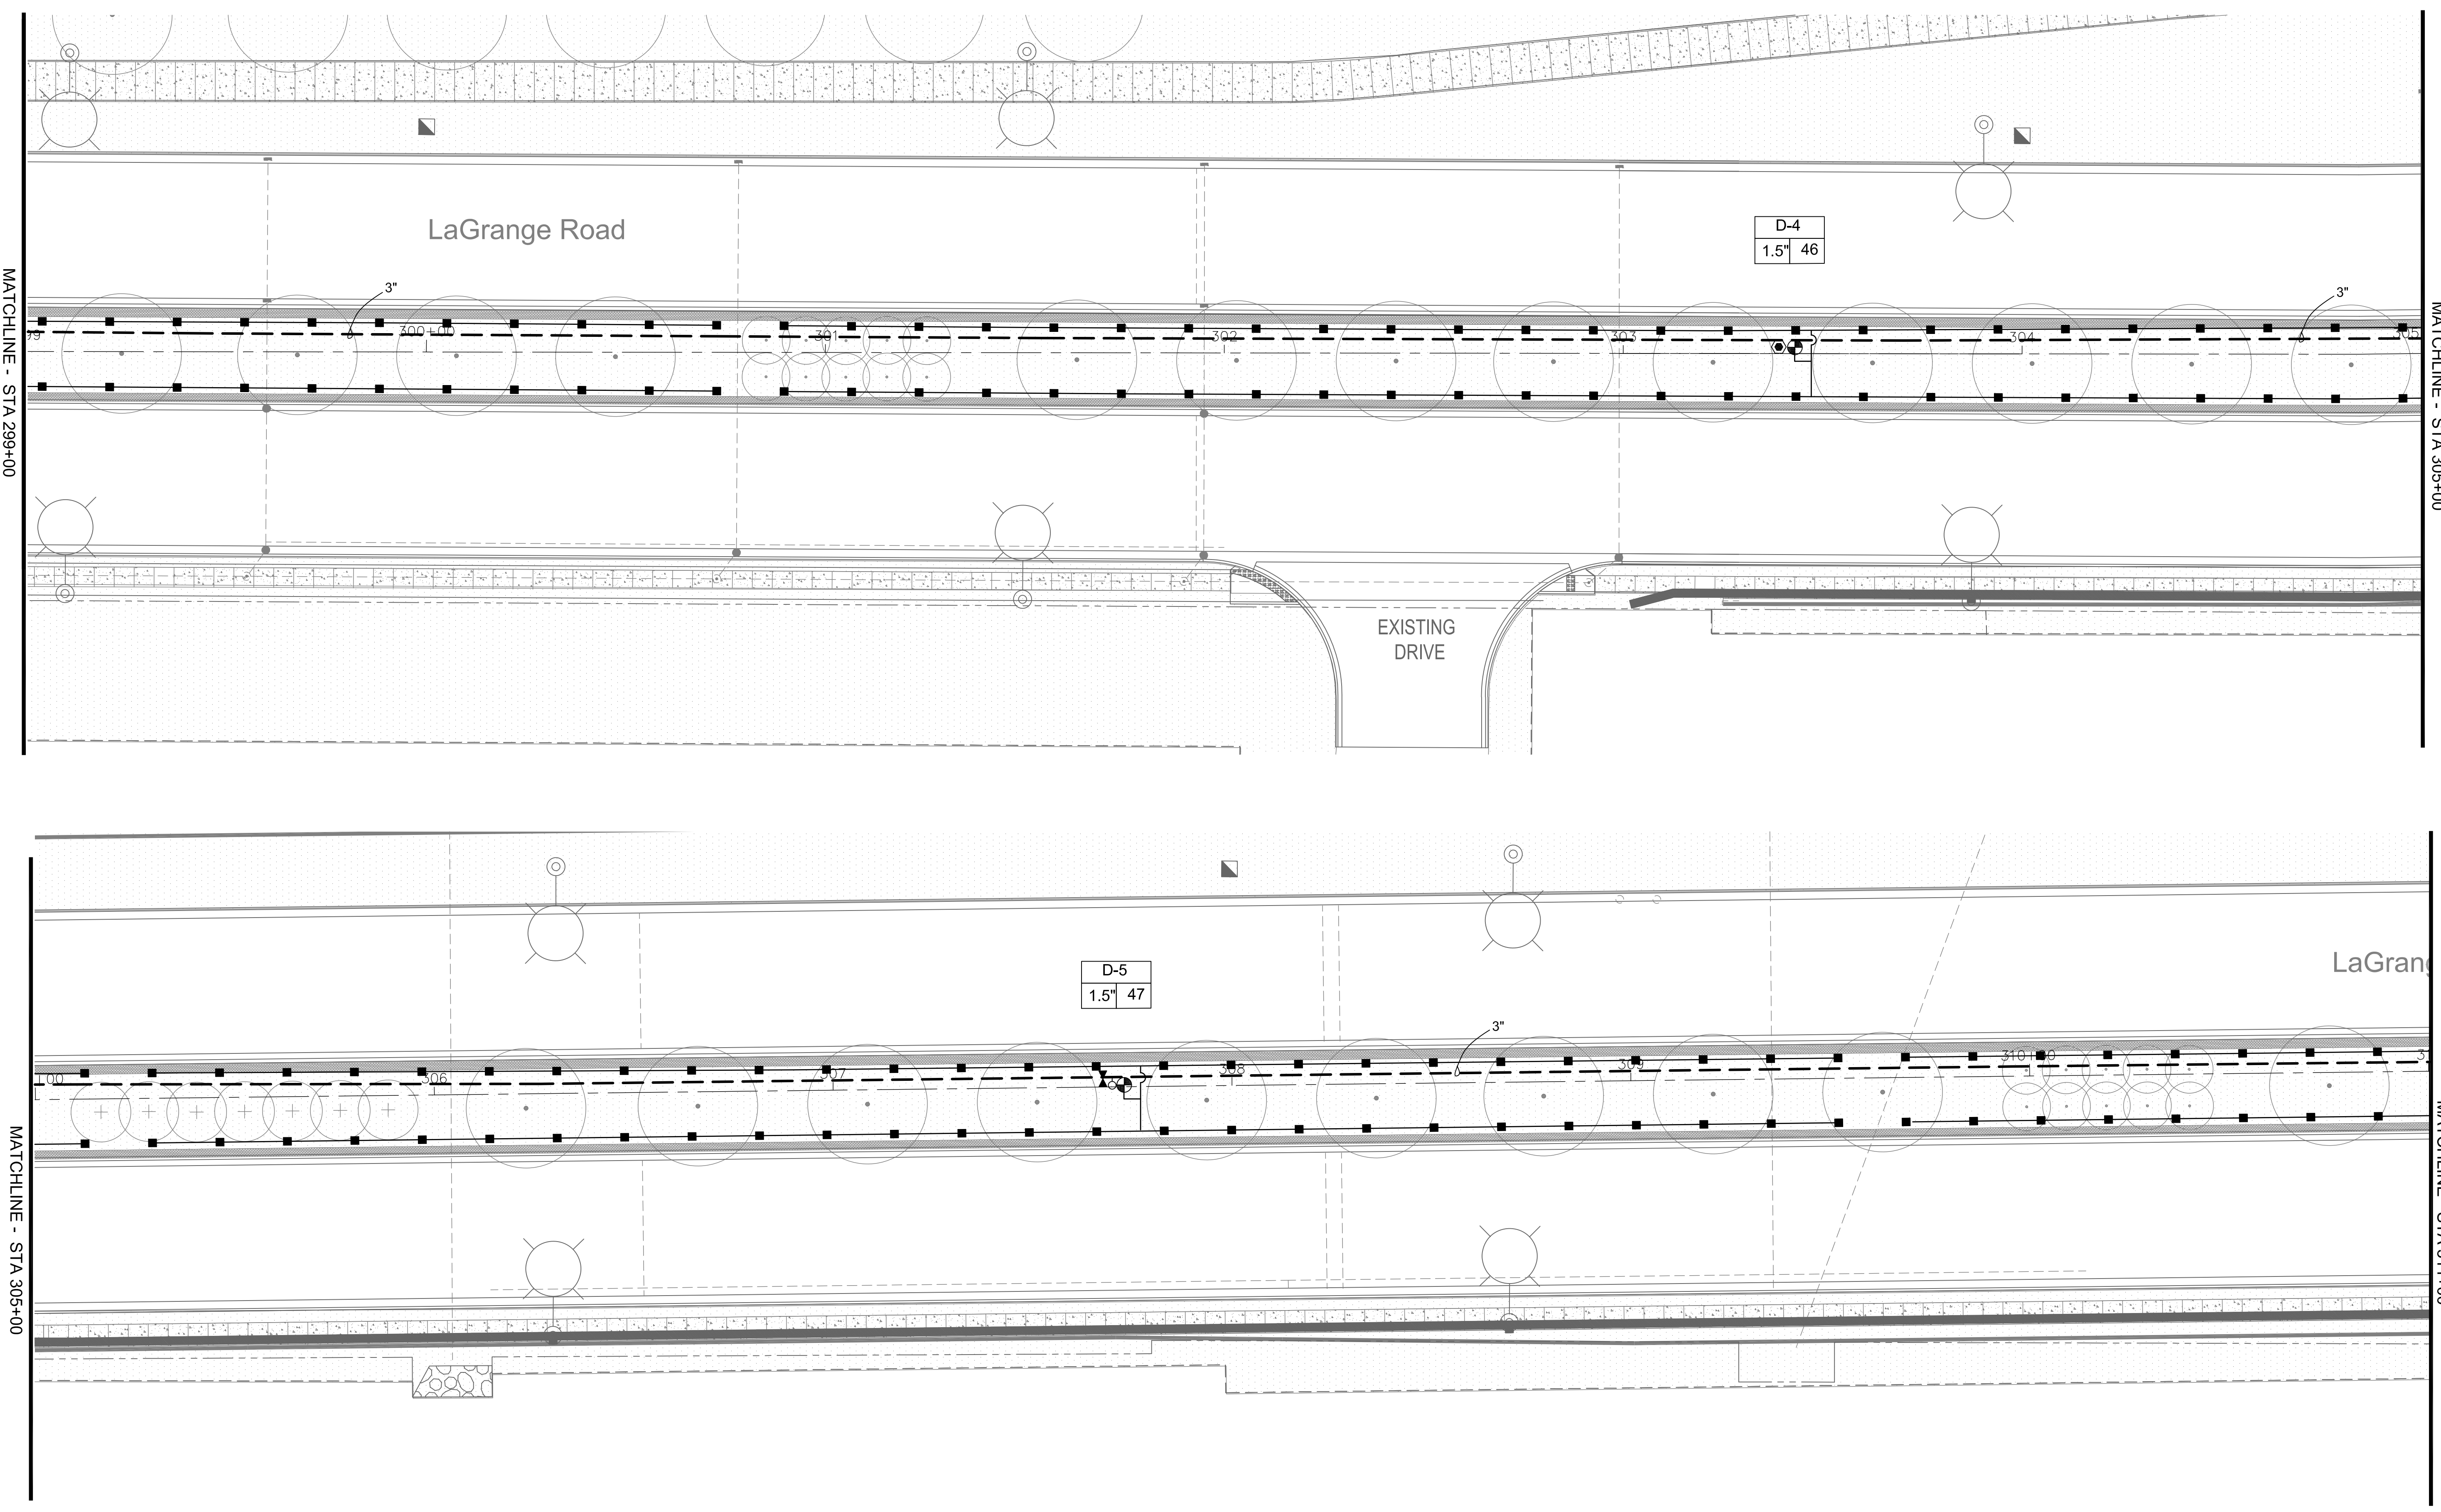




LEGEND			
○ HUNTER 4" PRS30 SPRAY HEAD 5H	◀ LEEMCO MANUAL ISOLATION VALVE	Ⓟ BOOSTER PUMP STATION	
● HUNTER 4" PRS30 SPRAY HEAD 8H	⦿ HUNTER LRC 1" QUICK COUPLER	Ⓡ FEBCO 825YA BACKFLOW PREVENTER	
⦿ HUNTER 4" PRS30 SPRAY HEAD 10H-12H	— LATERAL PIPE	Ⓜ WATER METER (PROVIDED BY CITY)	
▬ HUNTER 4" PRS 30 15' STRIP SPRAY HEAD	— 3" PVC CL200 SDR21 MAINLINE PIPE	○ BLOW OUT TEE	
⦿ HUNTER 12" PRS30 SPRAY	Ⓢ HUNTER ACC-D DECODER CONTROLLER	Ⓤ GROUND ROD	
■ HUNTER MP 2000 ROTATOR 4" PRS40	⦿ HUNTER SOLAR SYNC WEATHER SENSOR		
▲ HUNTER MP 1000 ROTATOR 4" PRS40	Ⓡ FLOW SENSOR		
⦿ HUNTER ICV 1.5" ELECTRIC VALVE	Ⓜ MASTER VALVE		
■ HUNTER ICV 1" ELECTRIC VALVE			

CENTRAL

Lawn Sprinklers Inc.

239 King Street • Elk Grove Village, IL 60007 • Phone: (847) 364-6900 • Fax: (847) 364-9774

LAGRANGE ROAD IMPROVEMENTS ORLAND PARK, ILLINOIS Segment 3 - 143rd St to 131st St IRRIGATION AS-BUILT DRAWING	
PROJECT NO.	15780
DESIGNED BY:	KM
DRAWN BY:	KM
CHECKED BY:	JC
DATE:	OCT 25, 2017
SCALE:	1" = 20'
SHEET	2

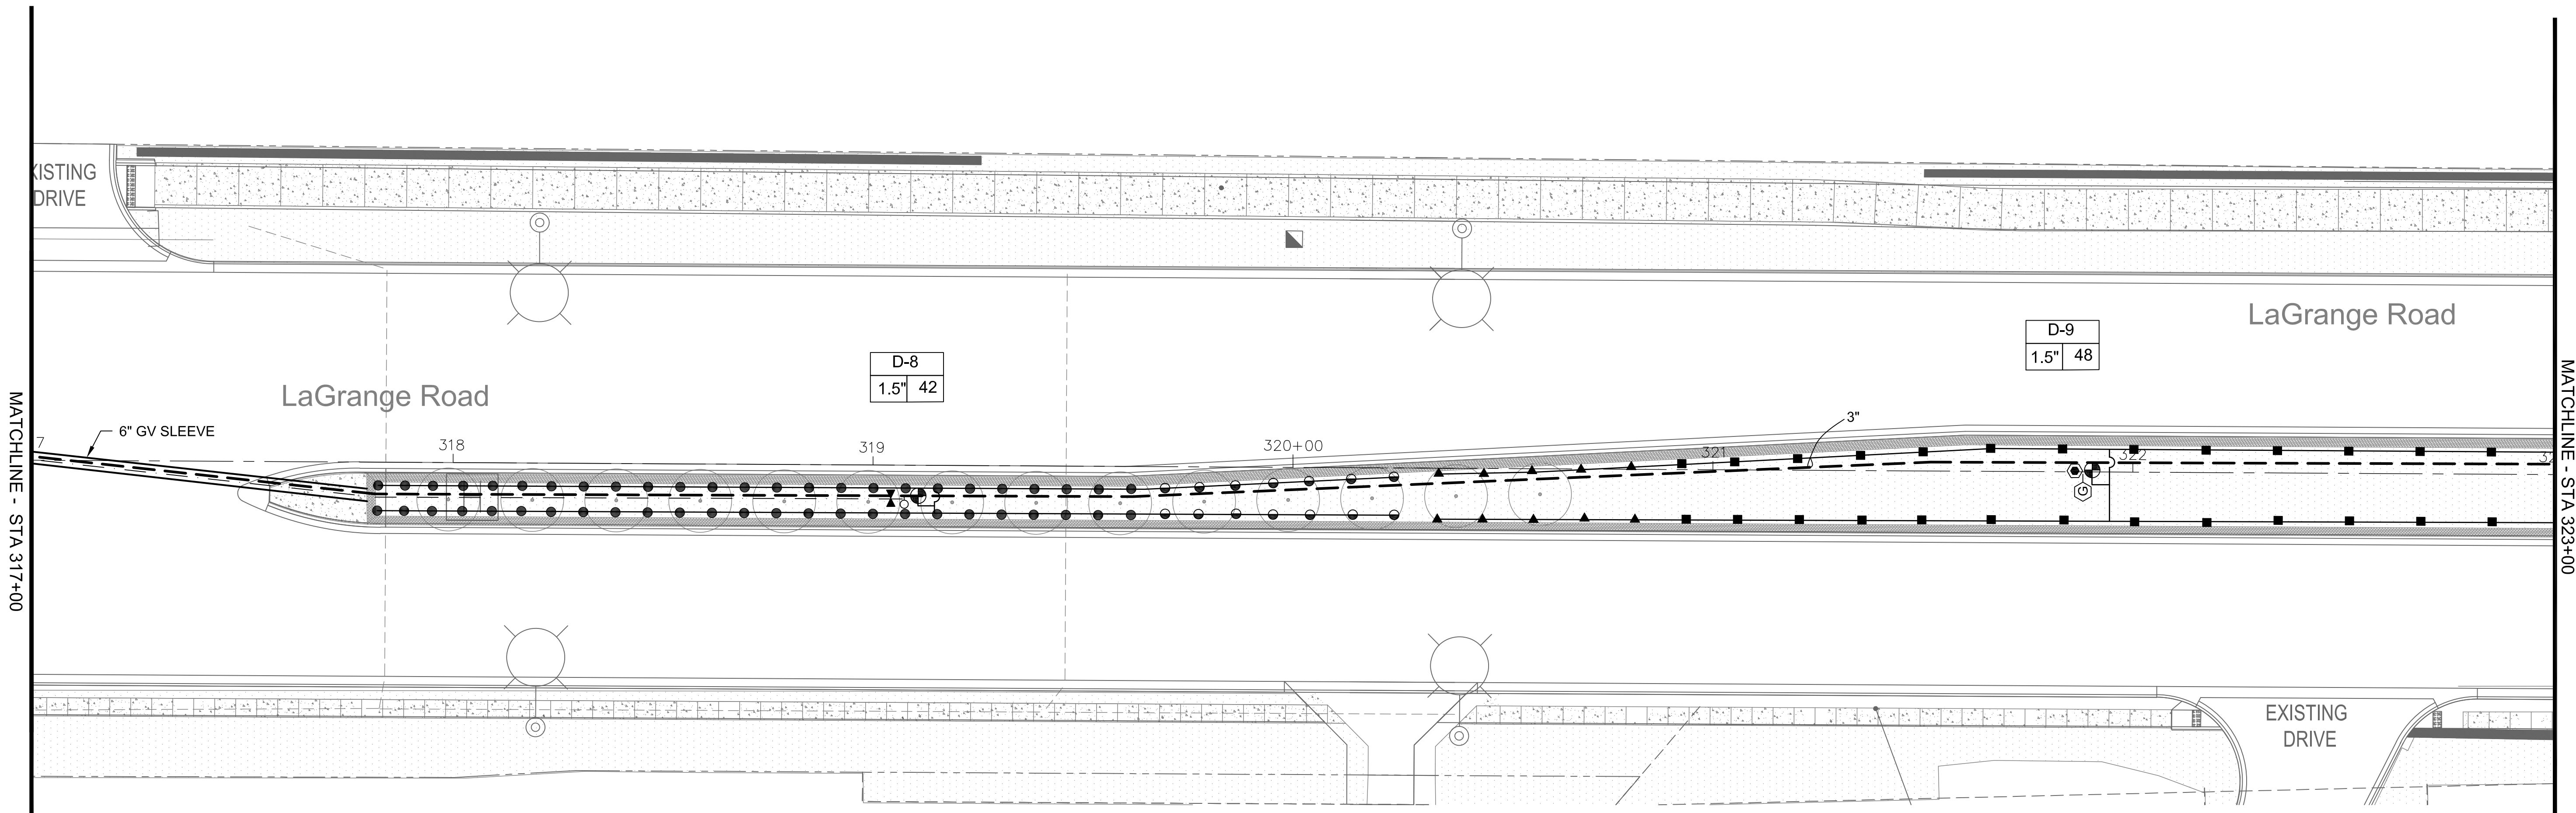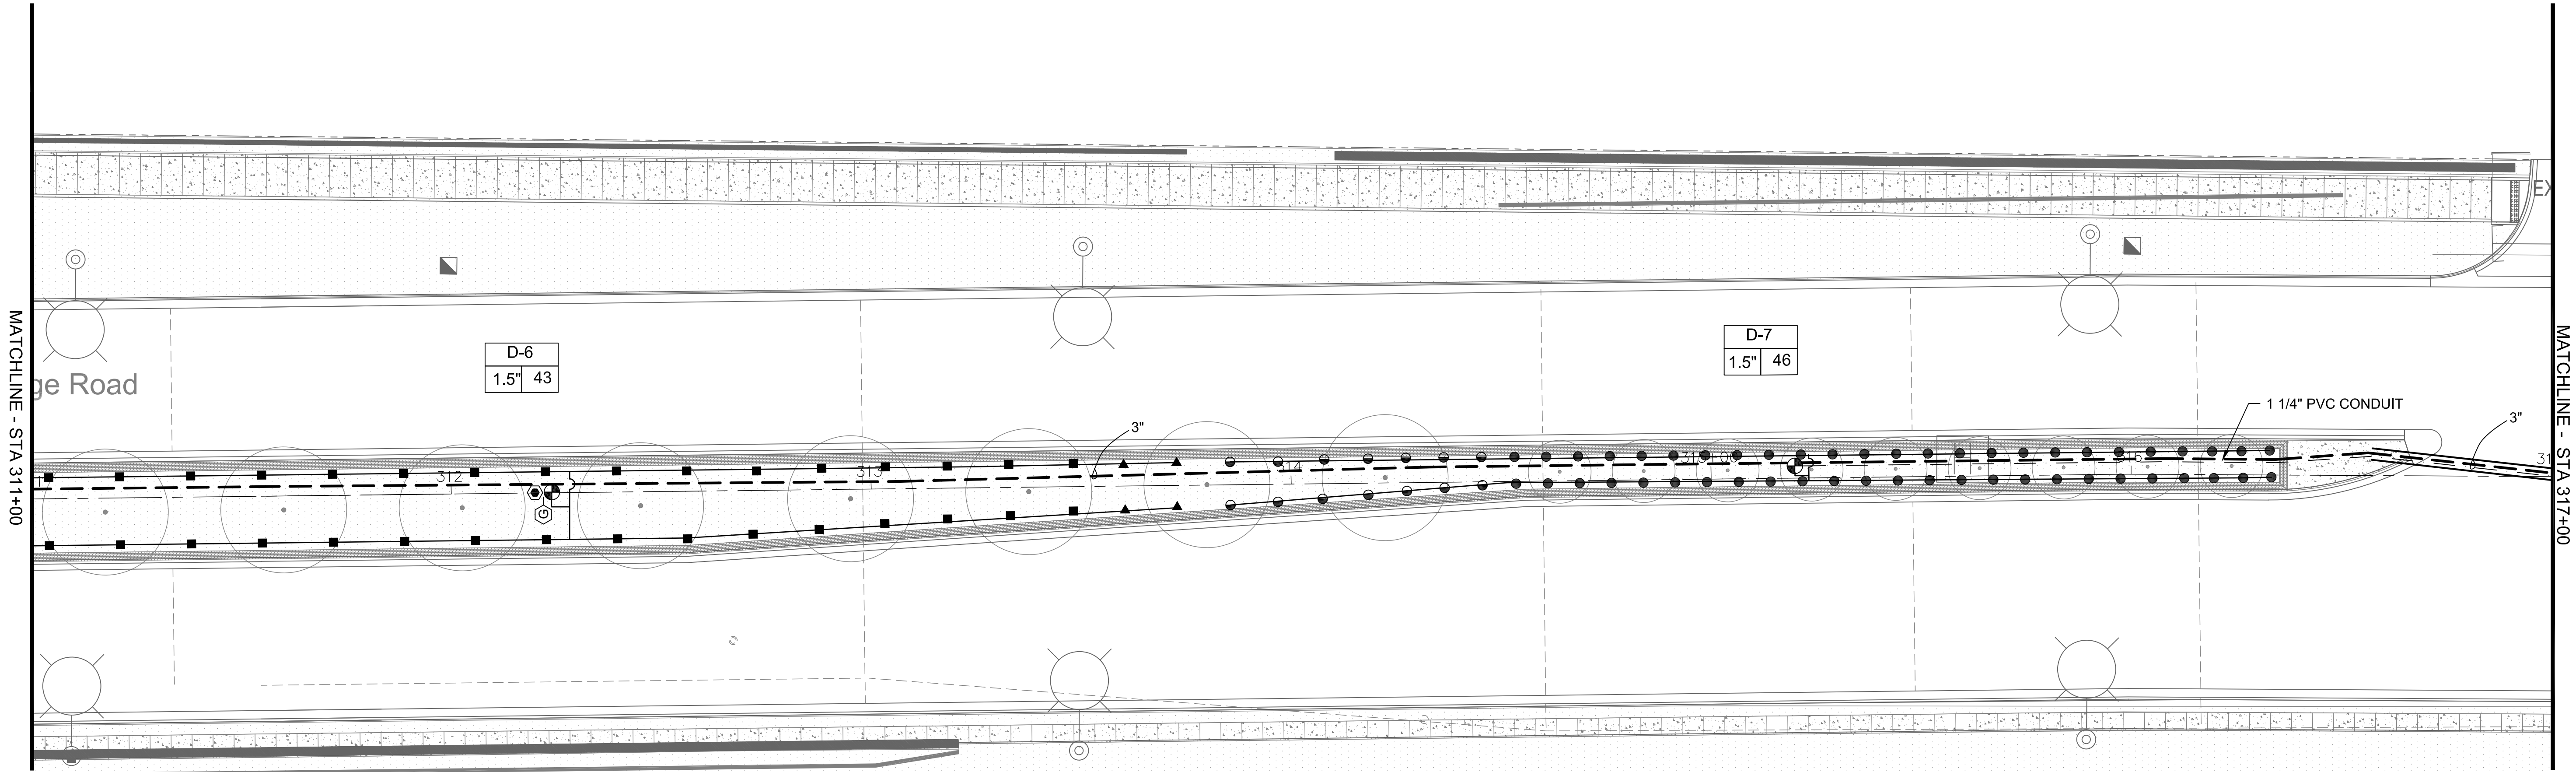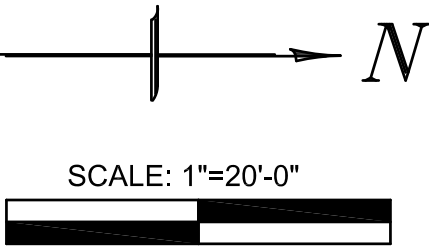

LEGEND			
○ HUNTER 4" PRS30 SPRAY HEAD 5H	▶ LEEMCO MANUAL ISOLATION VALVE	Ⓟ BOOSTER PUMP STATION	
● HUNTER 4" PRS30 SPRAY HEAD 8H	⦿ HUNTER LRC 1" QUICK COUPLER	Ⓢ FEBCO 825YA BACKFLOW PREVENTER	
⦿ HUNTER 4" PRS30 SPRAY HEAD 10H-12H	— LATERAL PIPE	Ⓜ WATER METER (PROVIDED BY CITY)	
— HUNTER 4" PRS 30 15' STRIP SPRAY HEAD	— 3" — PVC CL200 SDR21 MAINLINE PIPE	— BLOW OUT TEE	
⦿ HUNTER 12" PRS30 SPRAY	Ⓢ HUNTER ACC-D DECODER CONTROLLER	Ⓤ GROUND ROD	
■ HUNTER MP 2000 ROTATOR 4" PRS40	⦿ HUNTER SOLAR SYNC WEATHER SENSOR		
▲ HUNTER MP 1000 ROTATOR 4" PRS40	Ⓢ FLOW SENSOR		
⦿ HUNTER ICV 1.5" ELECTRIC VALVE	Ⓜ MASTER VALVE		
■ HUNTER ICV 1" ELECTRIC VALVE			

CENTRAL

Lawn Sprinklers Inc.

239 King Street • Elk Grove Village, IL 60007 • Phone: (847) 364-6900 • Fax: (847) 364-9774


LAGRANGE ROAD IMPROVEMENTS

ORLAND PARK, ILLINOIS

Segment 3 - 143rd St to 131st St

IRRIGATION AS-BUILT DRAWING

PROJECT NO.	15780
DESIGNED BY:	KM
DRAWN BY:	KM
CHECKED BY:	JC
DATE:	OCT 25, 2017
SCALE:	1" = 20'
SHEET	3

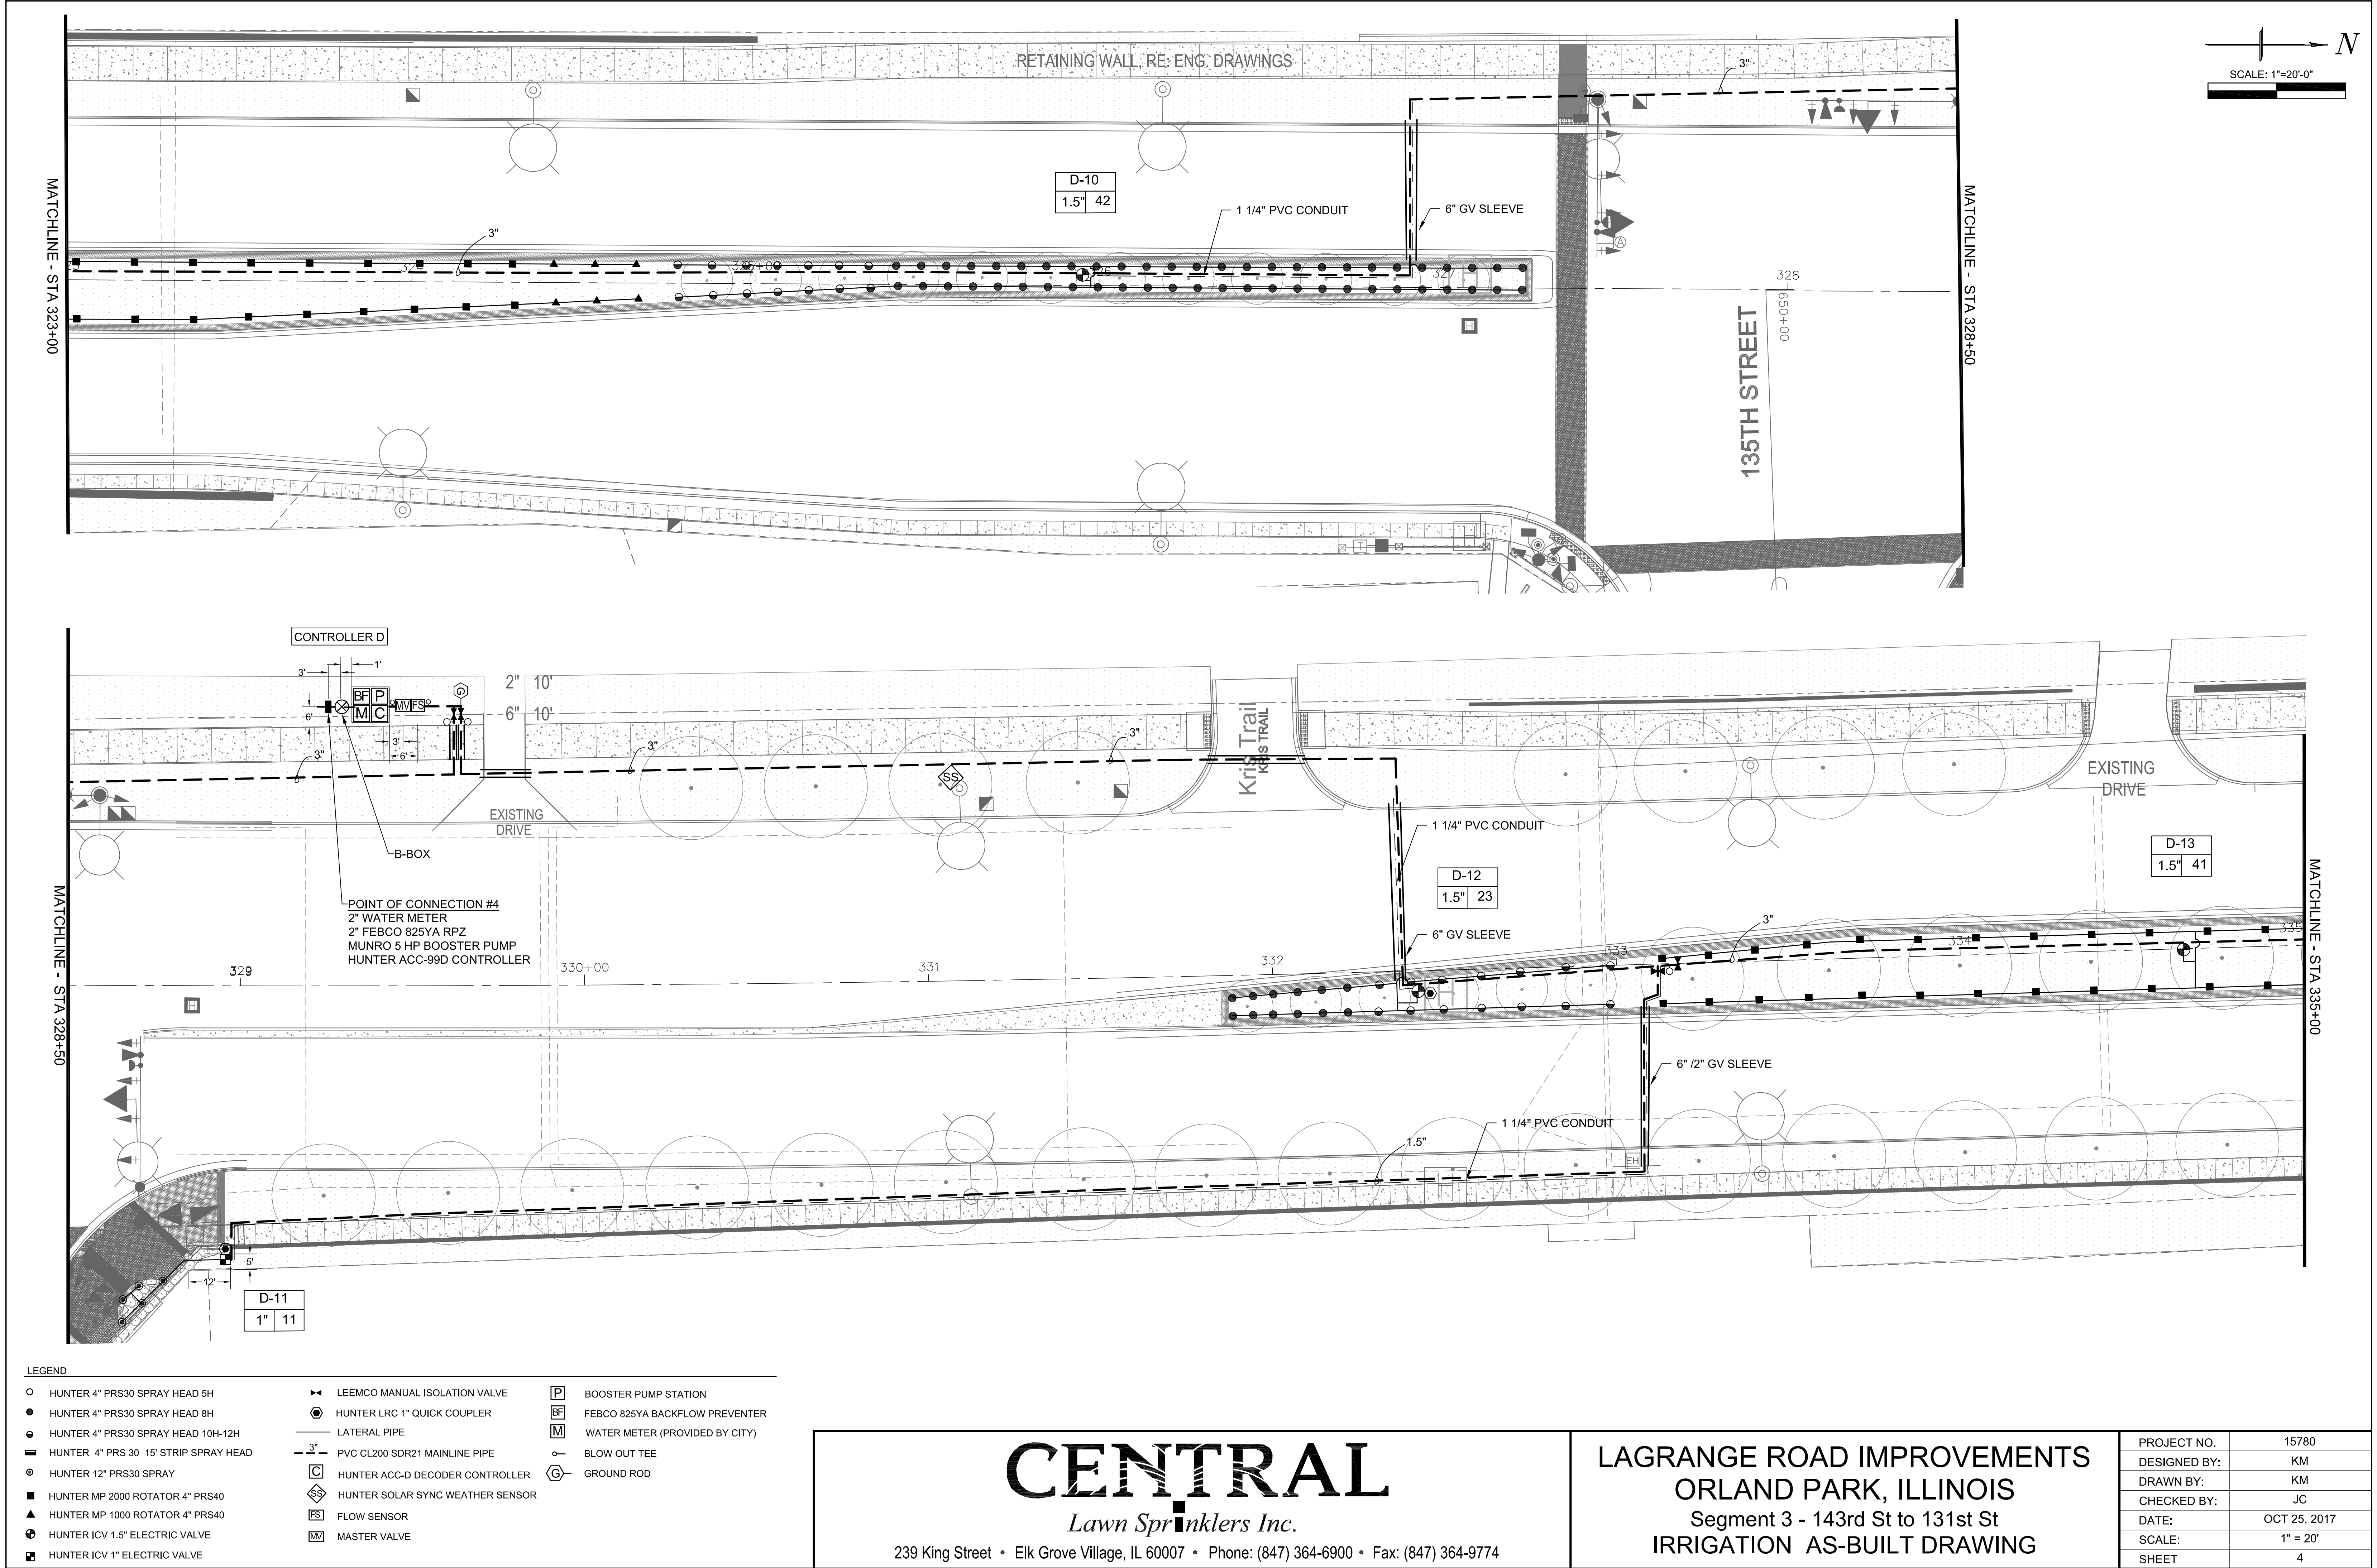

SCALE: 1"=20'-0"

MATCHLINE - STA 335+00

MATCHLINE - STA 328+50

MATCHLINE - STA 323+00

MATCHLINE - STA 328+50

LEGEND					
	HUNTER 4" PRS30 SPRAY HEAD 5H		LEEMCO MANUAL ISOLATION VALVE		BOOSTER PUMP STATION
	HUNTER 4" PRS30 SPRAY HEAD 8H		HUNTER LRC 1" QUICK COUPLER		FEBCO 825YA BACKFLOW PREVENTER
	HUNTER 4" PRS30 SPRAY HEAD 10H-12H		LATERAL PIPE		WATER METER (PROVIDED BY CITY)
	HUNTER 4" PRS 30 15' STRIP SPRAY HEAD		PVC CL200 SDR21 MAINLINE PIPE		BLOW OUT TEE
	HUNTER 12" PRS30 SPRAY		HUNTER ACC-D DECODER CONTROLLER		GROUND ROD
	HUNTER MP 2000 ROTATOR 4" PRS40		HUNTER SOLAR SYNC WEATHER SENSOR		
	HUNTER MP 1000 ROTATOR 4" PRS40		FLOW SENSOR		
	HUNTER ICV 1.5" ELECTRIC VALVE		MASTER VALVE		
	HUNTER ICV 1" ELECTRIC VALVE				

CENTRAL

Lawn Sprinklers Inc.

239 King Street • Elk Grove Village, IL 60007 • Phone: (847) 364-6900 • Fax: (847) 364-9774




LAGRANGE ROAD IMPROVEMENTS

ORLAND PARK, ILLINOIS

Segment 3 - 143rd St to 131st St

IRRIGATION AS-BUILT DRAWING

PROJECT NO.	15780
DESIGNED BY:	KM
DRAWN BY:	KM
CHECKED BY:	JC
DATE:	OCT 25, 2017
SCALE:	1" = 20'
SHEET	4

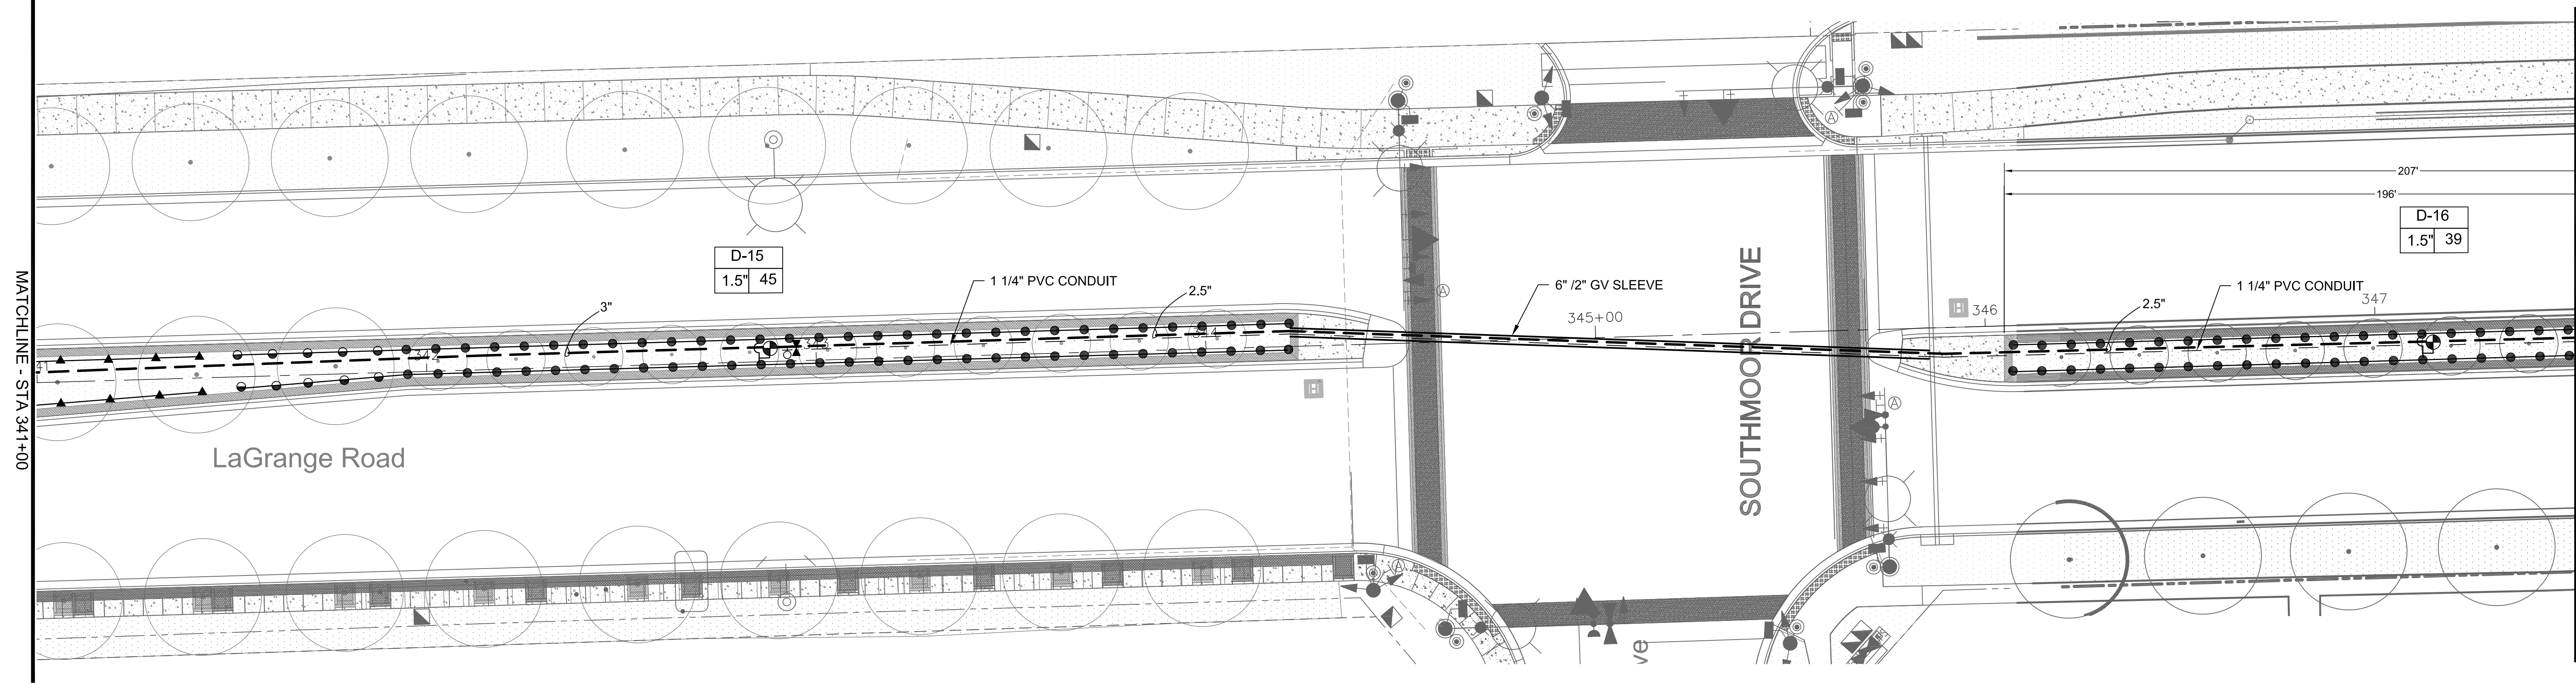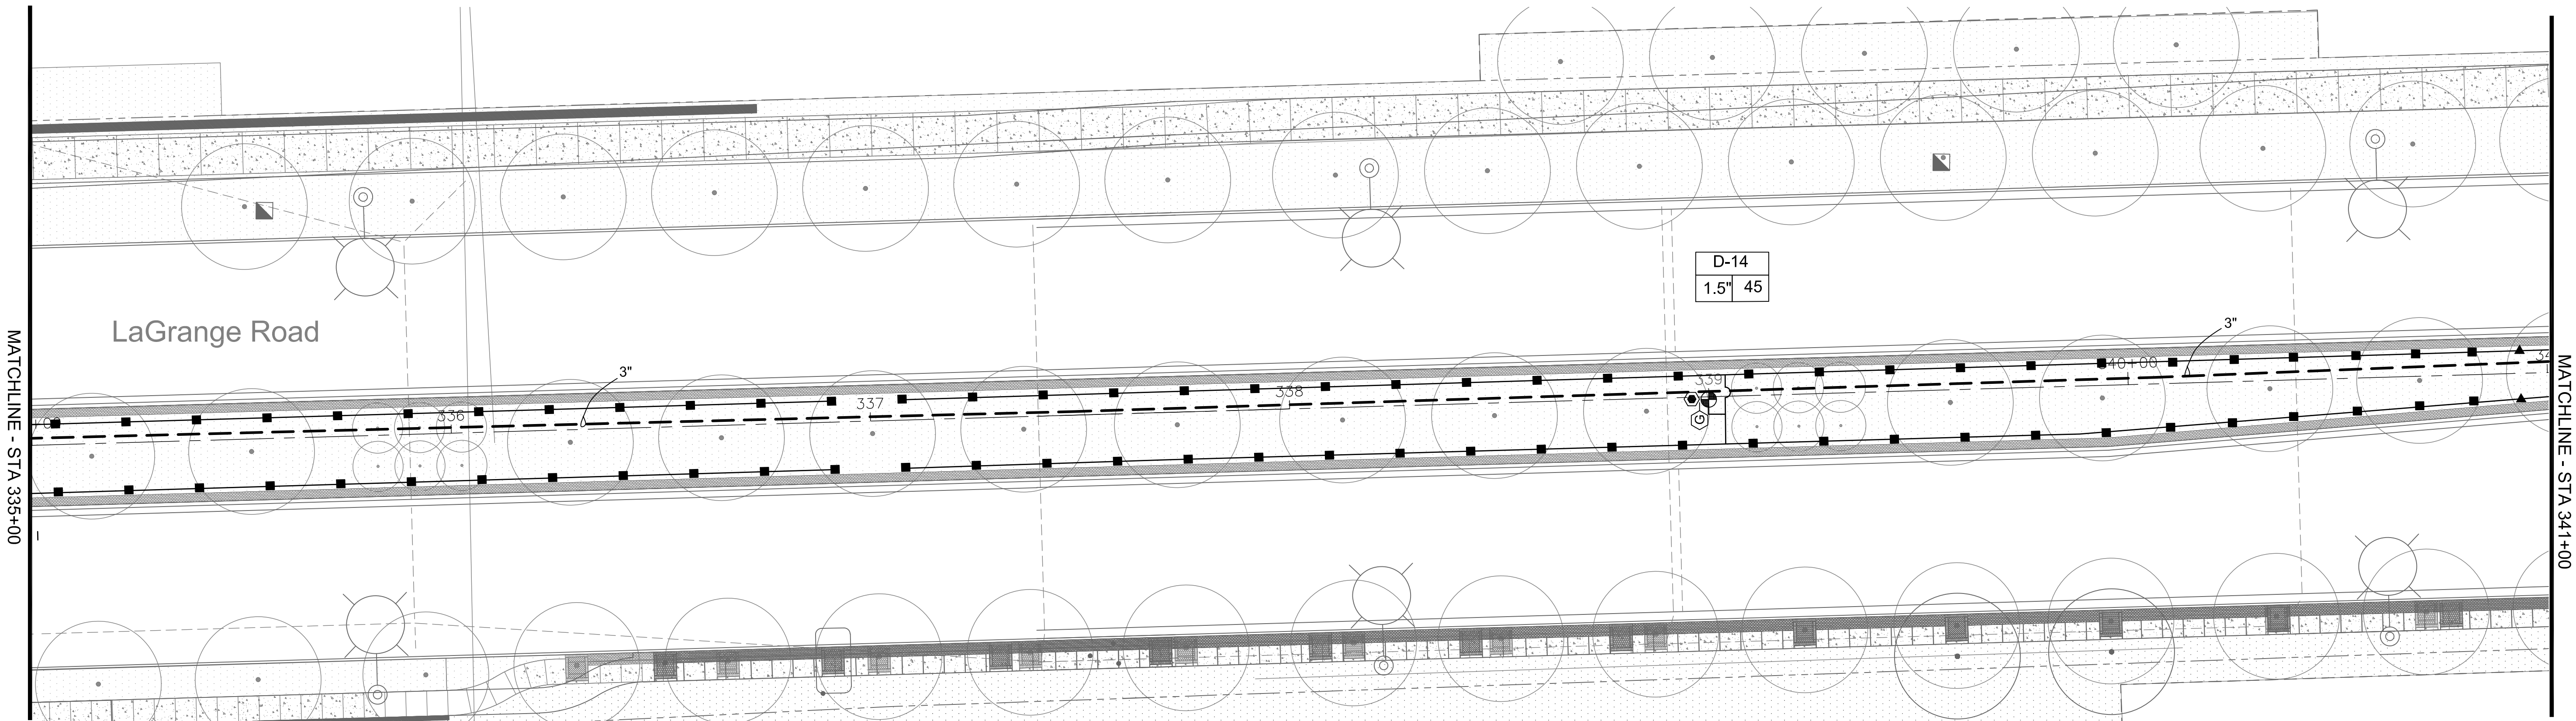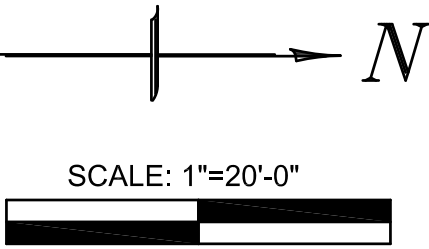

LEGEND			
HUNTER 4" PRS30 SPRAY HEAD 5H	LEEMCO MANUAL ISOLATION VALVE	BOOSTER PUMP STATION	
HUNTER 4" PRS30 SPRAY HEAD 8H	HUNTER LRC 1" QUICK COUPLER	FEBCO 825YA BACKFLOW PREVENTER	
HUNTER 4" PRS30 SPRAY HEAD 10H-12H	LATERAL PIPE	WATER METER (PROVIDED BY CITY)	
HUNTER 4" PRS 30 15' STRIP SPRAY HEAD	3" PVC CL200 SDR21 MAINLINE PIPE	BLOW OUT TEE	
HUNTER 12" PRS30 SPRAY	HUNTER ACC-D DECODER CONTROLLER	GROUND ROD	
HUNTER MP 2000 ROTATOR 4" PRS40	HUNTER SOLAR SYNC WEATHER SENSOR		
HUNTER MP 1000 ROTATOR 4" PRS40	FLOW SENSOR		
HUNTER ICV 1.5" ELECTRIC VALVE	MASTER VALVE		
HUNTER ICV 1" ELECTRIC VALVE			

CENTRAL

Lawn Sprinklers Inc.

239 King Street • Elk Grove Village, IL 60007 • Phone: (847) 364-6900 • Fax: (847) 364-9774


LAGRANGE ROAD IMPROVEMENTS

ORLAND PARK, ILLINOIS

Segment 3 - 143rd St to 131st St

IRRIGATION AS-BUILT DRAWING

PROJECT NO.	15780
DESIGNED BY:	KM
DRAWN BY:	KM
CHECKED BY:	JC
DATE:	OCT 25, 2017
SCALE:	1" = 20'
SHEET	5

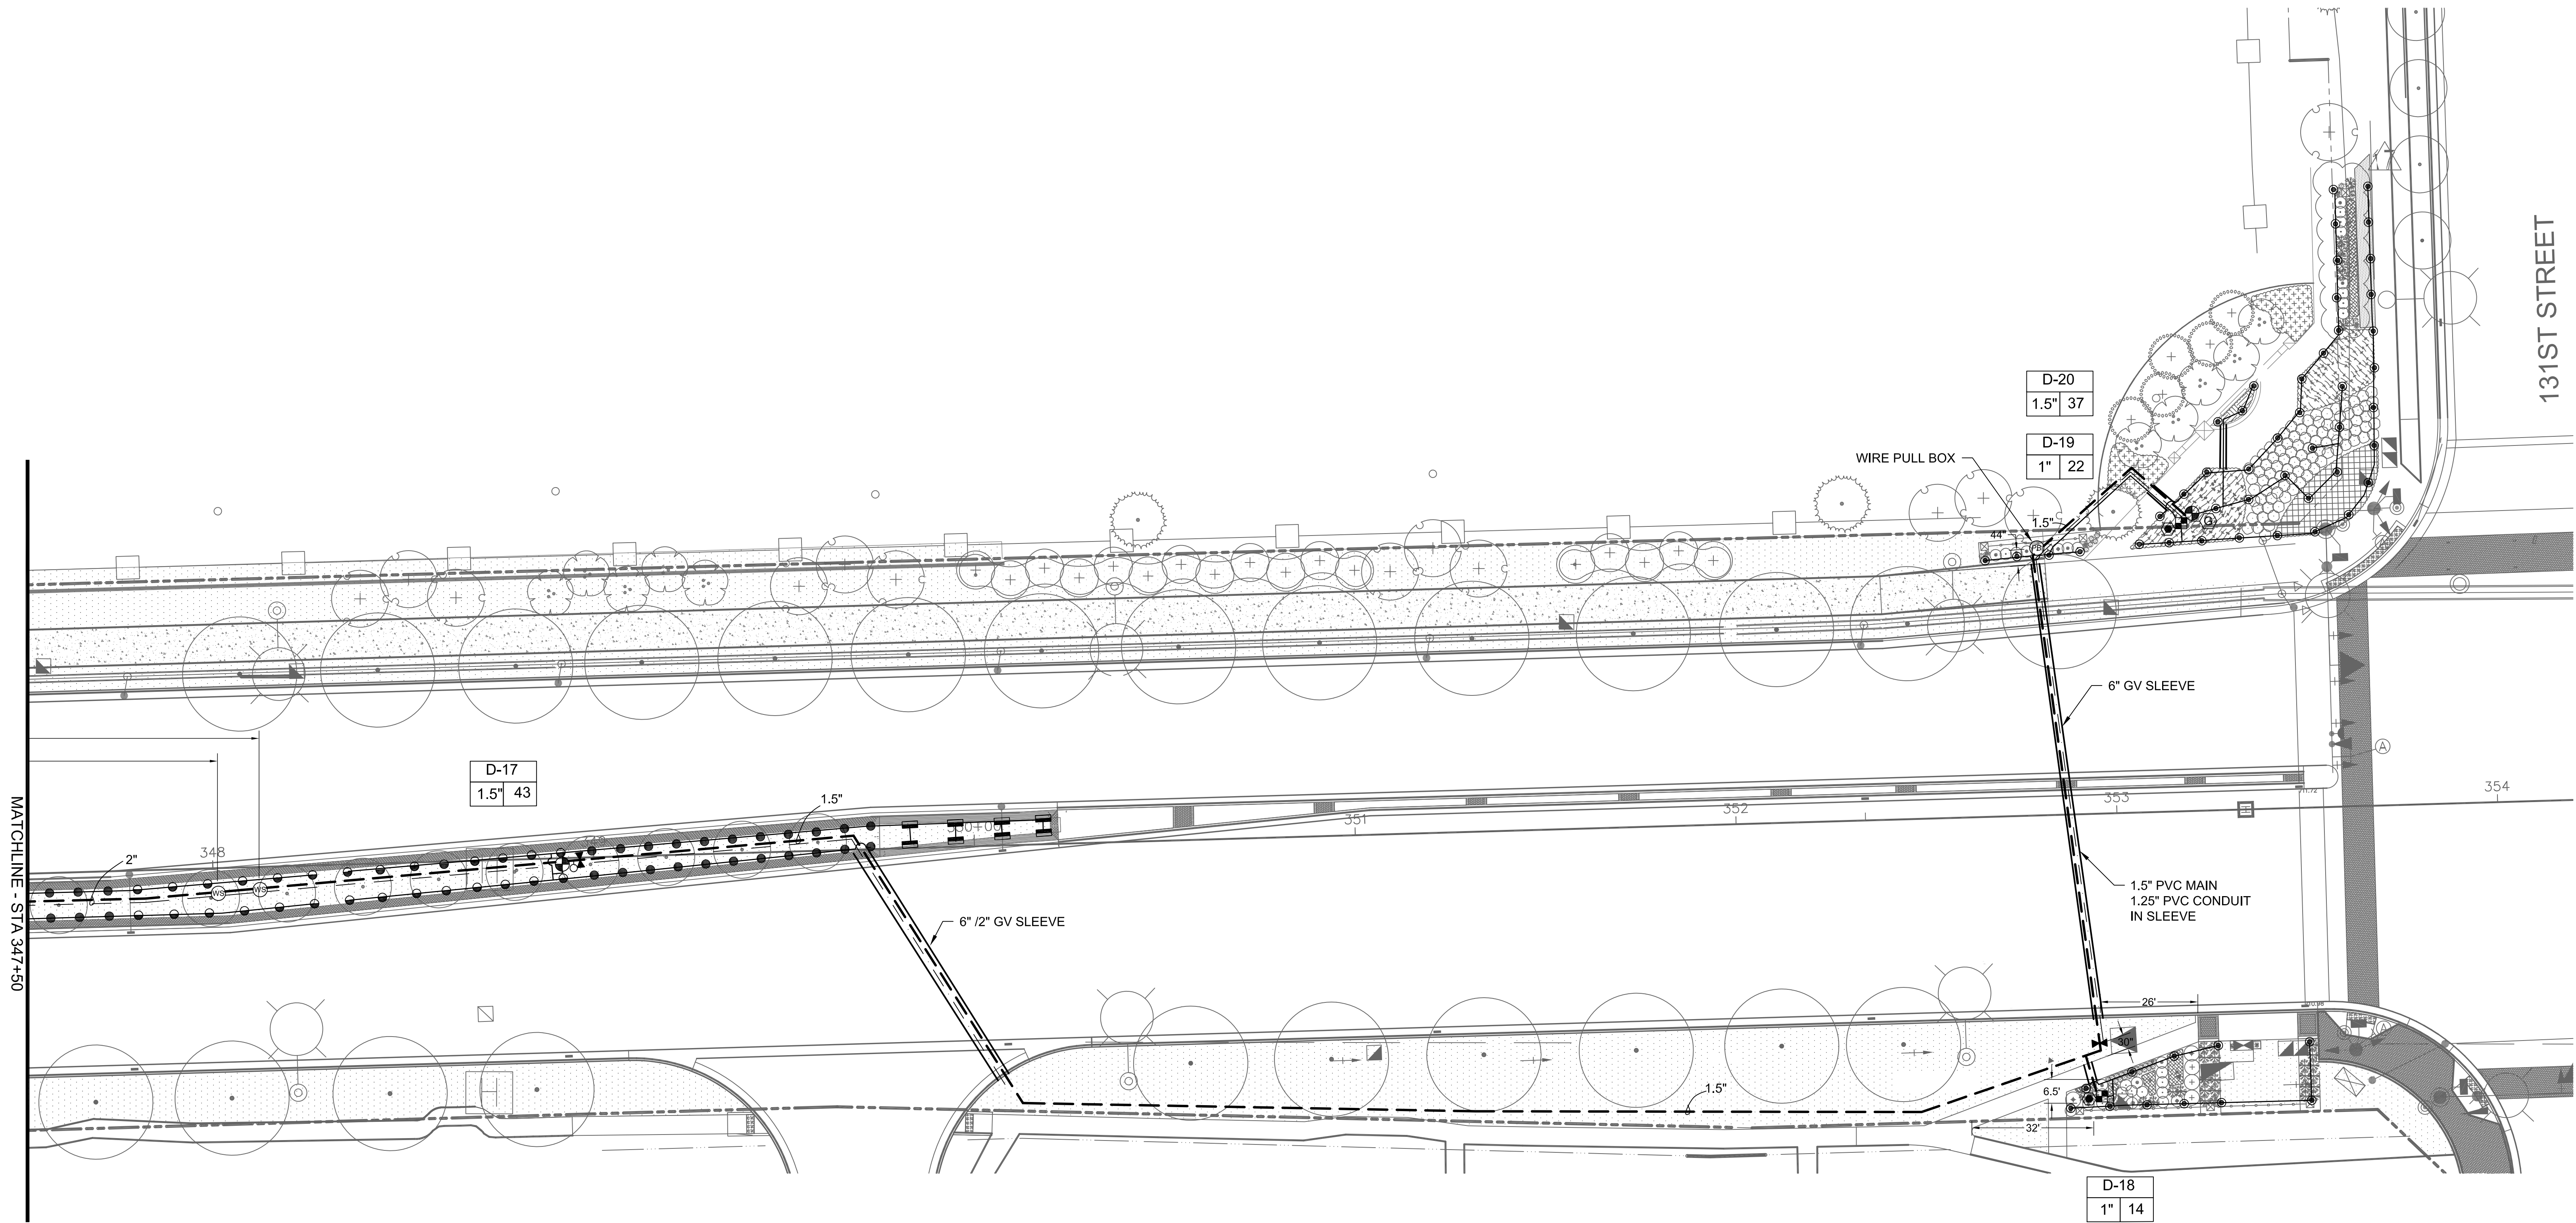

LEGEND

○ HUNTER 4" PRS30 SPRAY HEAD 5H	▶ LEEMCO MANUAL ISOLATION VALVE	Ⓟ BOOSTER PUMP STATION
● HUNTER 4" PRS30 SPRAY HEAD 8H	● HUNTER LRC 1" QUICK COUPLER	Ⓡ FEBCO 825YA BACKFLOW PREVENTER
● HUNTER 4" PRS30 SPRAY HEAD 10H-12H	— LATERAL PIPE	Ⓜ WATER METER (PROVIDED BY CITY)
▬ HUNTER 4" PRS 30 15' STRIP SPRAY HEAD	— 3" PVC CL200 SDR21 MAINLINE PIPE	— BLOW OUT TEE
⊙ HUNTER 12" PRS30 SPRAY	Ⓢ HUNTER ACC-D DECODER CONTROLLER	Ⓢ GROUND ROD
■ HUNTER MP 2000 ROTATOR 4" PRS40	Ⓢ HUNTER SOLAR SYNC WEATHER SENSOR	
▲ HUNTER MP 1000 ROTATOR 4" PRS40	Ⓢ FLOW SENSOR	
⊕ HUNTER ICV 1.5" ELECTRIC VALVE	Ⓜ MASTER VALVE	
■ HUNTER ICV 1" ELECTRIC VALVE		

CENTRAL
Lawn Sprinklers Inc.

239 King Street • Elk Grove Village, IL 60007 • Phone: (847) 364-6900 • Fax: (847) 364-9774

LAGRANGE ROAD IMPROVEMENTS
ORLAND PARK, ILLINOIS
Segment 3 - 143rd St to 131st St
IRRIGATION AS-BUILT DRAWING

PROJECT NO.	15780
DESIGNED BY:	KM
DRAWN BY:	KM
CHECKED BY:	JC
DATE:	OCT 25, 2017
SCALE:	1" = 20'
SHEET	6