



PAVING CONTRACTORS
ASPHALT PAVING MIXTURES
HOT-IN-PLACE RECYCLING

18100 South Indiana Avenue
Thornton, IL 60476-1299
708.877.7160 Fax: 708.877.5222
www.gallagherasphalt.com

Thursday, September 16, 2010

Edward Wilmes
Director of Public Works & Engineering
Village of Orland Park
15655 Ravinia Avenue
Orland Park, IL 60462

Re: Fountain Hills Subdivision

Dear Edward:

Please be advised we decline your offer to submit a proposal on the above referenced project.

Correspondence received from your department last fall indicated the village would require repairs on phases two and three. Each phase had a corresponding "Engineer's Statement of Probable Construction Cost". When our representative met with Rich Rittenbacher last week he outlined improvements required only for work in phase three. Since no work has been requested for phase two we are assuming the village now has deemed this work acceptable. Based on your estimate we respectfully request payment of \$11,810, the amount determined by the village as defective work. If this assumption is not true we request reasons why this work is not to be included on the requested proposal. I have included the referenced documents for your review.

Please contact me if you require anything further.

Sincerely,

A handwritten signature in black ink, appearing to read "JL", with a long horizontal stroke extending to the right.

Jeffrey L. Kolmodin
Vice President

cc: CJG E-mail
MWR e-mail
PDD e-mail

THORNTON

CHICAGO

JOLIET

BOURBONNAIS

Village of Orland Park

14700 Ravinia Avenue
Orland Park, IL 60462

Developer: Distinctive Homes

Page No. 2.00

Project: Fountain Hills - Phase 2

Date 11/13/2009

By WDC


Engineer's Statement of Probable Construction Cost

Item No.	Description	Quantity	Unit	Price	Amount
1	Milling-Edge	800	SY	\$2.20	\$ 1,760.00
2	Leveling Binder Course	50	TON	\$68.00	\$ 3,400.00
3	1.5" CL I Surface Course	95	TON	\$70.00	\$ 6,650.00
4	Sidewalk - Single Family Lots	575	SF	\$6.60	\$ 3,795.00
5	Sidewalk - Stub to Street & ADA	1	EA	\$450.00	\$ 450.00
6					
7					
8					
				Subtotal	\$ 16,055.00




} \$ 11,810.-

AS CONSTRUCTED PAVEMENT CROWN - 10/13/09

(112020)

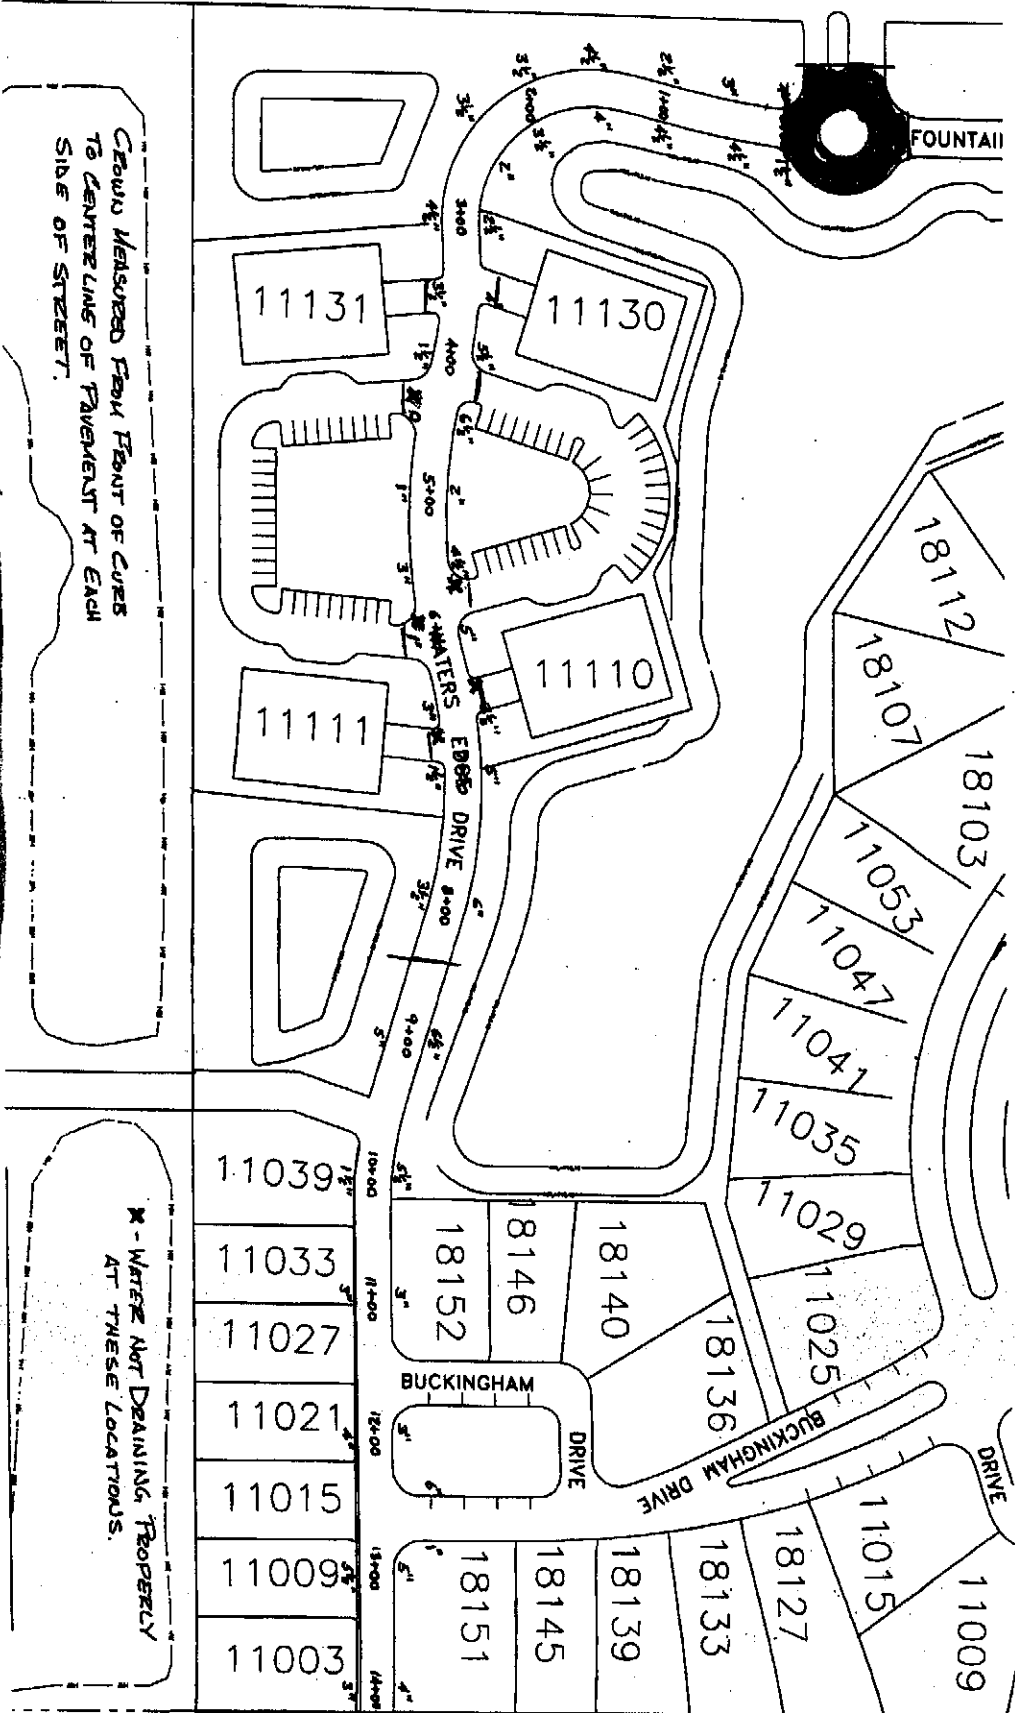

IMPROVEMENT REQUESTED BY
RICH PITTENBACHER

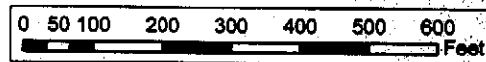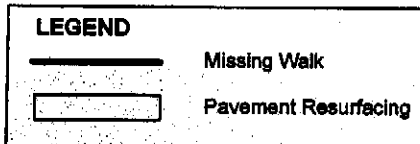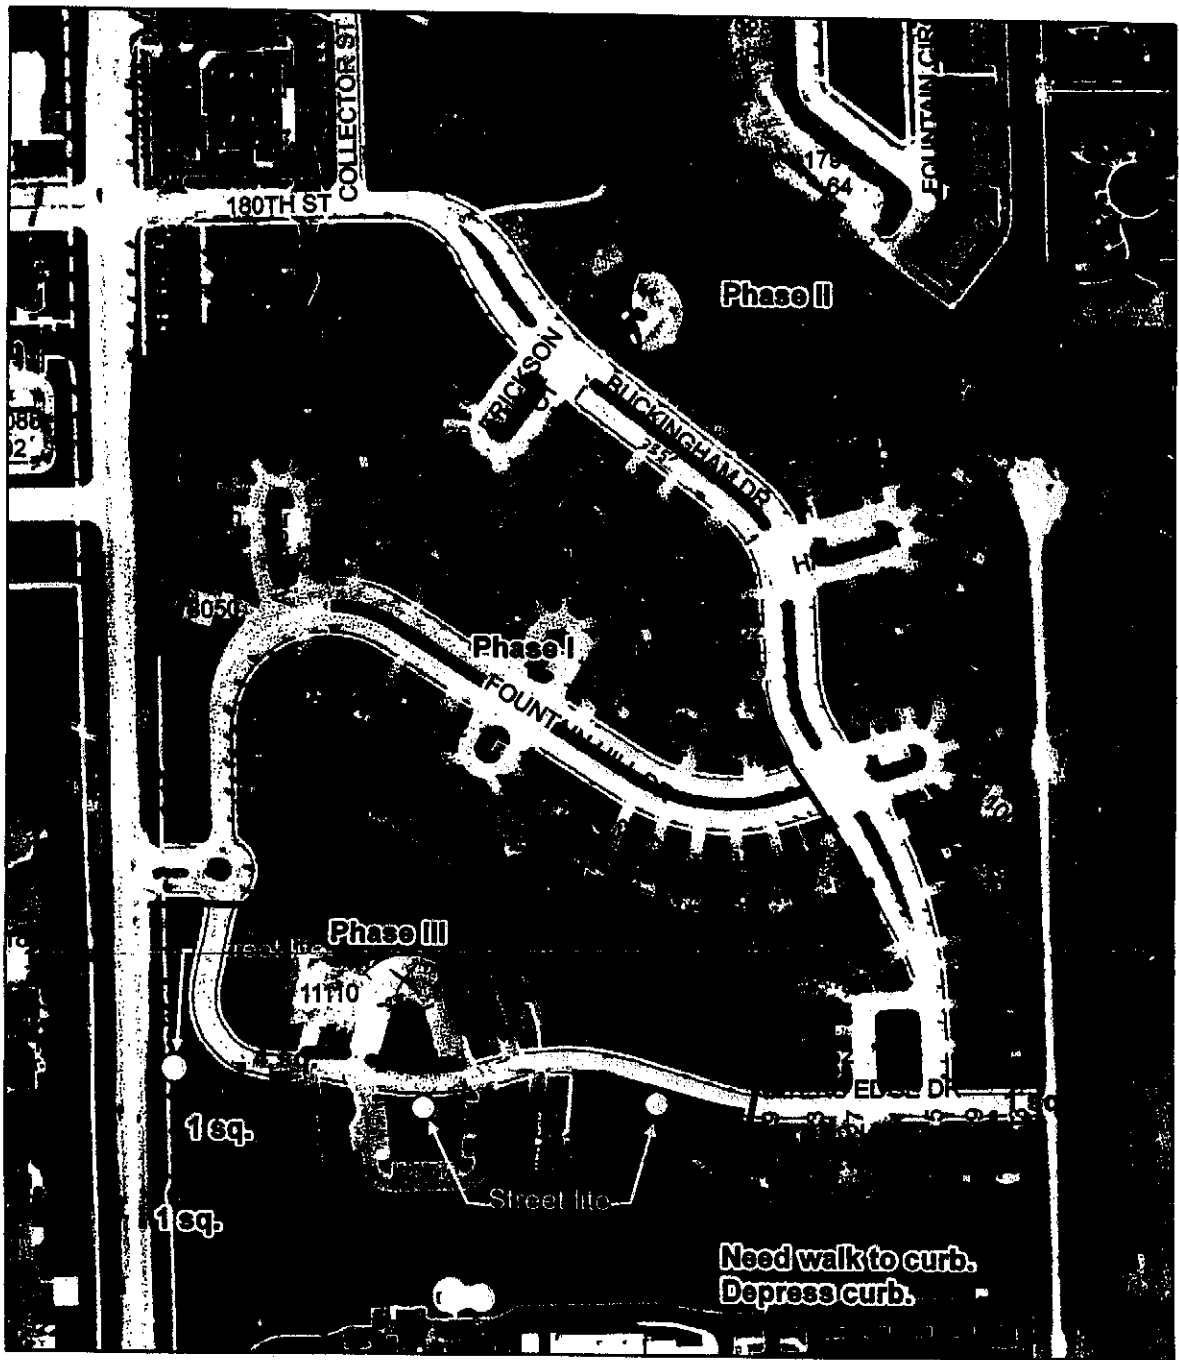

Sidewalks, Street Lites, and Pavement as of 06/16/09