



PRELIMINARY SITE IMPROVEMENT PLANS FOR RIZZA PORSCHE AND ACURA 8130 W. 159TH STREET ORLAND PARK, ILLINOIS 60462

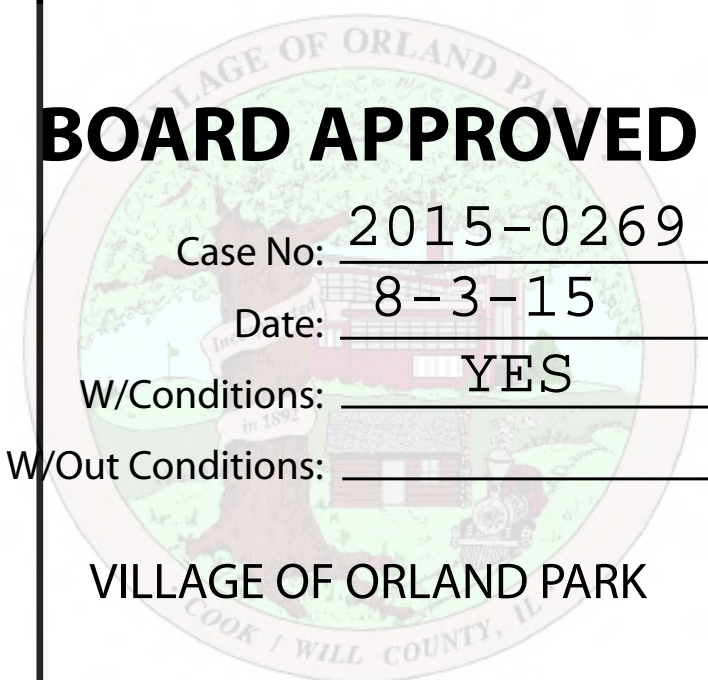

CIVIL DRAWING INDEX		
SHEET	DESCRIPTION	DATE
T-1.0	TITLE SHEET	06-17-15
C-2.0	SITE GEOMETRIC PLAN	06-17-15
C-2.1	PHASING PLAN	06-17-15
C-4.0	PRELIMINARY SITE GRADING PLAN	06-17-15
C-5.0	PRELIMINARY SITE UTILITY PLAN	06-17-15
C-6.0	SITE STORMWATER POLLUTION PREVENTION PLAN	06-17-15
C-7.0-C-7.1	CONSTRUCTION DETAILS	06-17-15
S-1 - S-2	BOUNDARY SURVEY (PREPARED BY W-T SURVEYING, INC.)	02-10-15
S-3	TOPOGRAPHIC SURVEY (PREPARED BY W-T SURVEYING, INC.)	02-10-15

BENCHMARK
1. ONSITE BENCHMARK #1- WEST SOUTHWEST FLANGE BOLT ON HYDRANT, 64.40' N.W. OF MH #3 AND 64.58' S.W. OF MH #4, ELEVATION=1011.66' (NAVD88)
2. ONSITE BENCHMARK #2- N.E. FLANGE BOLT ON HYDRANT, 37.42' N.W. OF MH #16 AND 40.42' E.N.E. OF MH#19, ELEVATION=1019.30' (NAVD88)

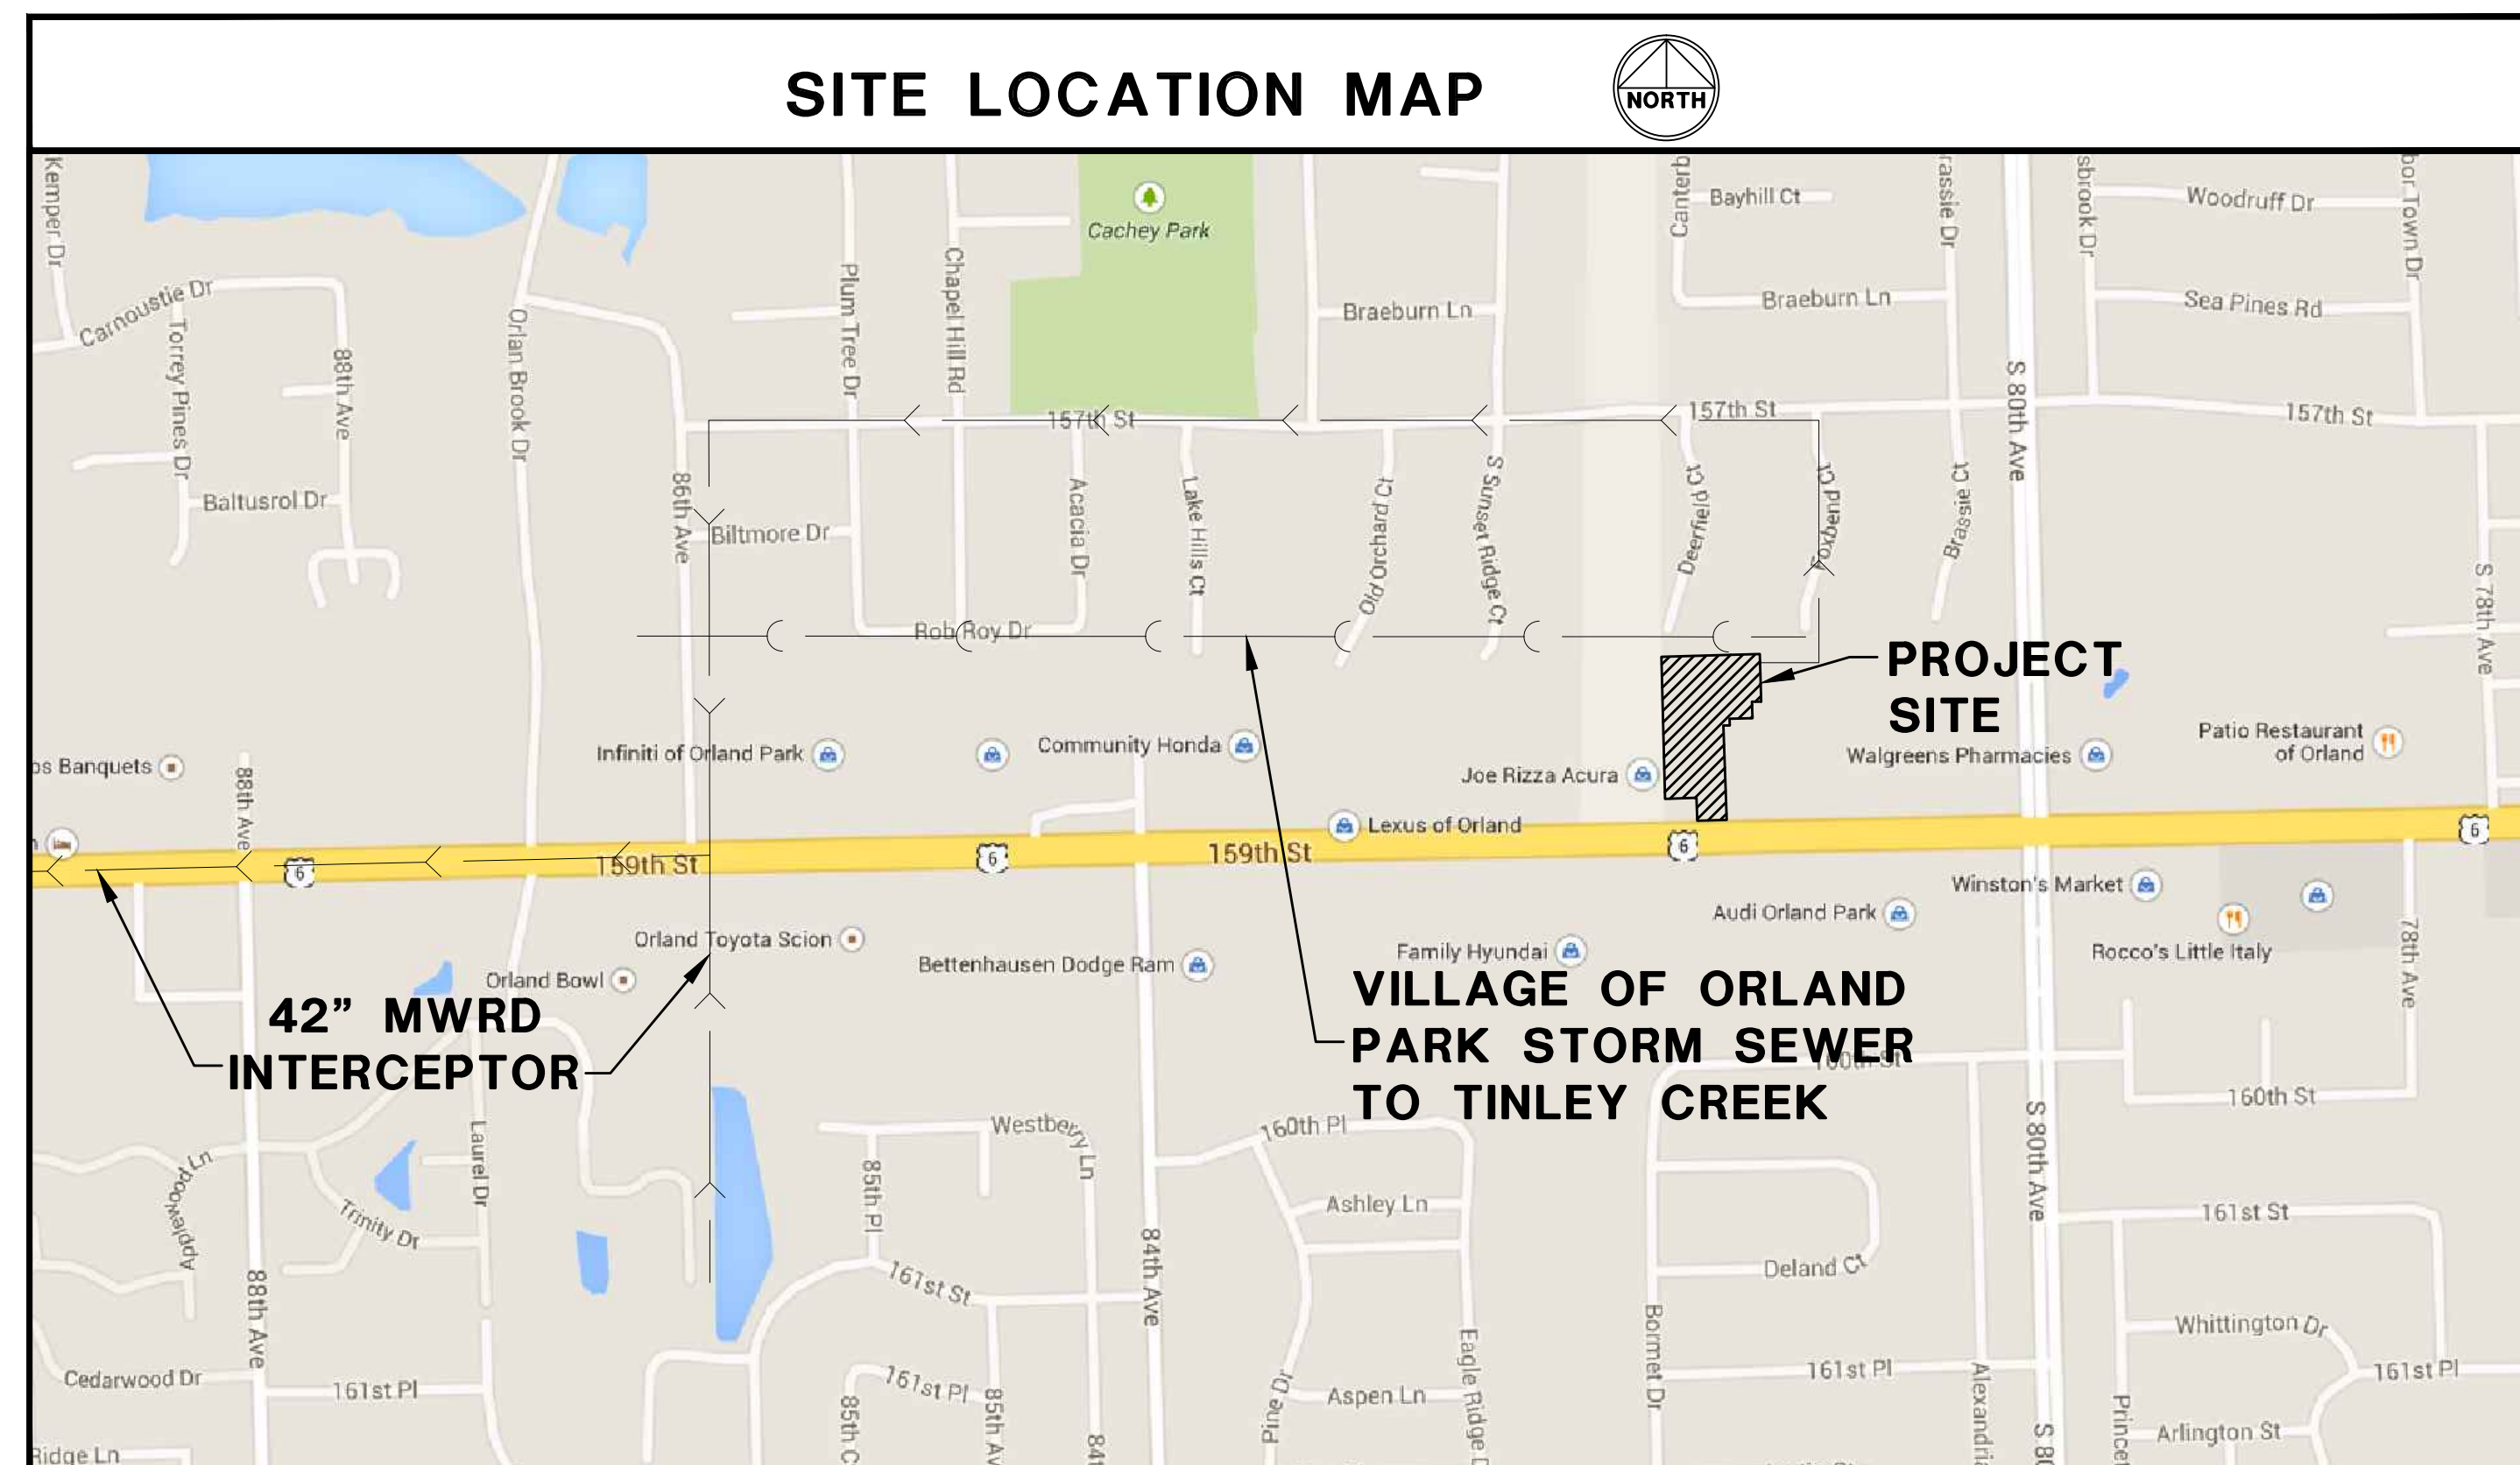

SECTION 14, TOWNSHIP 36 NORTH, RANGE 12 EAST
SCALE: 1" = 200'

CIVIL ENGINEERING STATEMENT AND SEAL

I, JASON E. GREEN, P.E., DULY LICENSED BY THE ILLINOIS DEPARTMENT OF FINANCIAL AND PROFESSIONAL REGULATION, DO HEREBY STATE THAT THIS DOCUMENT WAS PREPARED BY ME OR UNDER MY DIRECT SUPERVISION AND TO THE BEST OF MY KNOWLEDGE AND BELIEF DOES CONFORM TO THE APPLICABLE BUILDING CODES AND ORDINANCES, AND ARE IN COMPLIANCE WITH THE ENVIRONMENTAL BARRIERS ACT (610 ILCS 25) AND THE ILLINOIS ACCESSIBILITY CODE (71 ILL. ADM. CODE 400).

JASON E. GREEN - P.E.
062-059460 DATE OF EXPIRATION - NOVEMBER 30, 2015
NOTE: SIGNED AND SEALED FOR SHEETS T-1.0, C-2.0, C-2.1, C-4.0, C-5.0 - C-7.1

CALL JULIE TOLL FREE
(800)842-0123
OPERATES 24 HOURS A DAY 365 DAYS A YEAR



CALL
(800)842-0123
48 HOURS BEFORE
YOU DIG

CONTRACTOR MUST LOCATE PRIVATE UTILITIES IN AREA OF CONSTRUCTION PRIOR TO PROCEEDING WITH WORK

REVISIONS	DATE	BY
SUBMITTED FOR PRELIM. SITE PLAN REVIEW	4-10-15	ENK
PER VILLAGE COMMENTS	6-17-15	ENK

W-T CIVIL ENGINEERING, LLC
CIVIL AND STRUCTURAL ENGINEERS
2675 Pratum Avenue
Hoffman Estates, Illinois 60132
PH: (224) 726-5633
www.wtcivilengineering.com
IL License No.: 184-003492 Exp: 04/30/17




RIZZA PORSCHE AND ACURA
8130 W. 159TH STREET
ORLAND PARK, ILLINOIS 60462

TITLE SHEET

DATE:	4-10-15
SCALE:	NTS
DRAWN:	SMN
CHECK:	JLG
JOB:	CE14145
SHEET:	T-1.0

BOARD APPROVED
 Case No: 2015-0269
 Date: 8-3-15
 W/Conditions: YES
 W/Out Conditions:
 VILLAGE OF ORLAND PARK
 DEPT. OF PLANNING & ZONING

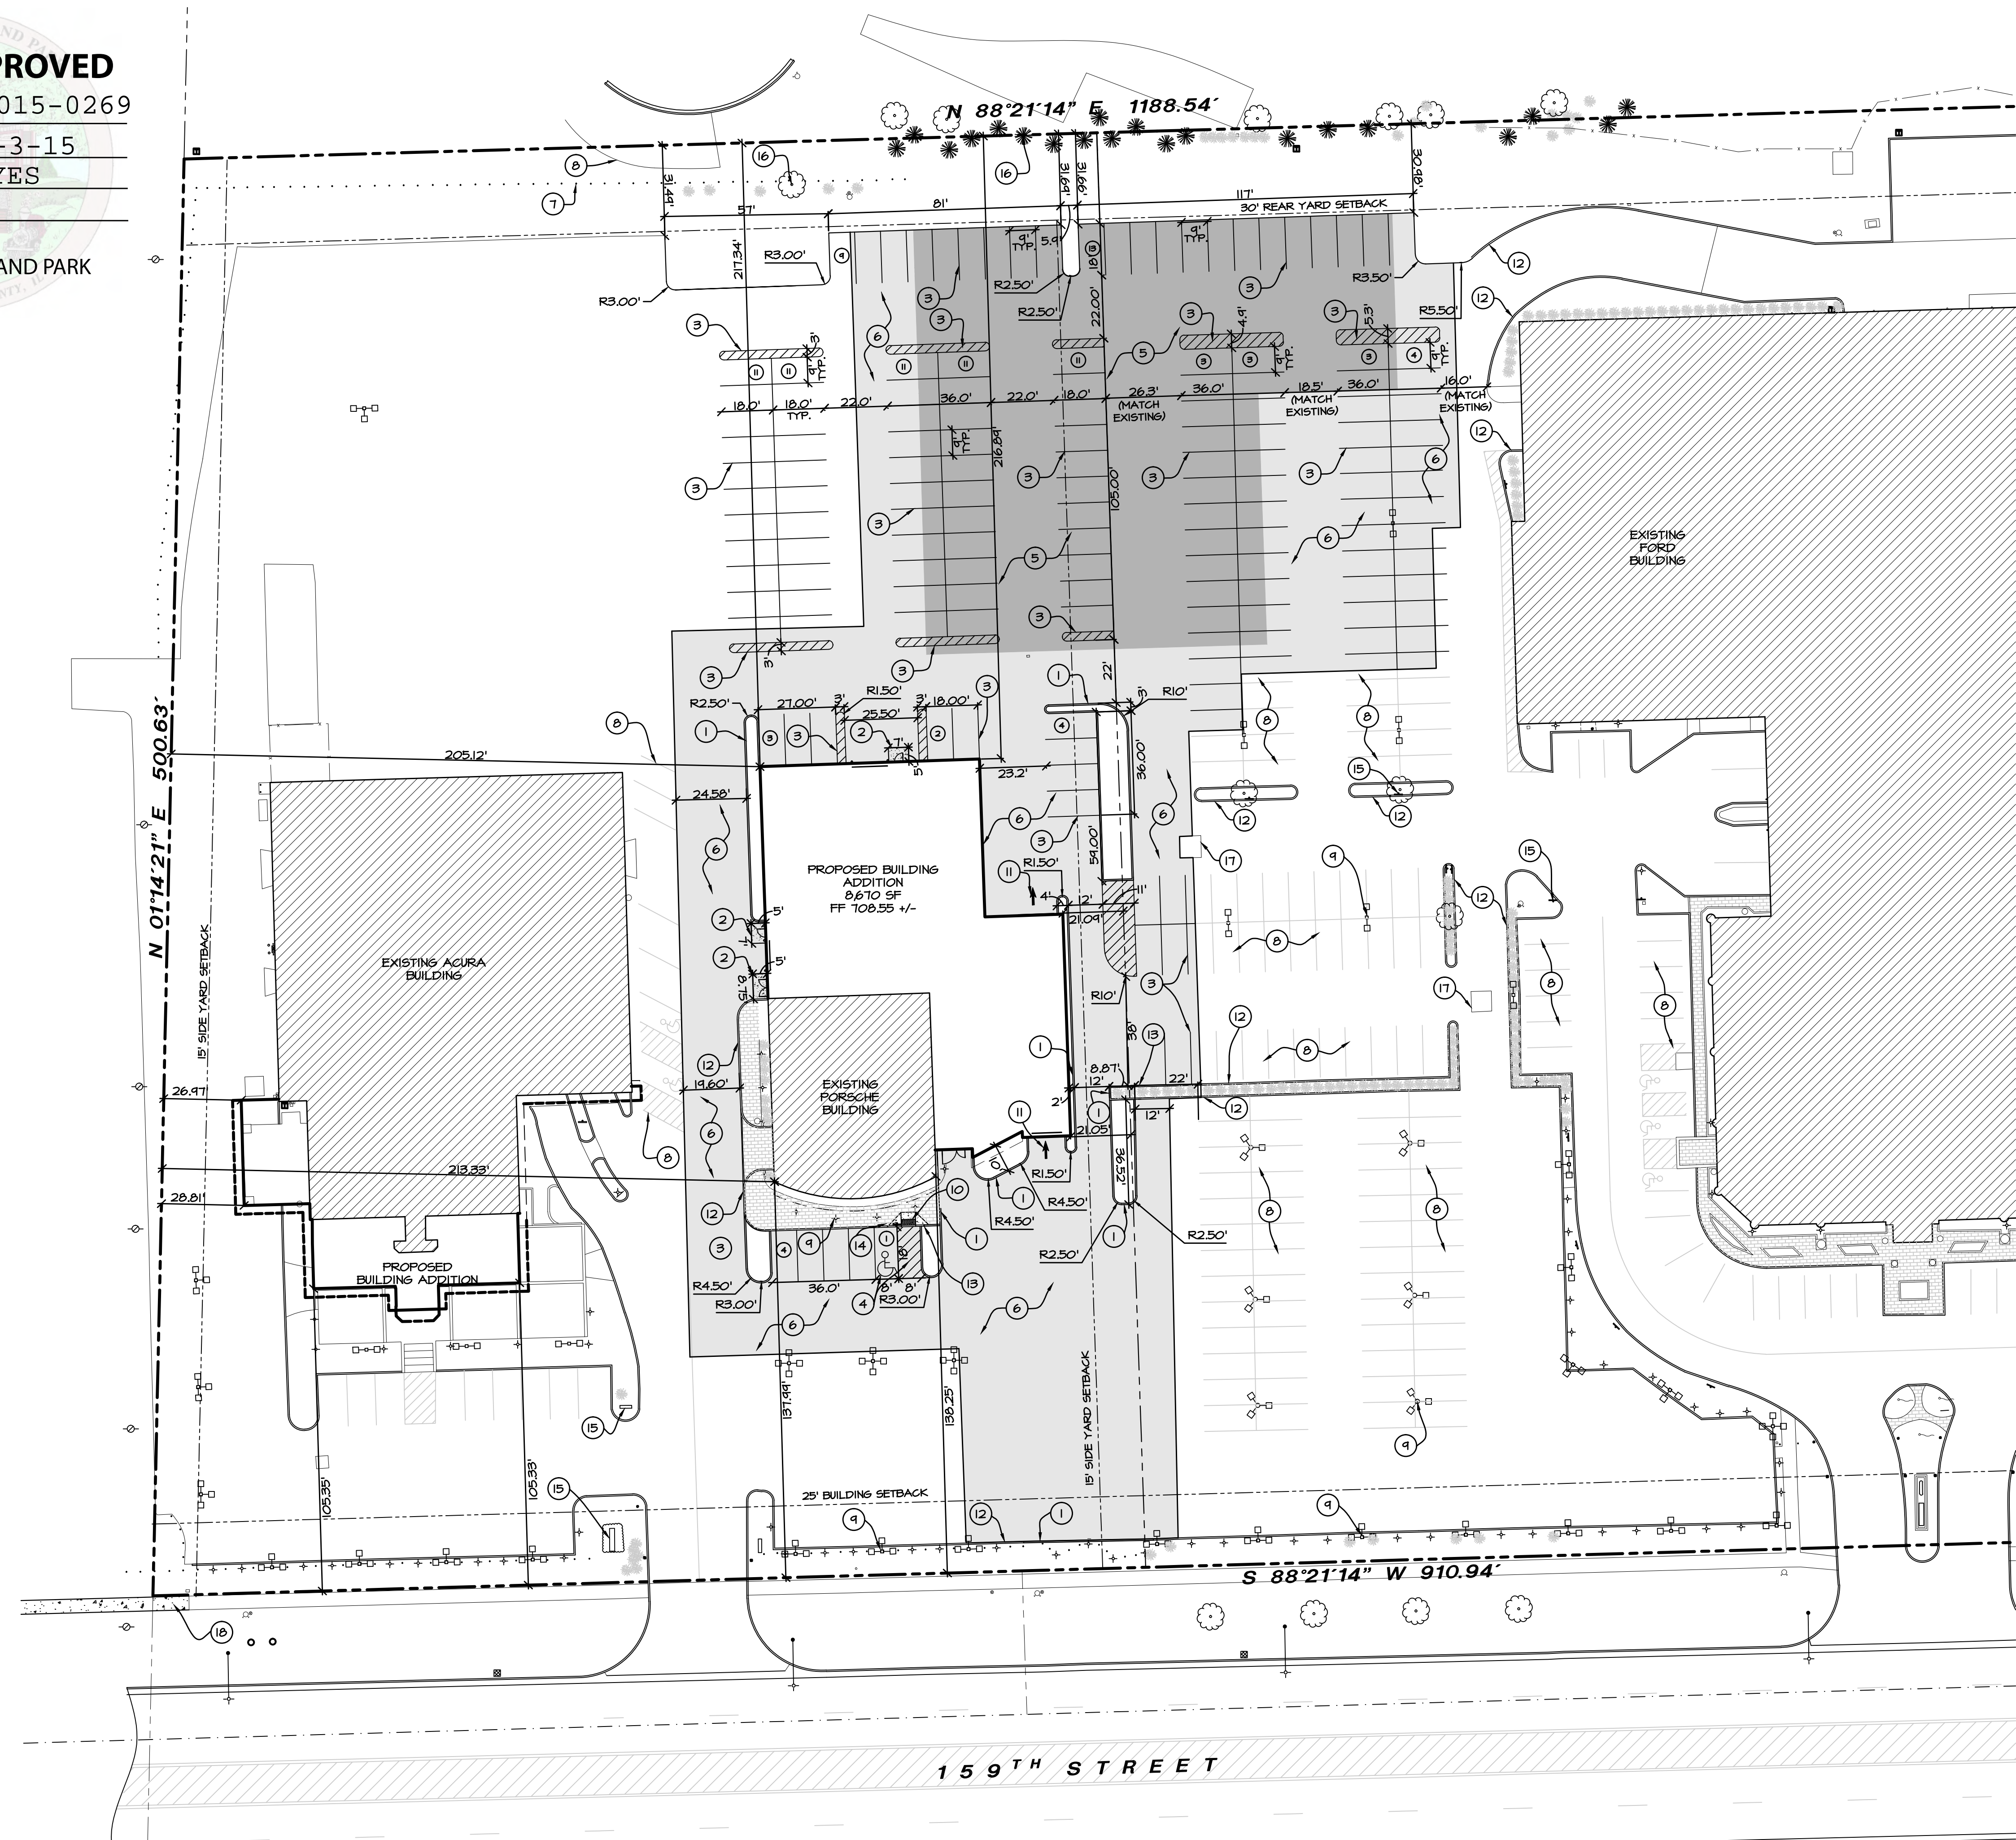

- LEGEND**
- - - - - EXISTING FENCE LINE
 - - - - - PROPOSED FENCE LINE
 - ⊙ EXISTING TREE
 - ⊙ EXISTING SHRUB
 - - - - - PROPOSED PROPERTY LINE
 - - - - - EXISTING PROPERTY LINE
 - + EXISTING AREA LIGHT
 - ⊙ EXISTING LIGHT POLE
 - ⊙ EXISTING SIGN
 - ⊙ EXISTING MONUMENT SIGN

- SITE GEOMETRIC NOTES:**
- ALL DIMENSIONS ARE FACE OF CURB OR EDGE OF PAVEMENT UNLESS NOTED OTHERWISE.
 - ALL RADII ARE MEASURED TO FACE OF CURB UNLESS NOTED OTHERWISE.
 - CONTRACTOR SHALL CONTACT JULLIE, (811 OR 1-800-842-0123) AND/OR PRIVATE LOCATING SERVICE TO LOCATE ALL UNDERGROUND UTILITY LINES PRIOR TO STARTING ANY DEMOLITION AND/OR EXCAVATION. EXACT LOCATIONS OF ANY EXISTING ELECTRIC, GAS, TELEPHONE, ETC. LINES ARE UNKNOWN.
 - CONTRACTOR SHALL EXCAVATE AND VERIFY ALL EXISTING SEWER LOCATIONS, SIZES, CONDITIONS AND ELEVATIONS AT PROPOSED POINTS OF CONNECTION PRIOR TO ANY UNDERGROUND CONSTRUCTION AND NOTIFY THE OWNER AND ENGINEER OF ANY DISCREPANCIES OR CONFLICTS.
 - TOPOGRAPHY SHOWN REPRESENTS SITE CONDITIONS PER BOUNDARY & TOPOGRAPHIC SURVEY LAST DATED 2-10-15, PREPARED BY W-T LAND SURVEYING, INC. CONTRACTOR SHALL FIELD VERIFY EXISTING ELEVATIONS AND CONDITIONS (INCLUDING BUT NOT LIMITED TO VERIFICATION OF CONTROL AND ALL UTILITIES WHETHER DEPICTED OR NOT) PRIOR TO CONSTRUCTION.
 - PARKING LOT PAVEMENT MARKINGS SHALL BE PAINTED WITH TWO COATS OF 4" YELLOW EXCEPT STOP BARS AND ANY OTHER LANE MARKINGS, WHICH SHALL BE PAINTED WHITE. ALL PAVEMENT MARKINGS SHALL BE MADE WITH HIGH QUALITY PAINT CONFORMING TO ARTICLE 1045.02 OF THE I.D.O.T. STANDARD SPECIFICATIONS.
 - CONSTRUCTION SURVEY AND STAKEOUT SHALL BE THE RESPONSIBILITY OF THE CONTRACTOR.
 - ALL EXISTING LANDSCAPE TO REMAIN UNLESS NOTED TO BE REMOVED. RESTORE ALL DISTURBED GREEN AREAS WITH MINIMUM 6" TOPSOIL AND SEED UNLESS NOTED OTHERWISE.


- PROJECT NOTES**
- NEW 6" BARRIER CURB.
 - NEW CONCRETE SIDEWALK.
 - NEW 4" WIDE YELLOW PAINTED PAVEMENT STRIPING.
 - NEW HANDICAP STALL WITH STRIPING.
 - NEW FULL DEPTH ASPHALT PAVEMENT.
 - NEW ASPHALT OVERLAY.
 - EXISTING BOLLARD TO REMAIN (TYP.).
 - EXISTING PARKING FOR ADJACENT PROPERTY (TO REMAIN).
 - EXISTING LIGHT POLE TO REMAIN (TYP.).
 - NEW HANDICAP ACCESSIBLE RAMP WITH 2' WIDE TRUNCATED DOME PANEL.
 - NEW PAINTED DIRECTIONAL ARROW.
 - EXISTING CURB TO REMAIN.
 - NEW FULL DEPTH SANICUT.
 - NEW HANDICAP PARKING SIGN.
 - EXISTING SIGN TO REMAIN (TYP.).
 - EXISTING TREE TO REMAIN (TYP.).
 - EXISTING CONCRETE PAD TO REMAIN.
 - EXISTING 5" CONCRETE SIDEWALK TO BE EXTENDED +/- 250' WEST ACROSS AUTOMOBILE STORAGE LOT AND CONNECT TO EXISTING SIDEWALK.

HATCH LEGEND

- NEW FULL DEPTH ASPHALT
- ASPHALT OVERLAY
- CONCRETE SIDEWALK

EXISTING PARKING COUNT		NEW PARKING COUNT	
REGULAR PARKING STALLS	84	PORSCHE STORAGE	64
ACCESSIBLE	1	EMPLOYEE / CUSTOMER ACCESSIBLE	13
TOTAL	85	TOTAL	104

	IMPERVIOUS / PERVIOUS AREA	
	EXISTING (SF)	PROPOSED (SF)
IMPERVIOUS	84,174	84,452
PERVIOUS	12,583	12,410

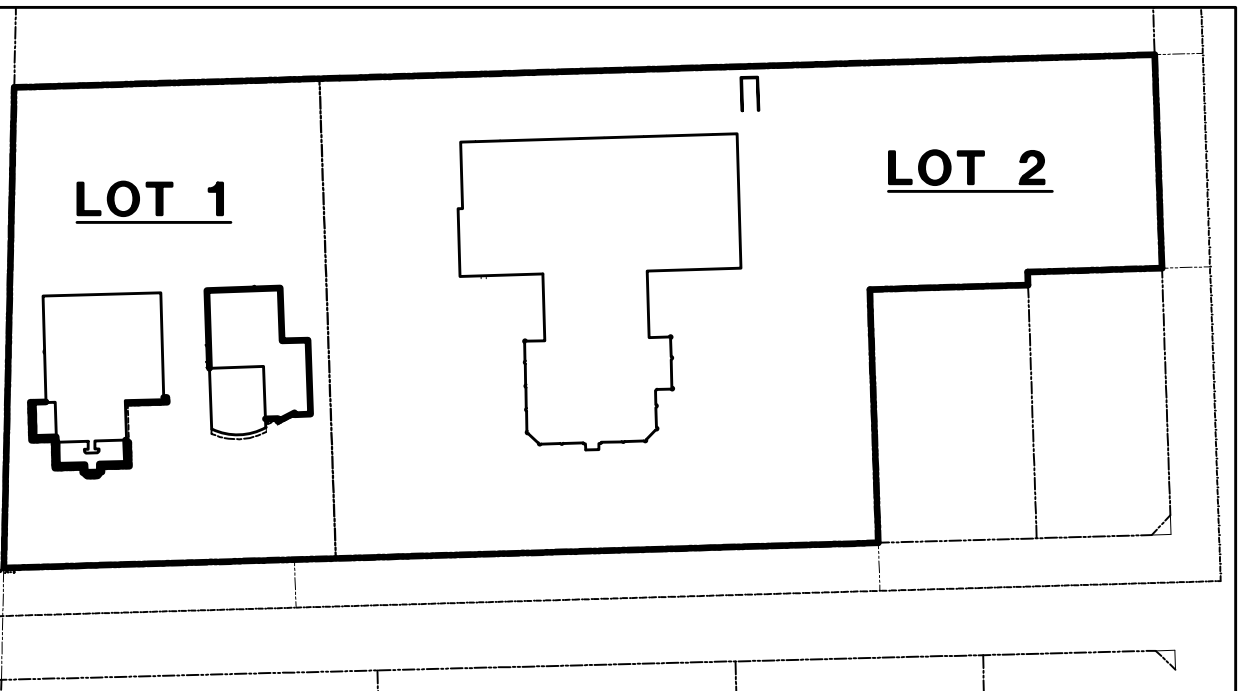

OVERALL SITE PLAN
 LOT 1 ACREAGE = 3.81 ACRES
 LOT 1 COVERAGE = 88.2%

159TH STREET


NORTH

1" = 30'

00 15 30 60 120

DATE	BY
4-10-15	ENK
6-17-15	ENK
7-28-15	JLG

W-T CIVIL ENGINEERING, LLC
 CIVIL AND STRUCTURAL ENGINEERS
 2675 Pratum Avenue
 Hoffman Estates, Illinois 60152
 PH: (224) 226-6444
 www.wtcivilengineering.com
 IL License No.: 184-003492 Exp: 04/30/17

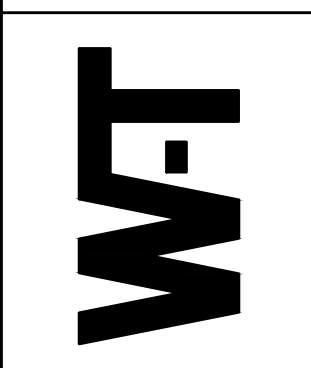


RIZZA PORSCHE AND ACURA
 8130 W. 159TH STREET
 ORLAND PARK, ILLINOIS 60462

SITE GEOMETRIC PLAN

DATE: 4-10-15
 SCALE: 1" = 30'
 DRAWN: SMN
 CHECK: JLG
 JOB: CE14145
 SHEET: C-2.0


BOARD APPROVED
 Case No: 2015-0269
 Date: 8.3.15
 W/Conditions: YES
 W/Out Conditions: _____
 VILLAGE OF ORLAND PARK
 COOK / WILL COUNTY

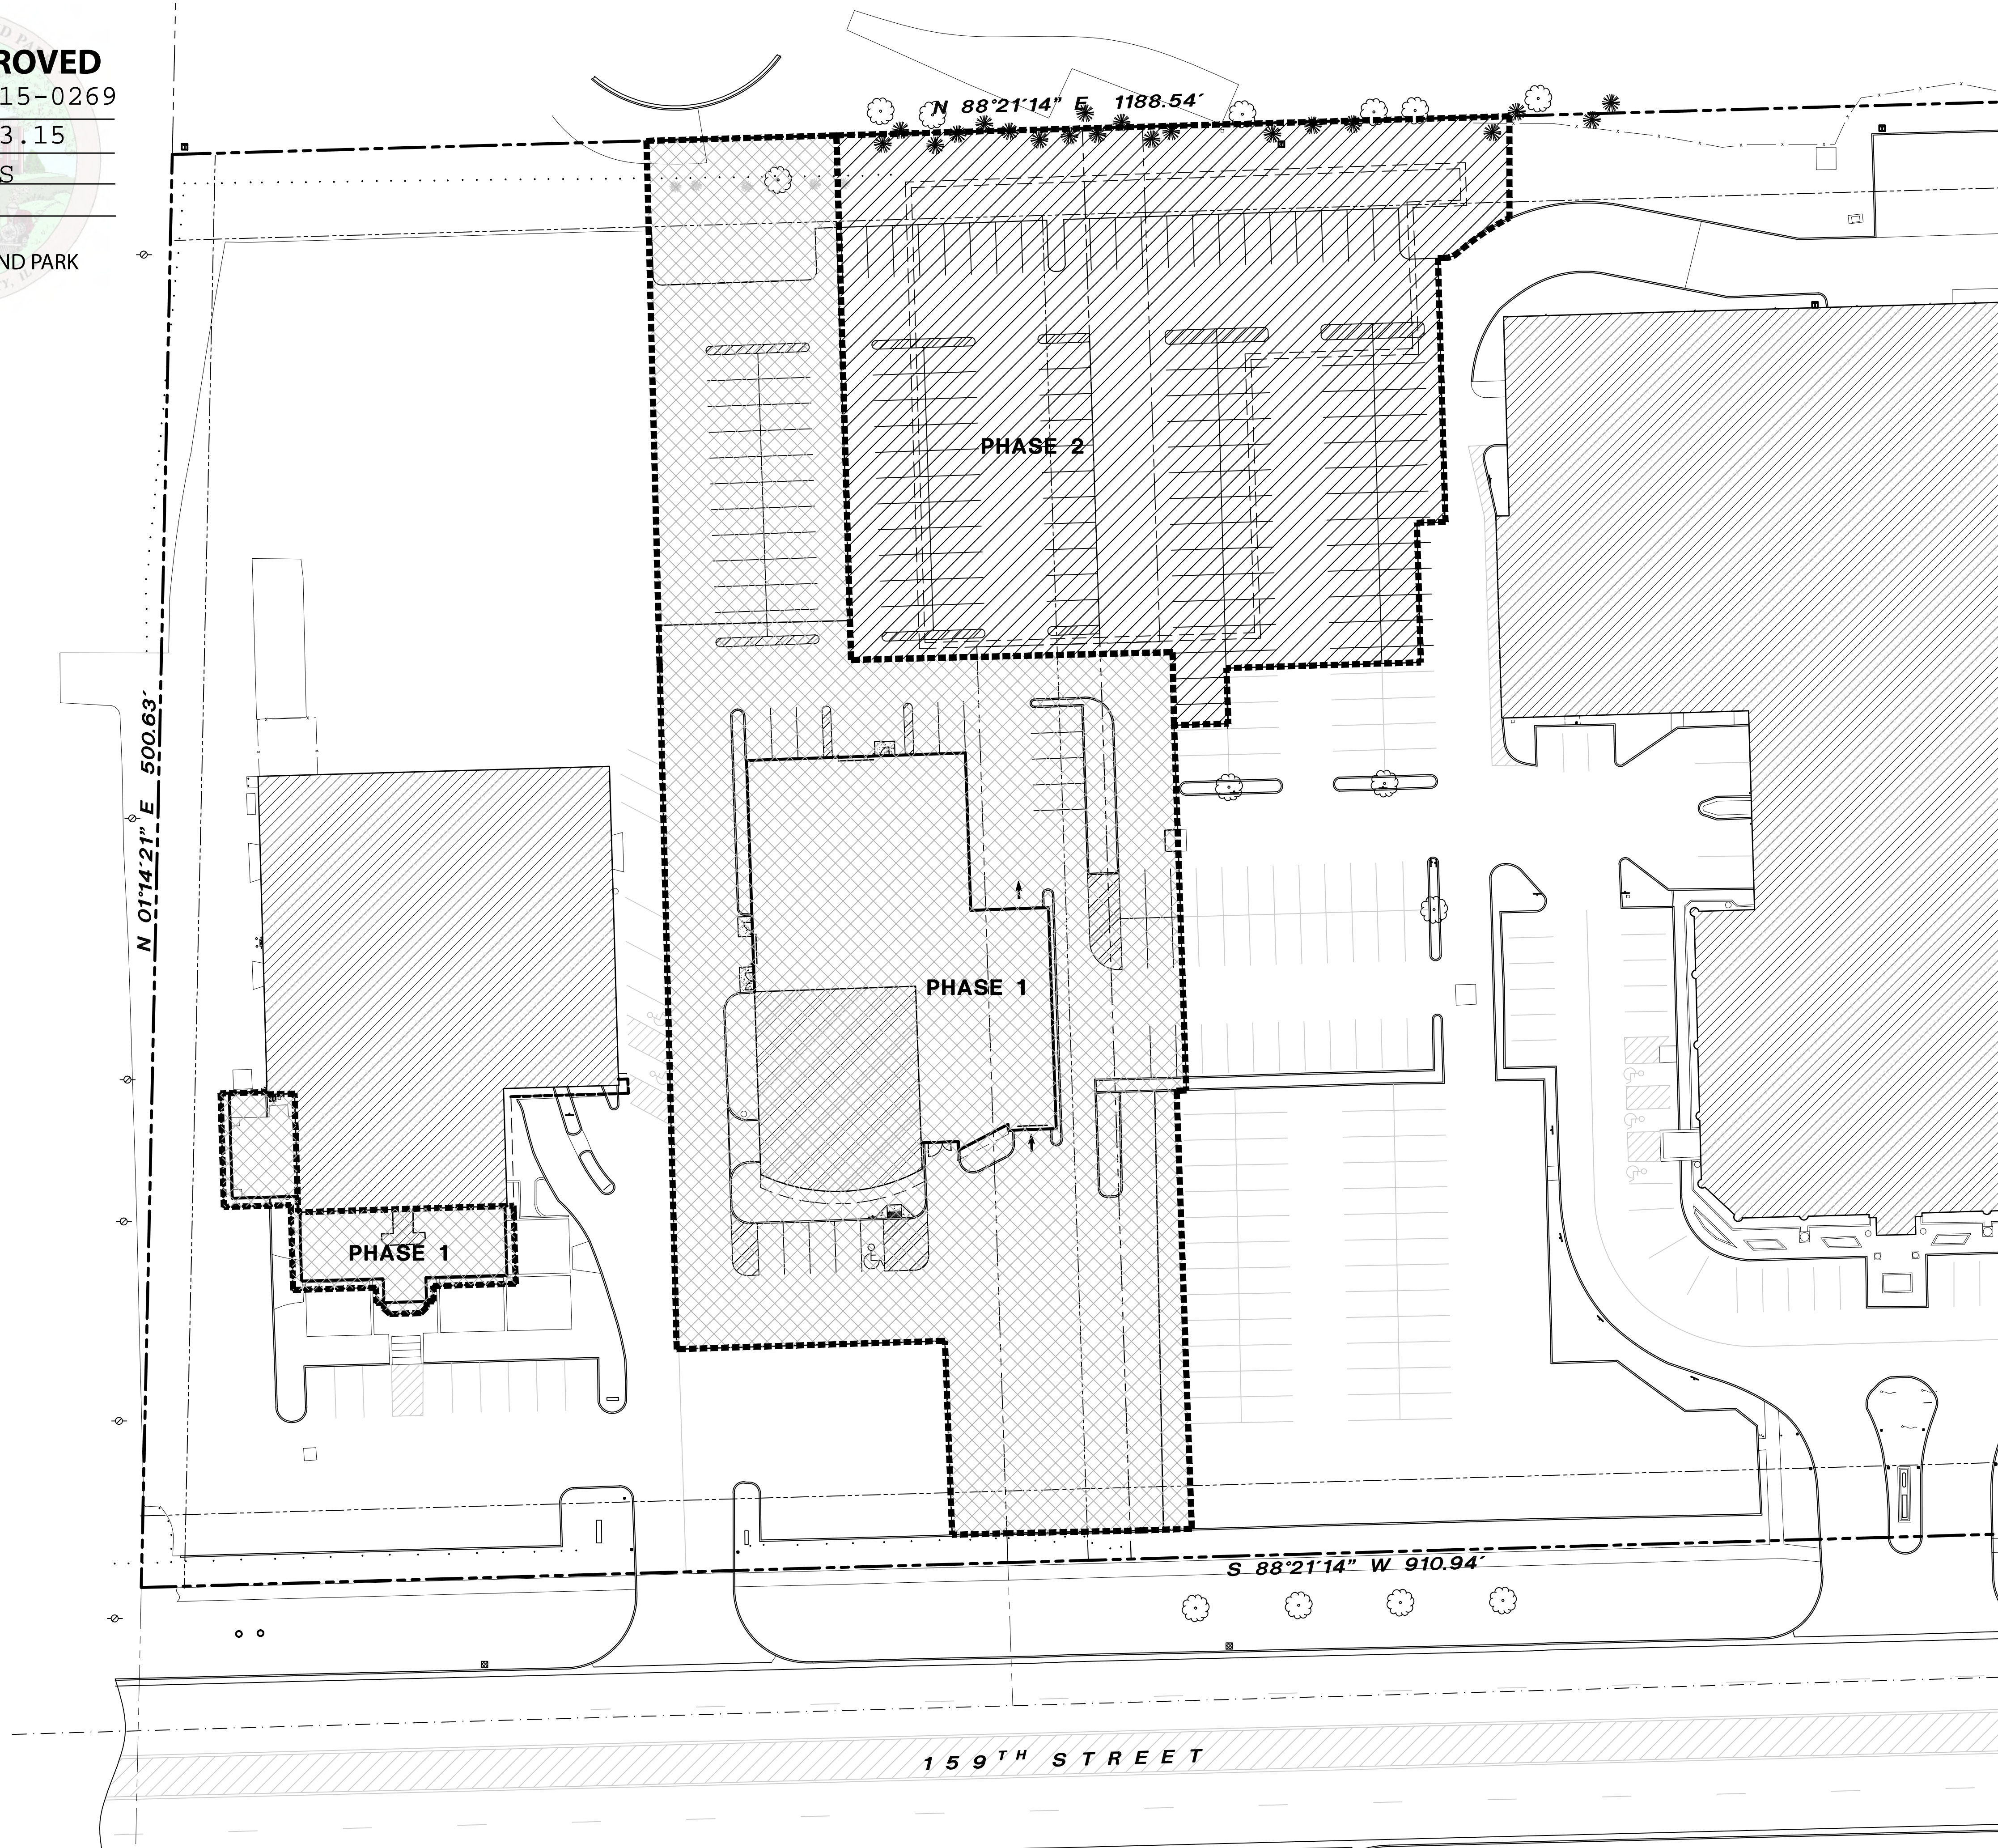

PHASING LEGEND
 PHASE 1 IMPROVEMENTS
 PHASE 2 IMPROVEMENTS

REVISIONS	DATE	BY
SUBMITTED FOR PRELIM. SITE PLAN REVIEW	4-10-15	ENK
PER VILLAGE COMMENTS	6-11-15	ENK

W-T CIVIL ENGINEERING, LLC
 CIVIL AND STRUCTURAL ENGINEERS
 2675 Pratum Avenue
 Hoffman Estates, Illinois 60132
 PH: (224) 426-6333
 www.wtengineering.com
 IL License No.: 184-003492 Exp: 04/30/17

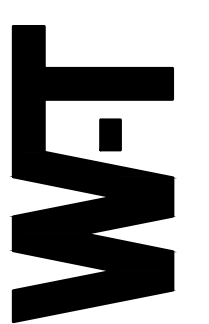


RIZZA PORSCHE AND ACURA
 8130 W. 159TH STREET
 ORLAND PARK, ILLINOIS 60462

PHASING PLAN

DATE: 4-10-15
 SCALE: 1" = 30'
 DRAWN: SMN
 CHECK: JLG
 JOB: CEI4145
 SHEET:

C-2.1

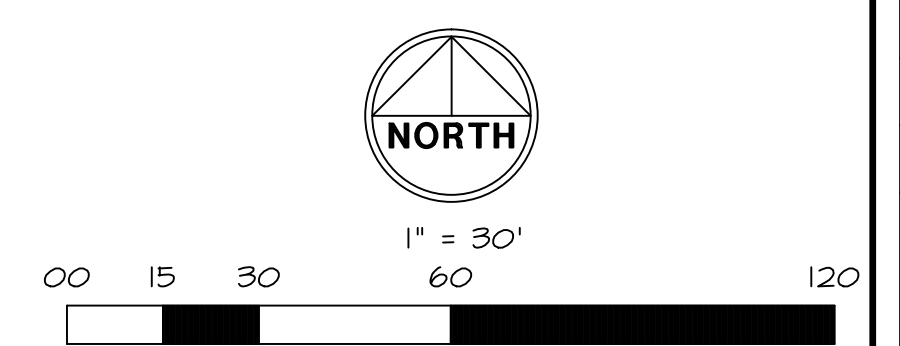

BOARD APPROVED


Case No: 2015-0269

Date: 8.3.15

W/Conditions: YES

W/Out Conditions:

VILLAGE OF ORLAND PARK

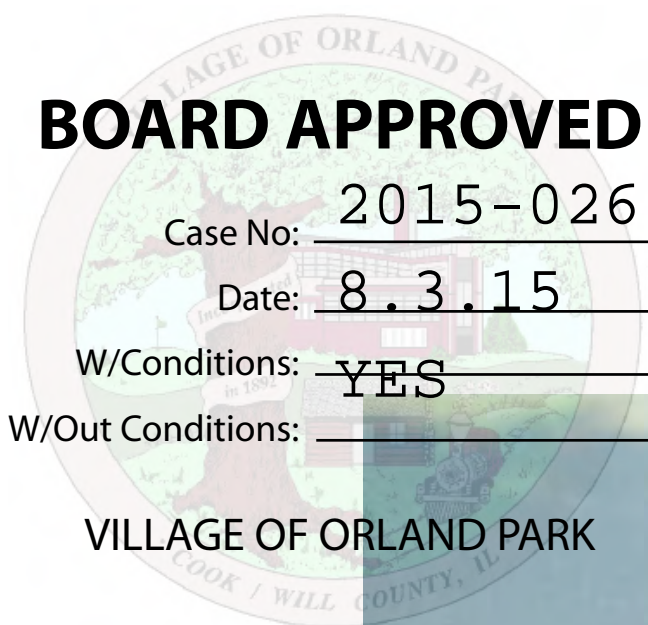

PROJECT:

JOE RIZZA



Porsche Orland Park
8130 W. 159th Street
Orland Park, IL 60462



JOE RIZZA
ACURA

ACURA of Orland Park
8150 W. 159th Street
Orland Park, IL 60462

ARCHITECT:



505 Lake Cook Road, Suite 350
Deerfield, IL 60015

Tel: 847-571-3814
design@simon-arch.com

Civil Eng:

W-T Engineering

2675 Pratum Ave
Hoffman Estates, IL 60192

Tel: 224-293-6333
Fax: 224-293-6444
Contact: Jon Grywa
Em: Jon.Grywa@wtengineering.com

APRIL 10, 2015 - PLANNING REVIEW

MAY 15, 2015 - DESIGN REVIEW

JUNE 29, 2015 - PLANNING REVIEW RESUBMIT

JULY 27, 2015 - BOARD REVIEW

EXTERIOR RENDERING -
PORSCHE

EXTERIOR RENDERING - PORSCHE

SCALE: 1/8" = 1' - 0"

01

A6.00

BOARD APPROVED

Case No: 2015-0269

Date: 8.3.15


W/Conditions: YES

W/Out Conditions:

VILLAGE OF ORLAND PARK

TOP/NEW GLAZING
ELEV. =8'-0" AFF


TOP/EXIST. SLAB
ELEV. =8'-0" AFF

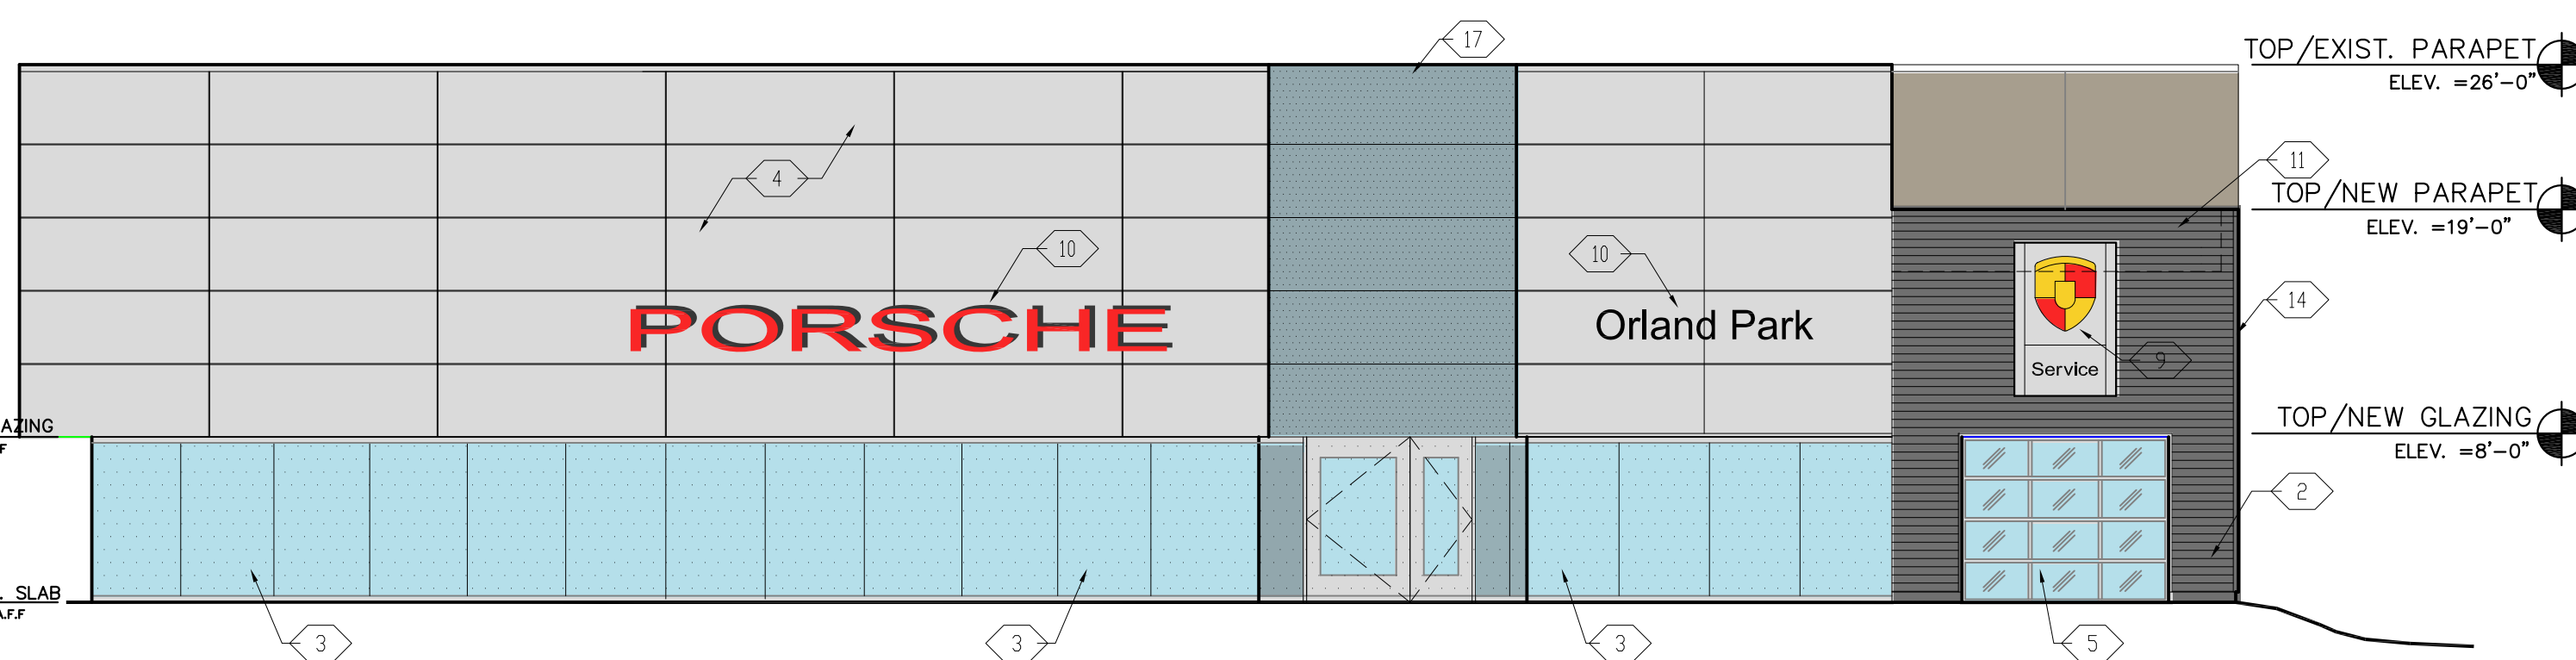

EXTERIOR ELEVATION - SOUTH

SCALE: 1/8"


1

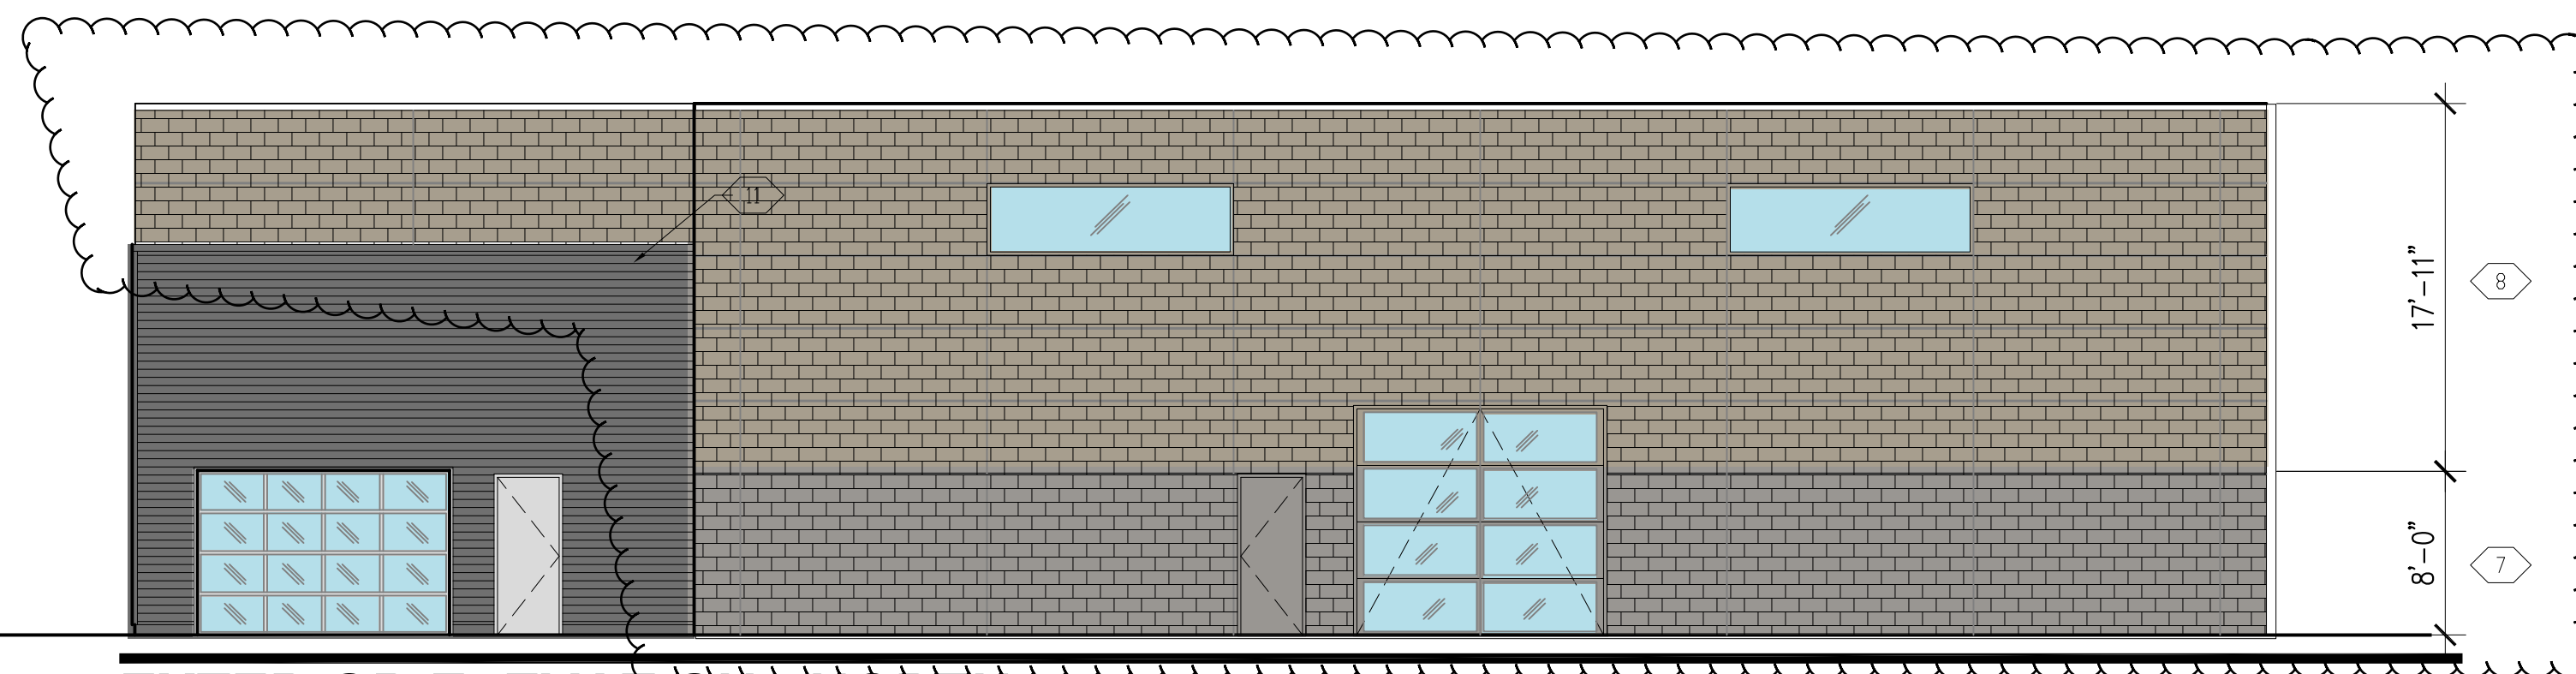

EXTERIOR ELEVATION - NORTH

SCALE: 1/8"


2

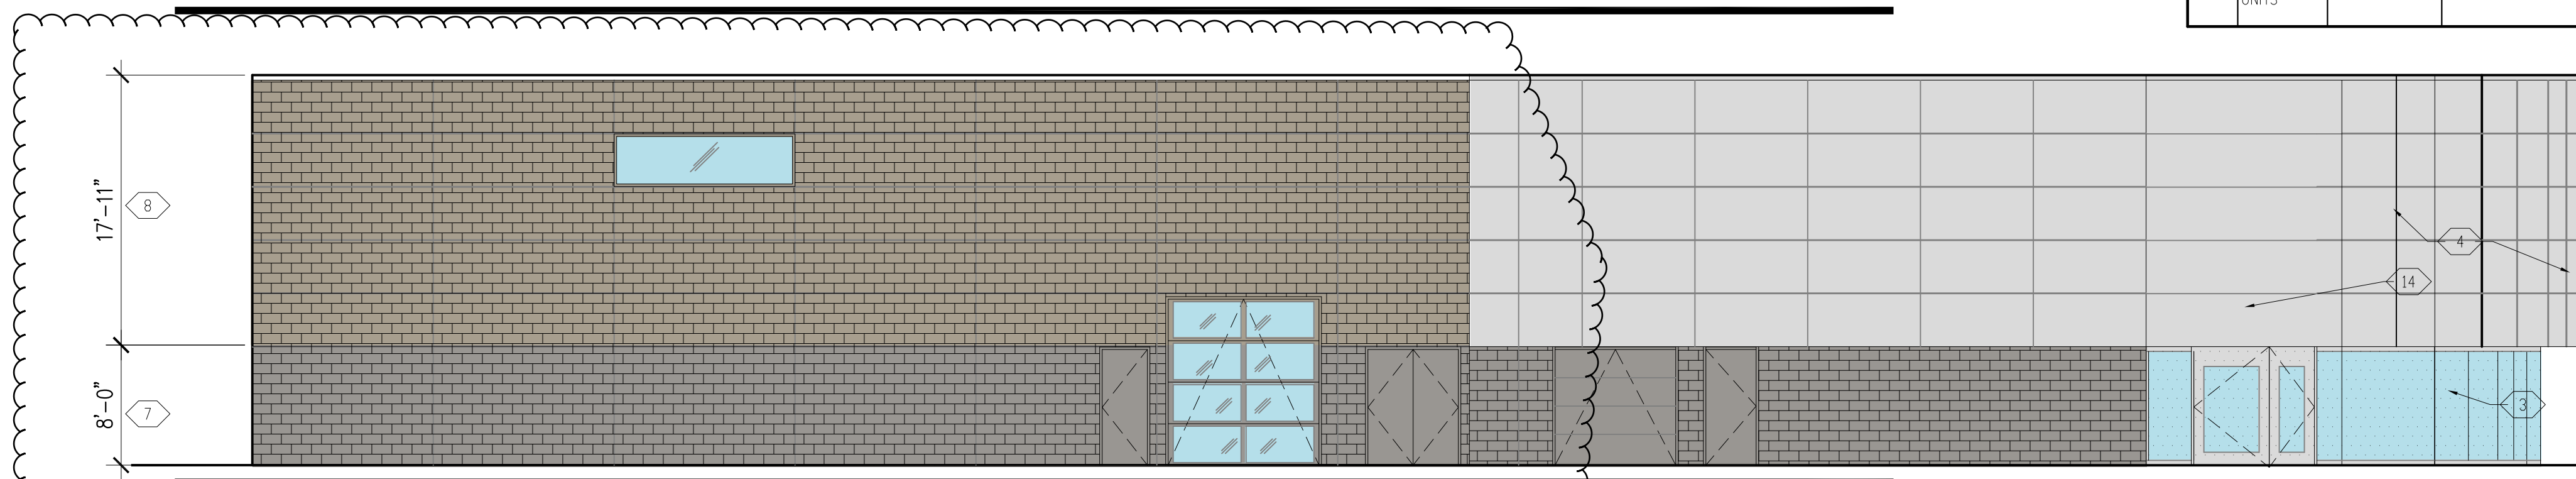

EXTERIOR ELEVATION - WEST

SCALE: 1/8"

3

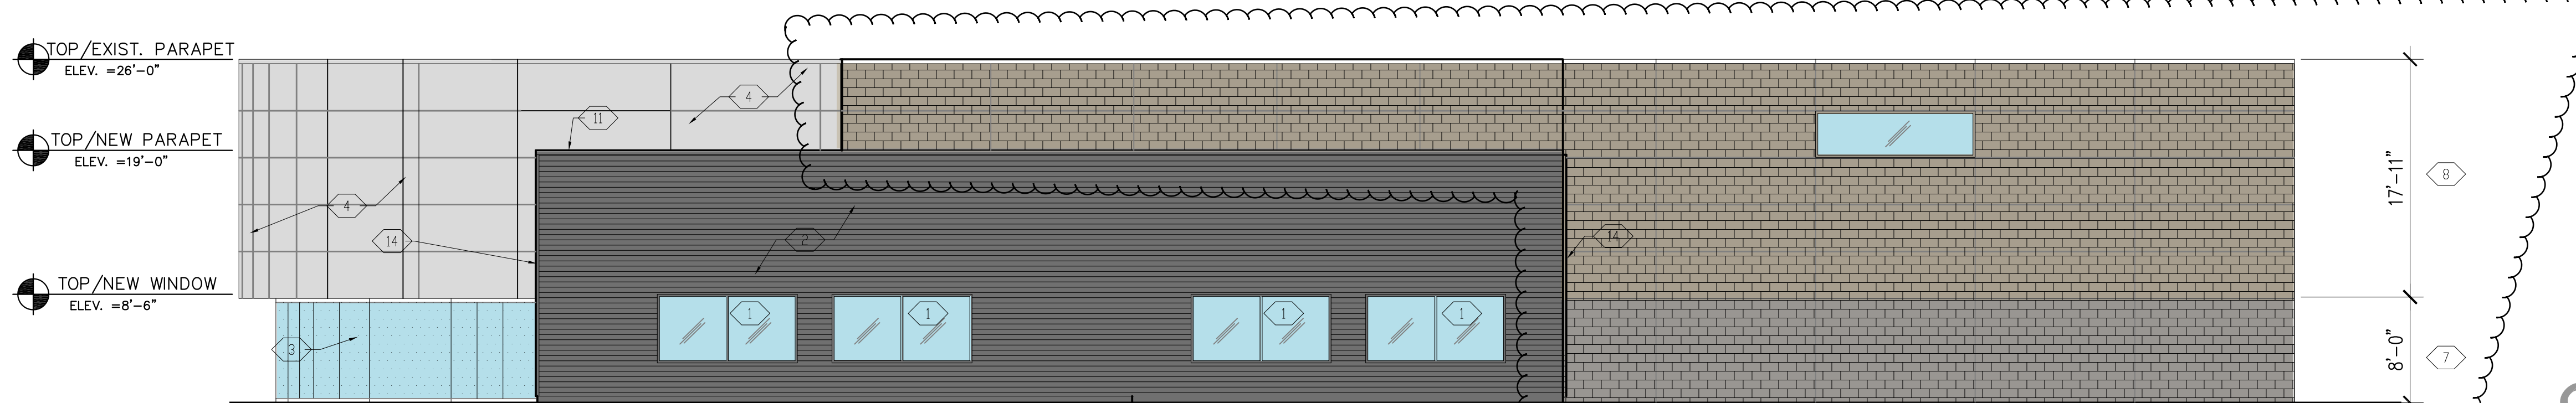

EXTERIOR ELEVATION - EAST

SCALE: 1/8"

4

ELEVATION KEY NOTES:

1	BLACK ANODIZED ALUMINUM WINDOW. SEE SCH1.
2	MP1. TRAPEZIUM SHEET METAL. 0.8MM, SYMMETRICAL, CORRUGATED, ENAMELED, W/ MATTE BLACK FINISH.
3	EXTERIOR BUTT-JOINT GLAZING FROM FINISHED FLOOR TO 8'-0" A.F.F. SEE A10 AND SCH1 FOR MORE INFO.
4	EXISTING METAL PANELS TO REMAIN
5	10'-0" X 8'-0" POWER OPERATED BLACK ANODIZED ALUMINUM OVERHEAD SECTIONAL GARAGE DOOR WITH GLAZING. MOUNT CONTROL WHERE SWITCH IS INDICATED. SEE SCH1 FOR MORE INFORMATION.
6	8'-0" X 8'-0" BLACK ANODIZED ALUMINUM ENTRY DOOR. SEE SCH1 FOR MORE INFORMATION.
7	GROUND CMU-1 TO MATCH ADJACENT/EXISTING (GREY)
8	SPLIT FACE CMU-2 TO MATCH ADJACENT/EXISTING (SANDY BEIGE)
9	SIGNAGE TO BE FURNISHED AND INSTALLED BY OTHERS - PROVIDE POWER, SEE ELECTRICAL DRAWINGS.
10	SIGNAGE BY SIGN VENDOR (TO BE SUBMITTED BY VENDOR)
11	METAL COPING - COLOR TO MATCH TRAPEZIUM SHEET METAL
12	EXISTING OVERHEAD GARAGE DOORS
13	POWER WASH EXISTING GROUND FACE CMU PRIOR TO PAINTING. SEE A40 FOR PAINT INFORMATION.
14	METAL CORNER TRIM BY METAL PANEL MANUFACTURER. COLOR AND FINISH TO MATCH TRAPEZIUM METAL PANELS
17	BUTT GLAZED WITH BLACK MULLIONS, WITH DARK-TINTED GLAZING

EXTERIOR MATERIAL SCHEDULE

ID	DESCRIPTION	MANUFACTURER	SPECIFICATION	SOURCE/CONTACT	REMARKS/ADDL' INFO.
MP1	TRAPEZIUM MTL PANELS	ATAS INTERNATIONAL	TRAPEZIUM SHEET METAL 0.8MM, SYMMETRICAL, CORRUGATED, ENAMELED, W/ MATTE BLACK FINISH, SMOOTH TEXTURE	MARK BROWN AT ATAS INTERNATIONAL (800) 468-1441 X227	PROVIDE CORNER, TRIM AND ANY OTHER MTL ACCESSORIES AND FLASHINGS AS NECESSARY TO ACHIEVE UNEXPOSED EDGES AT CORNERS, WINDOW & DOOR OPENINGS, ETC. FINISH TO MATCH PANELS.
GFM-1	GROUND FACE MASONRY UNITS	TRENWYTH	MESASTONE COLOR: HAYDITE	TRENWYTH (630) 894-1629	PROVIDE SAMPLE FOR APPROVAL, TO MATCH EXISTING.
GFM-2	GROUND FACE MASONRY UNITS	TRENWYTH	TRENDSTONE PLUS COLOR: HAYDITE	TRENWYTH (630) 894-1629	PROVIDE SAMPLE FOR APPROVAL, TO MATCH EXISTING.

TOP/EXIST. PARAPET
ELEV. =26'-0"

TOP/NEW PARAPET
ELEV. =19'-0"

TOP/NEW WINDOW
ELEV. =8'-6"

PROJECT:

JOE RIZZA



Porsche Orland Park
8130 W. 159th Street
Orland Park, IL 60462

ARCHITECT:



505 Lake Cook Road, Suite 350
Deerfield, IL 60015

Tel: 847-571-3814
design@simon-arch.com

JULY 22, 2015 - DESIGN REVIEW

JULY 27, 2015 - BOARD REVIEW

EXT.ELEVATIONS

A06.01

©2015 SIMON ARCH, LLC

NOTE: 11X17 IS HALF SCALE

BOARD APPROVED


Case No: 2015-0269

Date: 8.3.15

W/Conditions: YES

W/Out Conditions:

VILLAGE OF ORLAND PARK

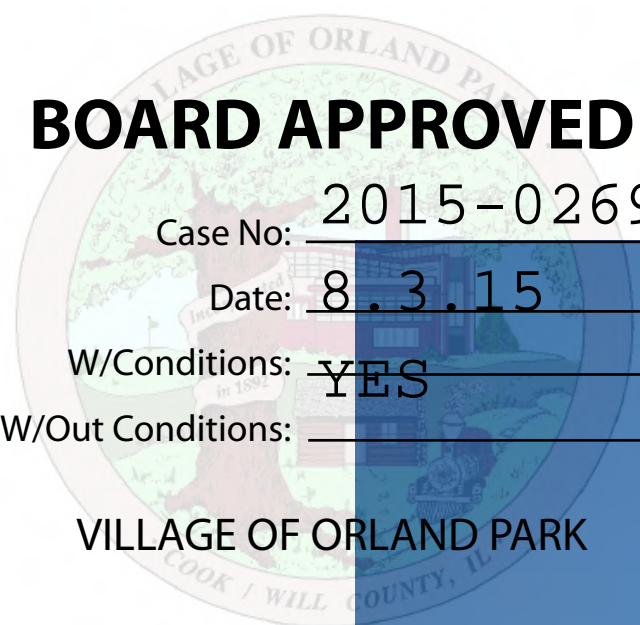

PROJECT:

JOE RIZZA



JOE RIZZA
ACURA

Porsche Orland Park
8130 W. 159th Street
Orland Park, IL 60462

ACURA of Orland Park
8150 W. 159th Street
Orland Park, IL 60462

ARCHITECT:



505 Lake Cook Road, Suite 350
Deerfield, IL 60015

Tel: 847-571-3814
design@simon-arch.com

Civil Eng:

W-T Engineering

2675 Pratum Ave
Hoffman Estates, IL 60192

Tel: 224-293-6333
Fax: 224-293-6444
Contact: Jon Grywa
Em: Jon.Grywa@wtengineering.com

APRIL 10, 2015 - PLANNING REVIEW

MAY 15, 2015 - DESIGN REVIEW

JUNE 29, 2015 - PLANNING REVIEW RESUBMIT

JULY 27, 2015 - BOARD REVIEW

ISSUED FOR PRELIM SITE PLAN REVIEW - APRIL 10, 2015

EXTERIOR RENDERING -
ACURA

01

EXTERIOR RENDER - ACURA
SCALE: -

A6.10

BOARD APPROVED

Case No: 2015-0269
 Date: 8.3.15
 W/Conditions: YES
 W/Out Conditions:


VILLAGE OF ORLAND PARK

SIGN TO BE SUBMITTED BY VENDOR

EG-2

SIGN TO BE SUBMITTED BY ACURA VENDOR

EG-1

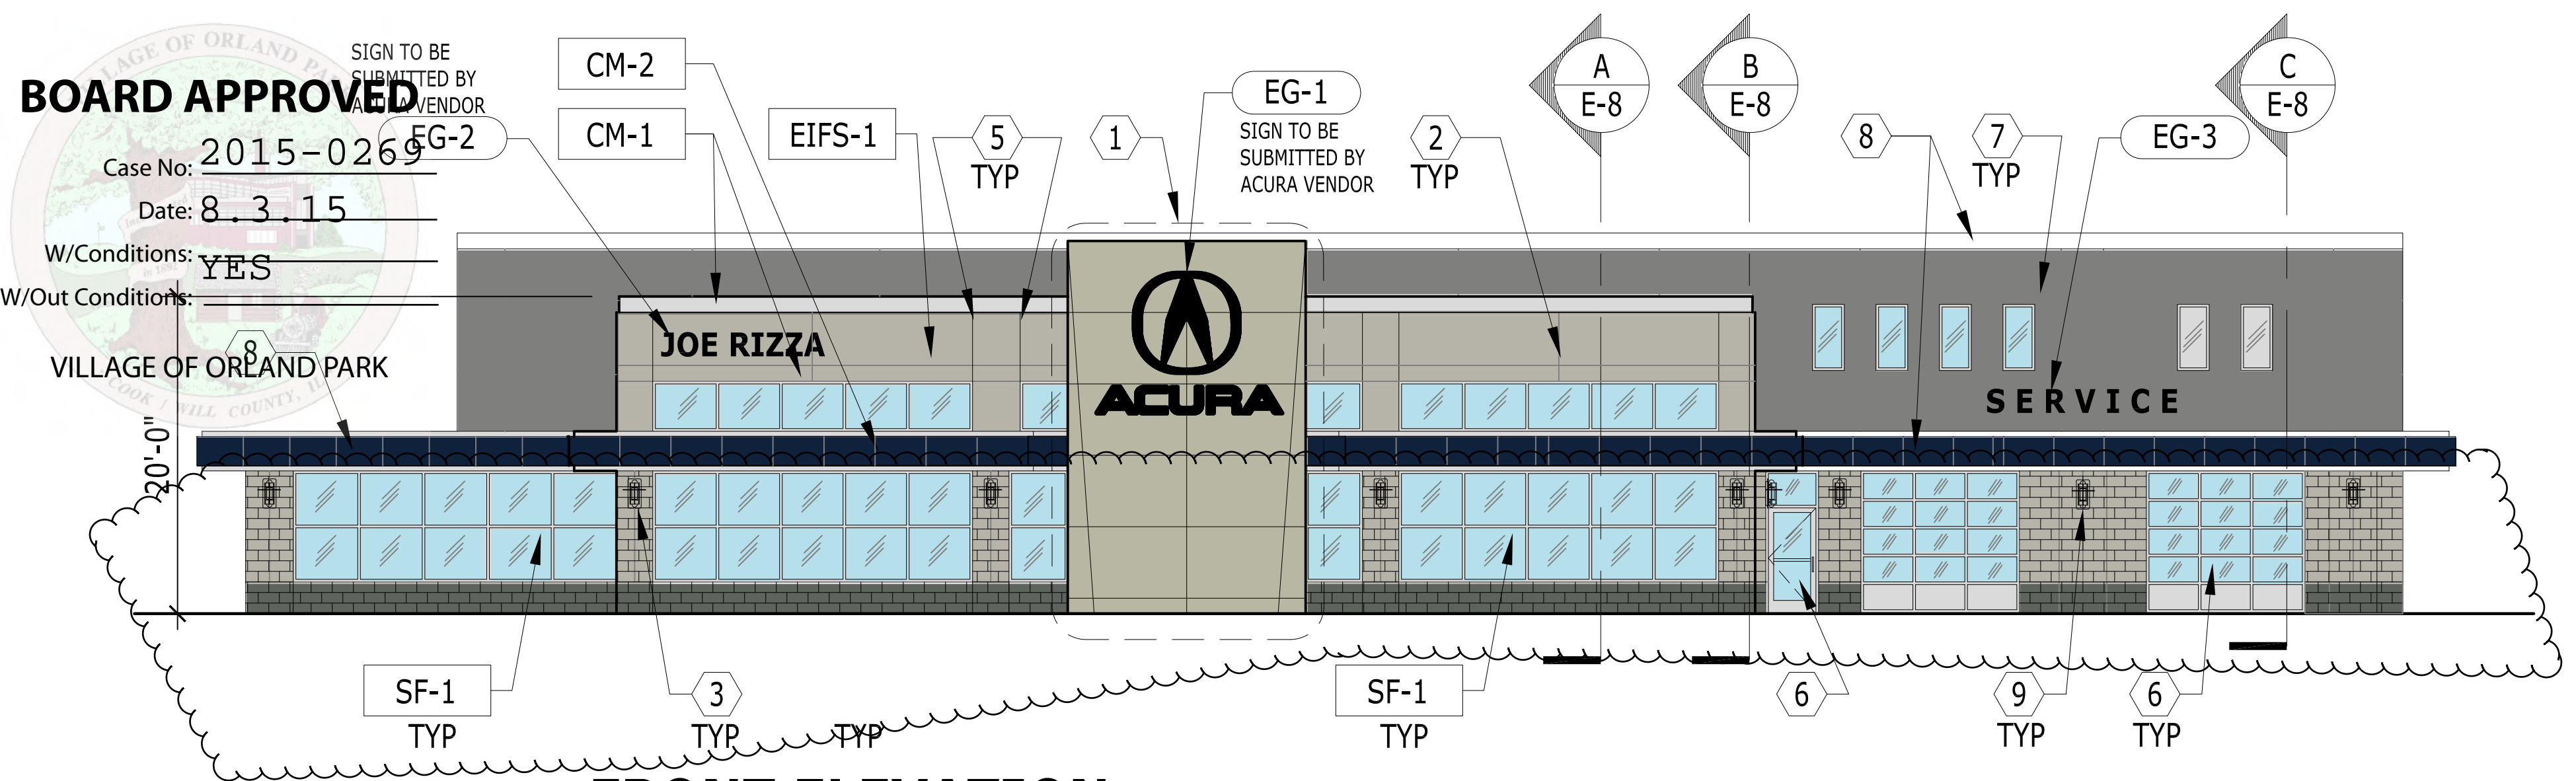


1 FRONT ELEVATION
E-7

GENERAL NOTES


- A. ELEVATIONS NOT SHOWN SHALL RECEIVE SAME OR COMPLEMENTARY FINISHES TO MATERIALS SHOWN.
- B. SEE LIGHT FIXTURE SCHEDULE FOR EXTERIOR LIGHTING DESCRIPTION.

DRAWING NOTES

1. ENTRY ICON. SEE SHEET E-9 FOR MORE INFORMATION.
2. EIFS REVEAL JOINT - SEE DETAIL E/E-8
3. EXTERIOR LIGHTING FIXTURE. SEE LIGHTING SCHEDULE FOR DESCRIPTION.
4. VEHICLE ACCESS DOORS (1) TO BE 5'-0" W X 7'-0" H THE OTHER TO BE 3'-0" W X 7'-0" H
5. EIFS REVEAL JOINT - SEE DETAIL D/E-8.
6. EXISTING DOOR.
7. CLEAN EXISTING EIFS. PATCH AND REPAIR AS REQUIRED AND REAPPLY EIFS PER ORIGINAL SPECIFICATIONS.
8. CLEAN AND REFURBISH EXISTING ACM PANELS TO ORIGINAL CONDITION.
9. CLEAN EXISTING LIGHTS. SEE LIGHTING SCHEDULE FOR ADDITIONAL INFORMATION.
10. EXISTING WINDOW.
11. PAINTED FACE BRICK. COLOR TO MATCH EIFS-2 BELOW SILL, EIFS -1 ABOVE SILL

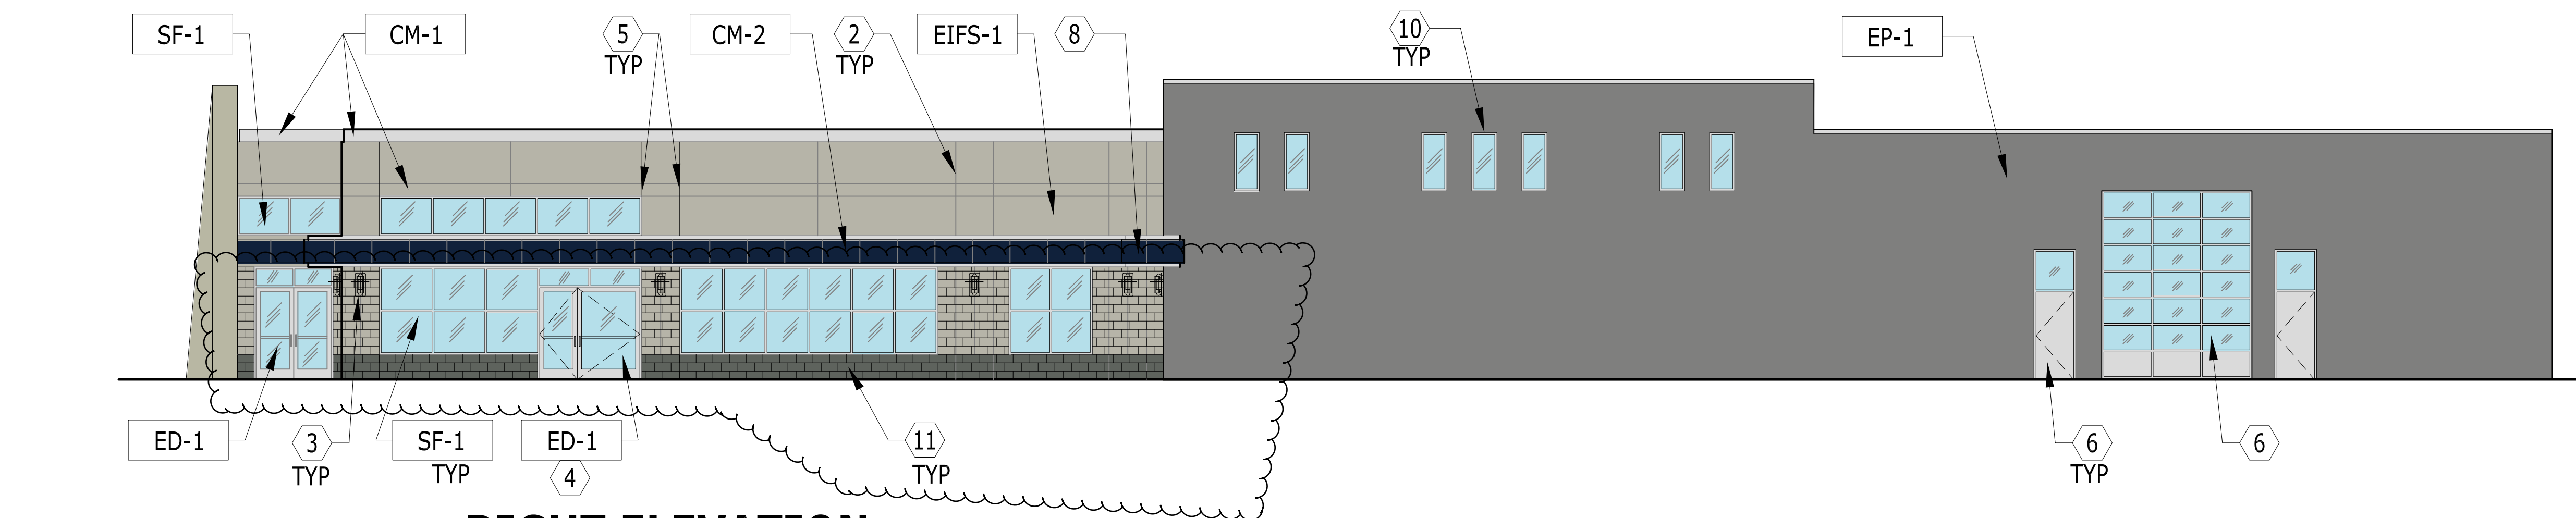

2 RIGHT ELEVATION
E-7

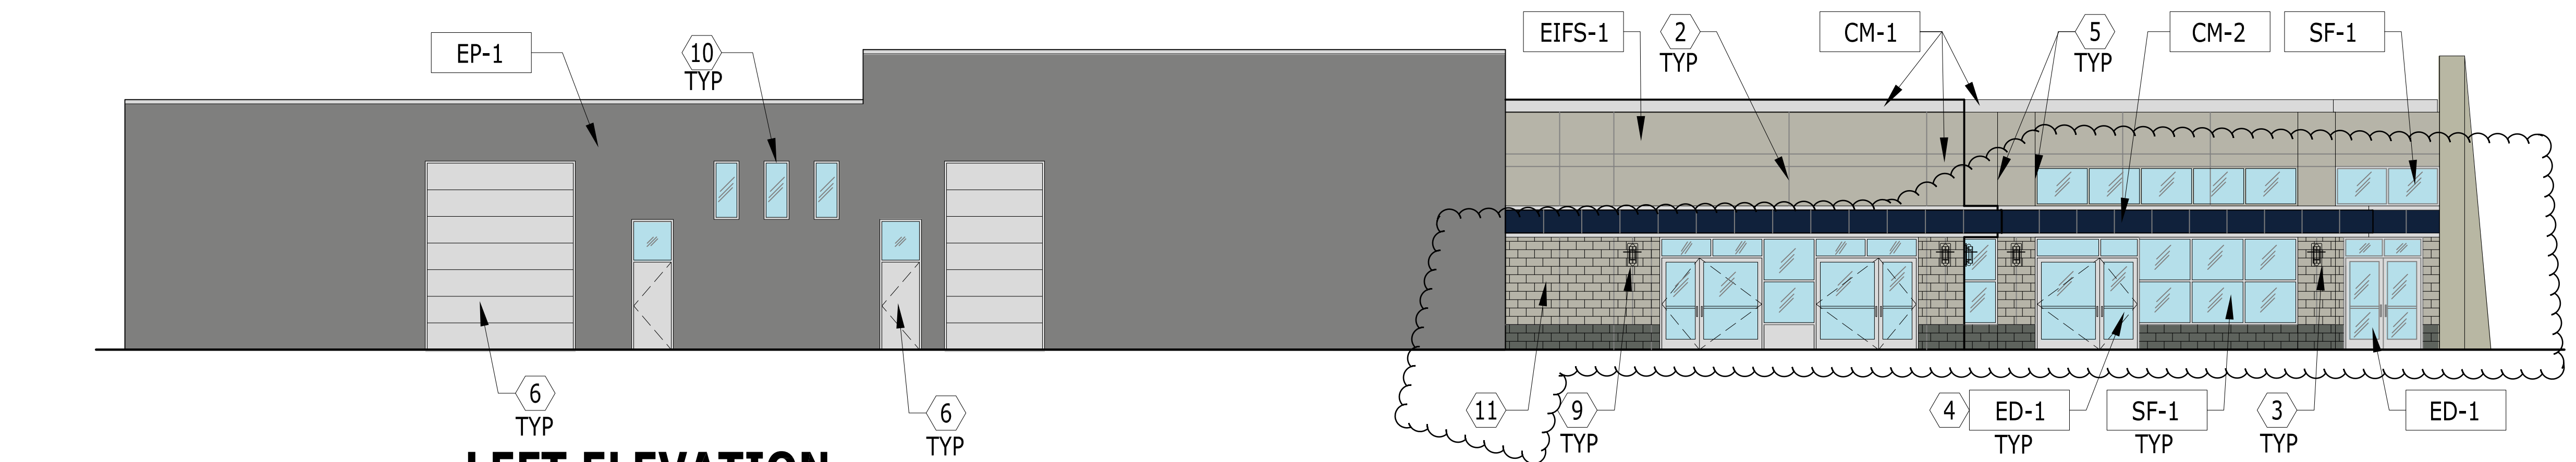

3 LEFT ELEVATION
E-7

PROJECT:


JOE RIZZA



Porsche Orland Park
8130 W. 159th Street
Orland Park, IL 60462

ACURA of Orland Park
8150 W. 159th Street
Orland Park, IL 60462

ARCHITECT:

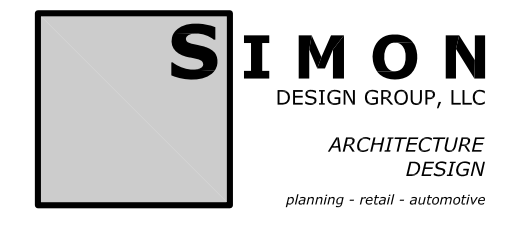

505 Lake Cook Road, Suite 350
Deerfield, IL 60015

Tel: 847-571-3814
design@simon-arch.com

Civil Eng:

W-T Engineering

2675 Pratum Ave
Hoffman Estates, IL 60192


Tel: 224-293-6333
Fax: 224-293-6444
Contact: Jon Grywa
Em: Jon.Grzywa@wtengineering.com

APRIL 10, 2015 - PLANNING REVIEW
 MAY 15, 2015 - DESIGN REVIEW
 JUNE 29, 2015 - PLANNING REVIEW RESUBMIT
 JULY 27, 2015 - BOARD REVIEW
 ISSUED FOR PRELIM SITE PLAN REVIEW - APRIL 10, 2015

EXT ELEV - ACURA

A6.11

©2015 SIMON ARCH, LLC

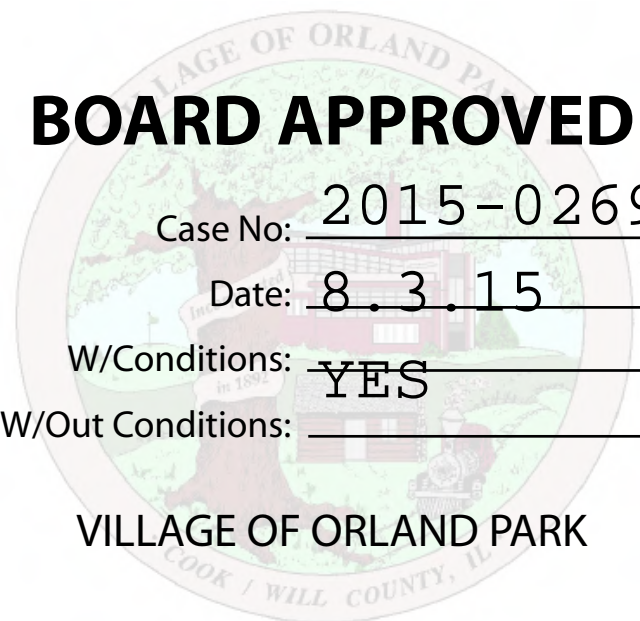

CODE	ITEM	LOCATION	MANUFACTURER	DESCRIPTION			ADDITIONAL INFORMATION
				SERIES	COLOR	DIMENSIONS	
BP-1	BRICK BRICK PAVERS	EXTERIOR ENTRANCE/ MAIN ENTRANCE	HANOVER ARCHITECTURAL PRODUCTS, INC.	TRADITIONAL PREST	LIMESTONE GREY	12"x12"	CONTACT: HANOVER ARCHITECTURAL (717) 637-0500
CM-1	COMPOSITE METAL PANEL OPTION 1	EXTERIOR FACADE	ALUCOBOND	PE STOCKING COLORS	CHAMPAGNE METALLIC	SEE ELEVATIONS	CONTACT: MIKE CALDWELL AT ALUCOBOND (770) 982-5822 OR (470) 554-2651
	COMPOSITE METAL PANEL OPTION 2	EXTERIOR FACADE	REYNOBOND	COLORWELD 500 XL	CHAMPAGNE METALLIC	SEE ELEVATIONS	CONTACT: DUTCH JUEDEMAN AT REYNOBOND (478) 319-0139 OR (770) 695-0973
	COMPOSITE METAL PANEL OPTION 3	EXTERIOR FACADE	ALPOLIC		4MM4CMX3.5 MTLIC CHMPGN	SEE ELEVATIONS	CONTACT: DAVID J. KEARNEY AT ALPOLIC (757) 382-5724 OR (757) 286-1005
CM-2	COMPOSITE METAL PANEL OPTION 1	EXTERIOR FACADE	ALUCOBOND		BN3L121B DURANAR XL SPIRE BLUE II 10570 WITH 614C3030	SEE ELEVATIONS	CONTACT: MIKE CALDWELL AT ALUCOBOND (770) 982-5822 OR (470) 554-2651
	COMPOSITE METAL PANEL OPTION 2	EXTERIOR FACADE	REYNOBOND		MIDNIGHT BLUE COLOR: TO MATCH PMS 282C	SEE ELEVATIONS	CONTACT: DUTCH JUEDEMAN AT REYNOBOND (478) 319-0139 OR (770) 695-0973
	COMPOSITE METAL PANEL OPTION 3	EXTERIOR FACADE	ALPOLIC		4MM4AUB3.5, AUB BLUE COLOR: TO MATCH PMS 282C	SEE ELEVATIONS	CONTACT: DAVID J. KEARNEY AT ALPOLIC (757) 382-5724 OR (757) 286-1005
CONC-1	CONCRETE	EXTERIOR FACADE	SCOFIELD SYSTEMS	LITHOCHROME COLOR HARDENER	A-21 DEEP CHARCOAL		CONTACT: ROBERT E. KRAUSKOPF AT L.M. SCOFIELD COMPANY (800) 800-9900 NOTE: CONTACT MANUFACTURER TO OBTAIN RECOMMENDED CURING AGENT & SEALER FOR APPLICATION
CONC-2	CONCRETE	EXTERIOR FACADE	SCOFIELD SYSTEMS	LITHOCHROME COLOR HARDENER	A-26 BRICK RED		
CT-1	CERAMIC TILE	FOUNTAIN WALLS	BUCHTAL	CHROMA 2	539 MEDIUM GRAY	8 X 8	CONTACT: LORI RING AT HAMILTON PARKER (614) 778-1491
*ED-1	STOREFRONT DOOR		KAWNEER OR EQUAL	NARROW STILE	COLOR TO MATCH CM-1		
ED-2	HOLLOW METAL DOOR	SEE A3.01	REF: DOOR SCHEDULE		EXTERIOR FINISH: PAINT EP-1 INTERIOR FINISH: PAINT P-1, SEE INTERIOR SCHEDULE		
ED-3	OVERHEAD DOOR	SEE A3.01	REF: DOOR SCHEDULE		PAINT EP-1	* SIZE VARIES	CONSULT DEALER FOR REQUIRED SIZE
ED-4	PARTS OVERHEAD DOOR	SEE A3.01	REF: DOOR SCHEDULE			8 X 10H	
ED-5	GLASS AND ALUMINUM OVERHEAD DOOR	SERVICE & RECEPTION	KAWNEER OR EQUAL		MULLIONS TO MATCH SF-1	REFER TO DOOR SCH	
EIFS-1	EXTERIOR INSULATING FINISH SYSTEM ON 2" INSULATION ON DRAINAGE MAT	FIELD/EXTERIOR WALLS	DRYVIT	AMERISTONE	AHC011100 WHITE ASH		CONTACT: BOB DAZEL AT DRYVIT NATIONAL ACCOUNTS (734) 276-0404
EIFS-2	EXTERIOR INSULATING FINISH SYSTEM ON 2" INSULATION ON DRAINAGE MAT	BASE BAND, EXTERIOR WALLS	DRYVIT	QUARZPUTZ	AHC021020 KING'S GRAY		CONTACT: BOB DAZEL AT DRYVIT NATIONAL ACCOUNTS (734) 276-0404 *NOTE: MINOR COLOR VARIANTS WILL OCCUR DUE TO THE NATURAL AGGREGATES USED. FINAL SELECTION TO BE MADE FROM CONTRACTOR-SUBMITTED SAMPLES. ALLOW 3 TO 6 WEEK LEADTIME.
*EP-1	EXTERIOR PAINT	SEE SHEET A3.01	SHERWIN WILLIAMS		SW-1015 SKYLINE STEEL		CONTACT: DAVE RYAN (317) 714-5610 NOTE: CONSULT MANUFACTURER FOR APPROPRIATE PRIMER AND GRADE OF PAINT FOR THE APPLICABLE SUBSTRATE.
MC-1	METAL COPING		BY ARCHITECT OF RECORD		COLOR AND FINISH TO MATCH CM-1		
SF-1	STOREFRONT	SHOWROOM AREA	OLD CASTLE OR EQUAL	OLD CASTLE FG 3000 SYSTEM	CHAMPAIGN MULLION COLOR TO MATCH CM-1		INSULATED STOREFRONT SYSTEM - 2X4.5 CENTERSET MULLIONS, LOW-E ON 3RD FACE.

PROJECT:

JOE RIZZA

Porsche Orland Park
8130 W. 159th Street
Orland Park, IL 60462

ACURA of Orland Park
8150 W. 159th Street
Orland Park, IL 60462

ARCHITECT:

SIMON
DESIGN GROUP, LLC
ARCHITECTURE DESIGN
planning - retail - automotive

505 Lake Cook Road, Suite 350
Deerfield, IL 60015

Tel: 847-571-3814
design@simon-arch.com

Civil Eng:

W-T Engineering

2675 Pratum Ave
Hoffman Estates, IL 60192

Tel: 224-293-6333
Fax: 224-293-6444
Contact: Jon Grywa
Em: Jon.Grywa@wtengineering.com

APRIL 10, 2015 - PLANNING REVIEW
MAY 15, 2015 - DESIGN REVIEW
JUNE 29, 2015 - PLANNING REVIEW RESUBMIT
JULY 27, 2015 - BOARD REVIEW
ISSUED FOR PRELIM SITE PLAN REVIEW - APRIL 10, 2015


EXT MATERIAL SCHEDULE - ACURA

A6.12

©2015 SIMON ARCH, LLC



CT-1 Ceramic Tile,
Fountain Walls

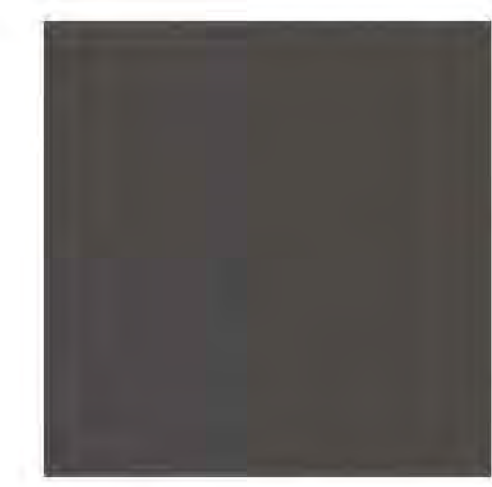

CONC-1 Concrete,
Exterior Facade



CONC-2 Concrete,
Exterior Facade




EP-1 Exterior Paint



CM-1 Composite Metal Panel,
Exterior Facade



CM-2 Composite Metal Panel,
Exterior Facade

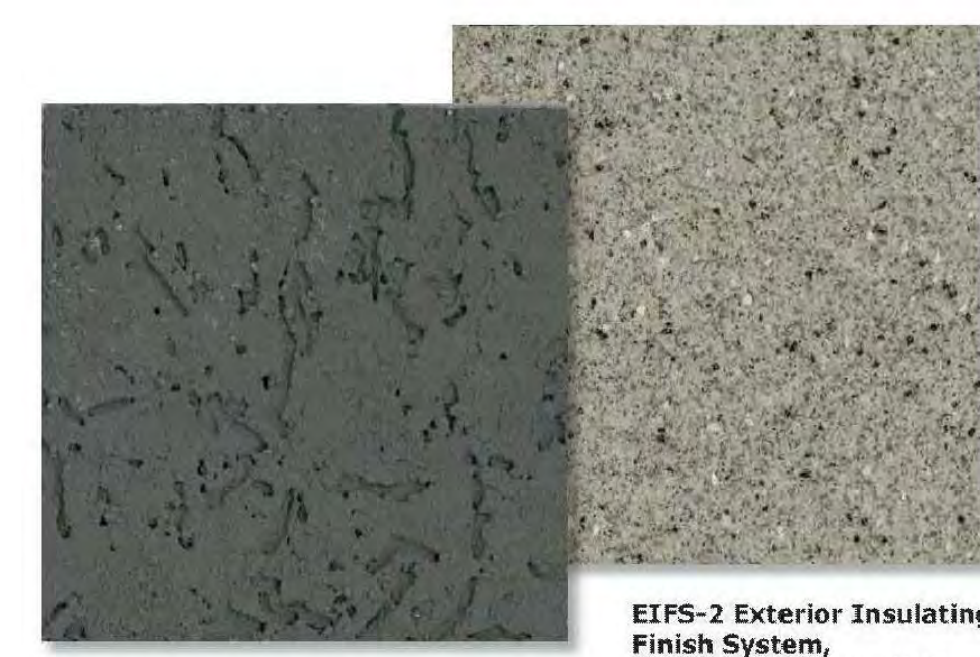

EIFS-1 Exterior Insulating Finish System,
Field/Exterior Walls



EIFS-2 Exterior Insulating Finish System,
Base Band, Exterior Walls