


**LEGEND**

○ HUNTER 4" PRS30 SPRAY HEAD 5H	▶ LEEMCO MANUAL ISOLATION VALVE	Ⓟ BOOSTER PUMP STATION
● HUNTER 4" PRS30 SPRAY HEAD 8H	⊙ HUNTER LRC 1" QUICK COUPLER	Ⓜ FEBCO 825YA BACKFLOW PREVENTER
⊖ HUNTER 4" PRS30 SPRAY HEAD 10H-12H	— LATERAL PIPE	Ⓜ WATER METER (PROVIDED BY CITY)
▬ HUNTER 4" PRS 30 15' STRIP SPRAY HEAD	— 3" PVC CL200 SDR21 MAINLINE PIPE	⊕ BLOW OUT TEE
⊙ HUNTER 12" PRS30 SPRAY	Ⓛ HUNTER ACC-D DECODER CONTROLLER	Ⓧ GROUND ROD
■ HUNTER MP 2000 ROTATOR 4" PRS40	⊙ HUNTER SOLAR SYNC WEATHER SENSOR	
▲ HUNTER MP 1000 ROTATOR 4" PRS40	Ⓜ FLOW SENSOR	
⊕ HUNTER ICV 1.5" ELECTRIC VALVE	Ⓜ MASTER VALVE	
■ HUNTER ICV 1" ELECTRIC VALVE		



**CENTRAL**  
Lawn Sprinklers Inc.  
239 King Street • Elk Grove Village, IL 60007 • Phone: (847) 364-6900 • Fax: (847) 364-9774

**LAGRANGE ROAD IMPROVEMENTS**  
**ORLAND PARK, ILLINOIS**  
Segment 3 - 143rd St to 131st St  
**IRRIGATION AS-BUILT DRAWING**

PROJECT NO.	15780
DESIGNED BY:	KM
DRAWN BY:	KM
CHECKED BY:	JC
DATE:	OCT 25, 2017
SCALE:	1" = 20'
SHEET	1

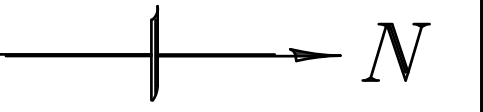

SCALE: 1"=20'-0"

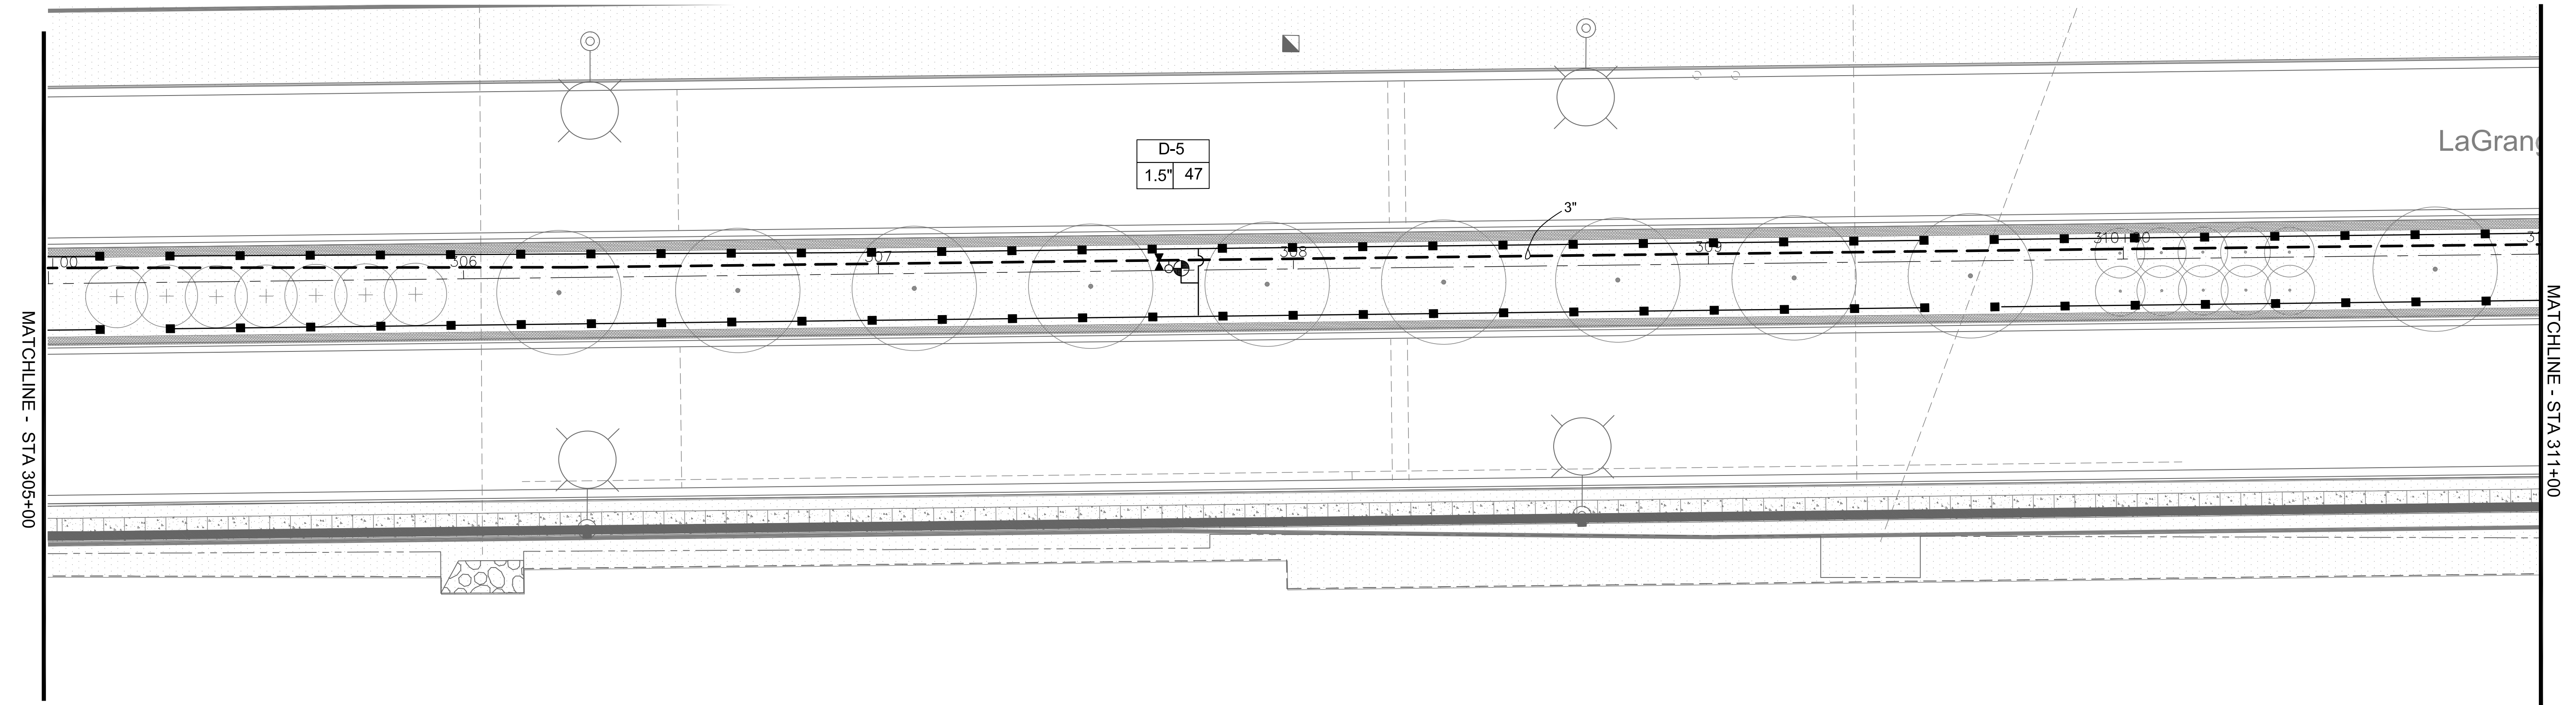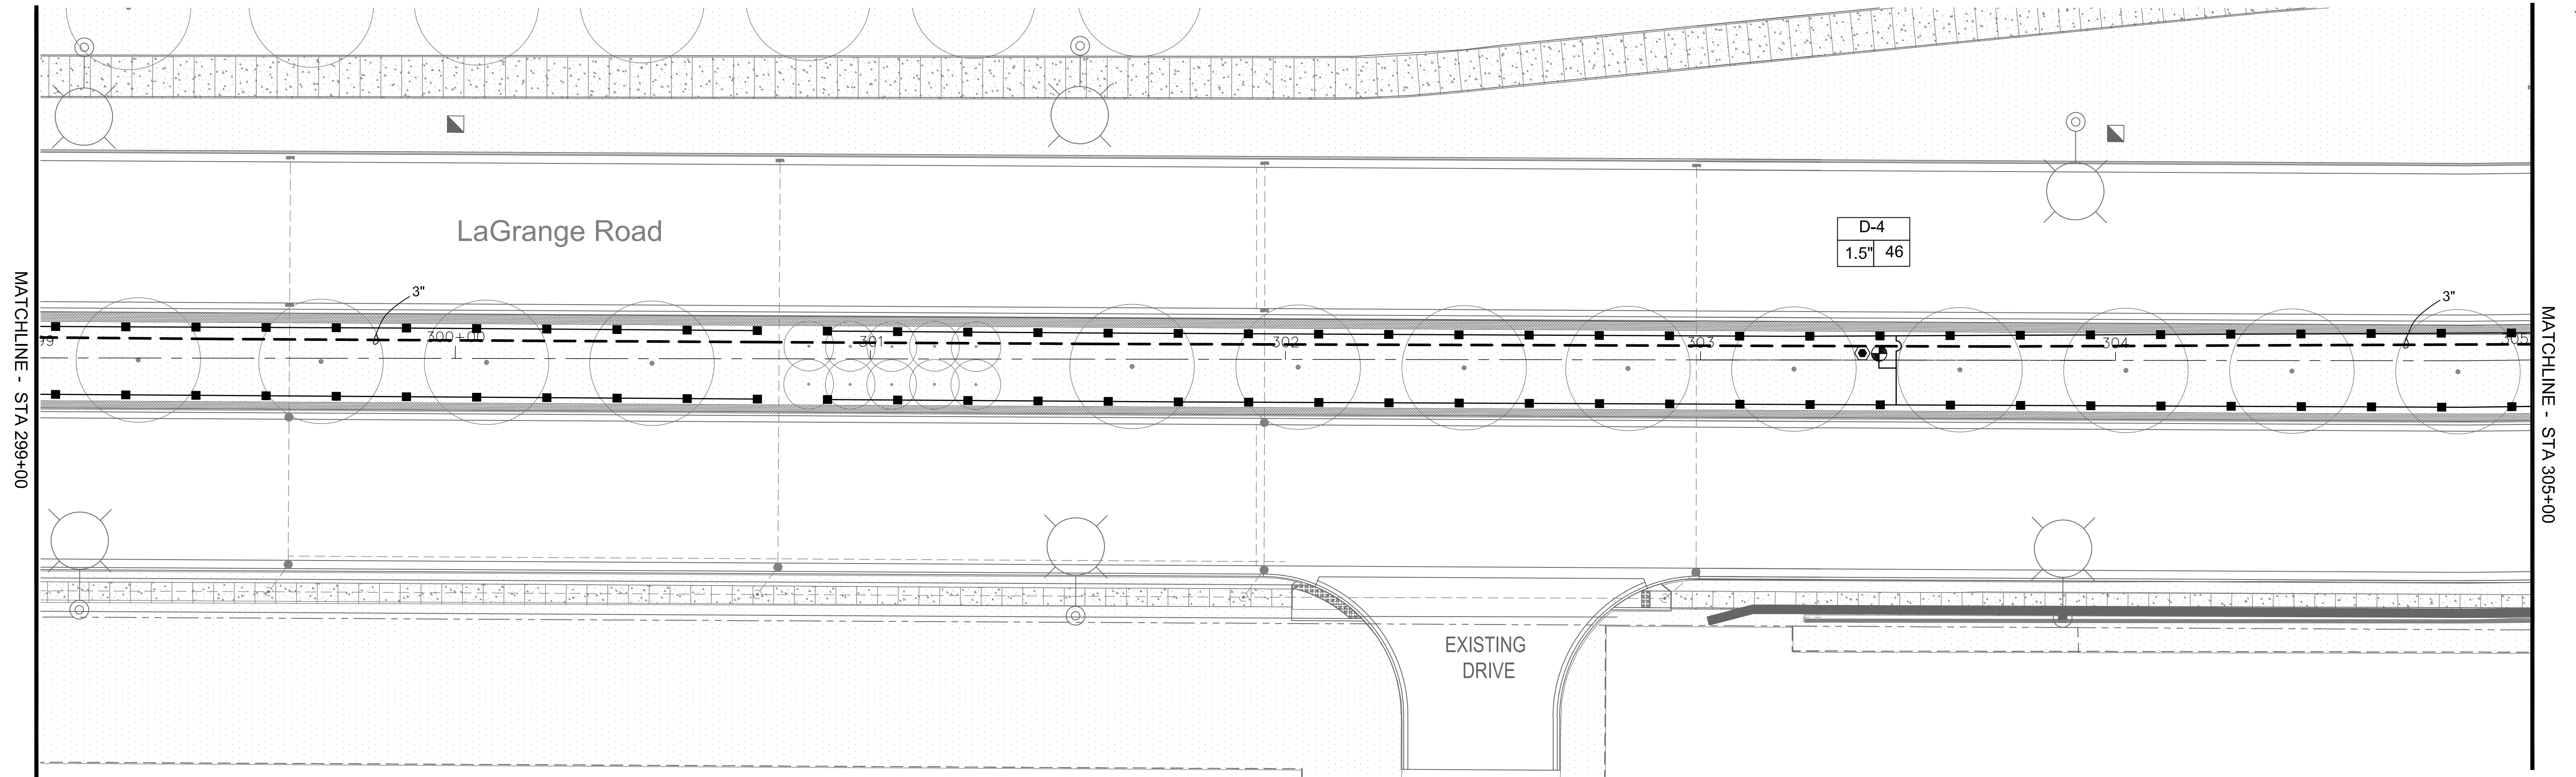

LEGEND



- |   |                                    |                                  |
|---|------------------------------------|----------------------------------|
| ○ HUNTER 4" PRS30 SPRAY HEAD 5H         | ▶ LEEMCO MANUAL ISOLATION VALVE    | Ⓟ BOOSTER PUMP STATION           |
| ● HUNTER 4" PRS30 SPRAY HEAD 8H         | ⊙ HUNTER LRC 1" QUICK COUPLER      | Ⓜ FEBCO 825YA BACKFLOW PREVENTER |
| ⊙ HUNTER 4" PRS30 SPRAY HEAD 10H-12H    | — LATERAL PIPE                     | Ⓜ WATER METER (PROVIDED BY CITY) |
| — HUNTER 4" PRS 30 15' STRIP SPRAY HEAD | — 3" PVC CL200 SDR21 MAINLINE PIPE | ○ BLOW OUT TEE                   |
| ⊙ HUNTER 12" PRS30 SPRAY                | Ⓜ HUNTER ACC-D DECODER CONTROLLER  | Ⓧ GROUND ROD                     |
| ■ HUNTER MP 2000 ROTATOR 4" PRS40       | Ⓜ HUNTER SOLAR SYNC WEATHER SENSOR |                                  |
| ▲ HUNTER MP 1000 ROTATOR 4" PRS40       | Ⓜ FLOW SENSOR                      |                                  |
| ⊕ HUNTER ICV 1.5" ELECTRIC VALVE        | Ⓜ MASTER VALVE                     |                                  |
| ■ HUNTER ICV 1" ELECTRIC VALVE          |                                    |                                  |

**CENTRAL**  
Lawn Sprinklers Inc.

239 King Street • Elk Grove Village, IL 60007 • Phone: (847) 364-6900 • Fax: (847) 364-9774

**LAGRANGE ROAD IMPROVEMENTS**  
**ORLAND PARK, ILLINOIS**  
Segment 3 - 143rd St to 131st St  
**IRRIGATION AS-BUILT DRAWING**

PROJECT NO.	15780
DESIGNED BY:	KM
DRAWN BY:	KM
CHECKED BY:	JC
DATE:	OCT 25, 2017
SCALE:	1" = 20'
SHEET	2

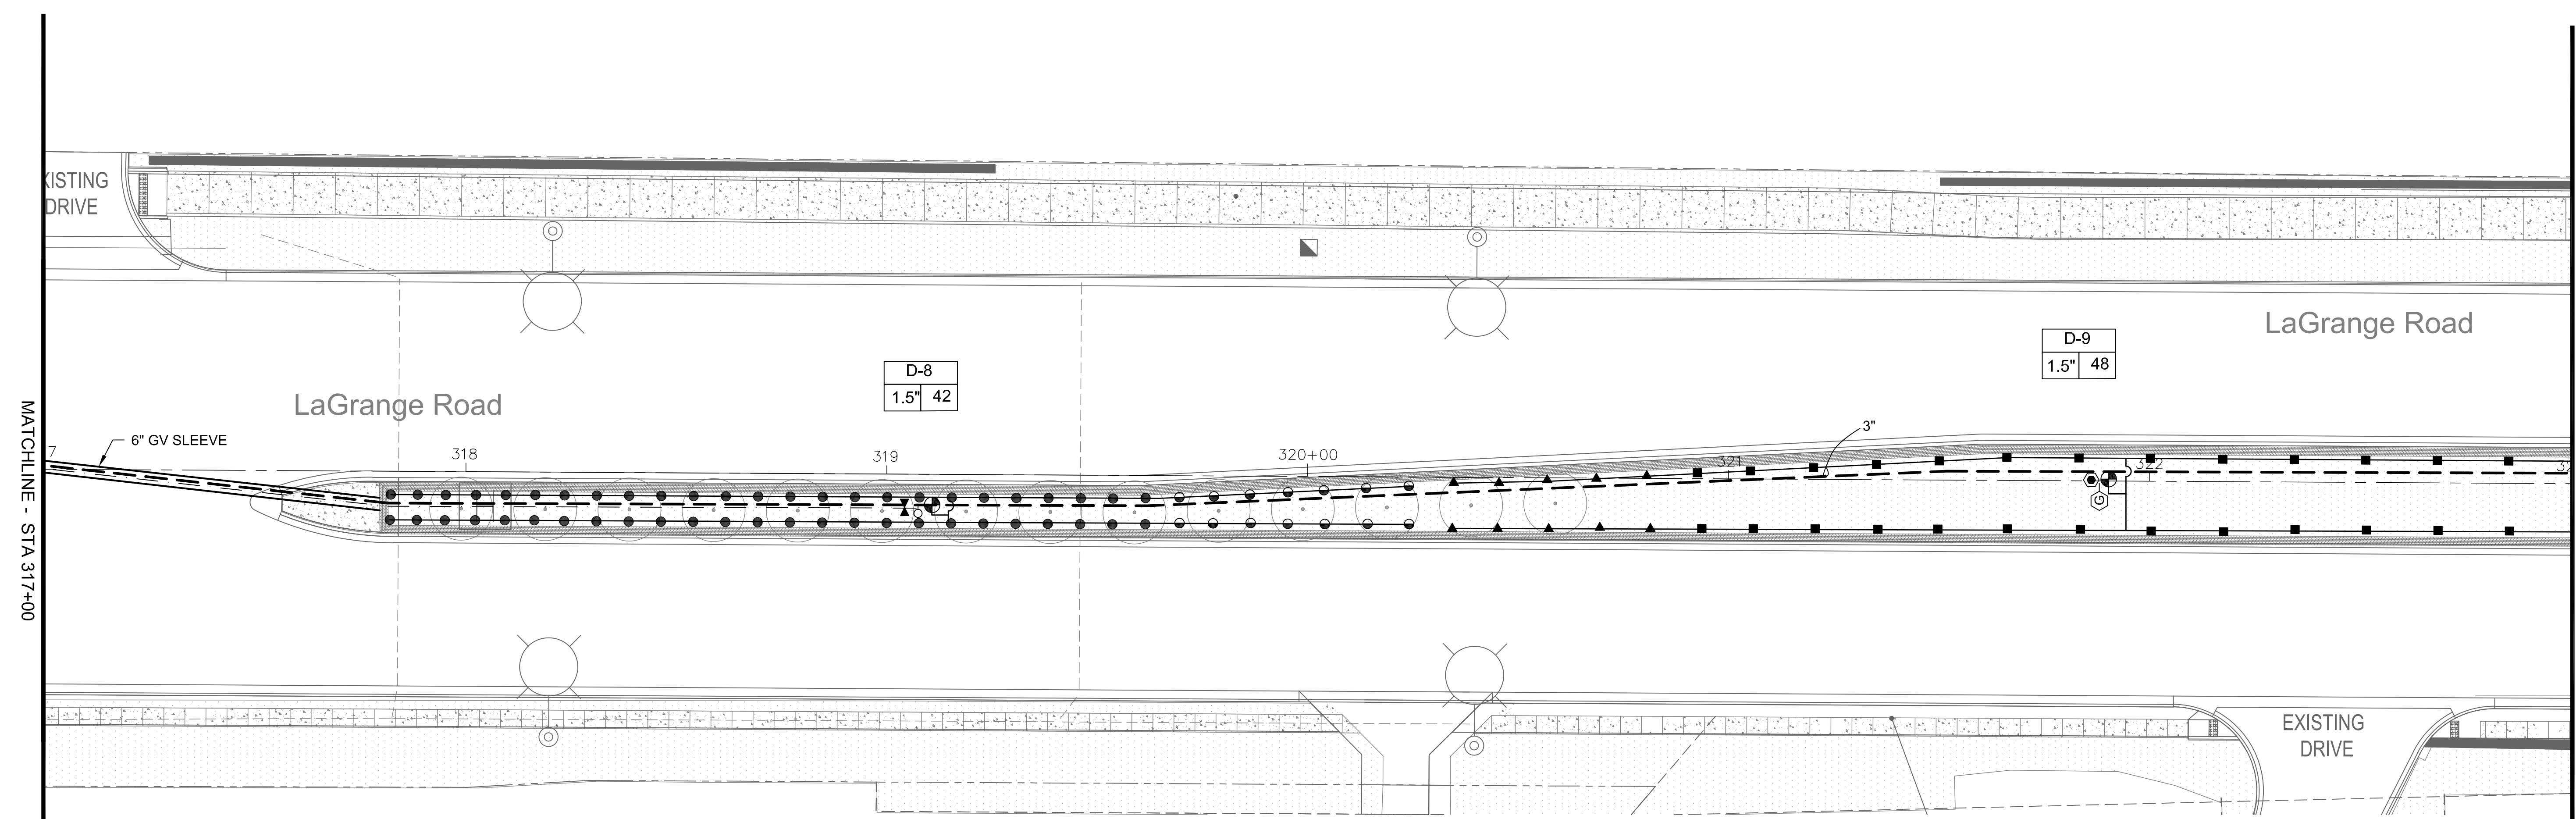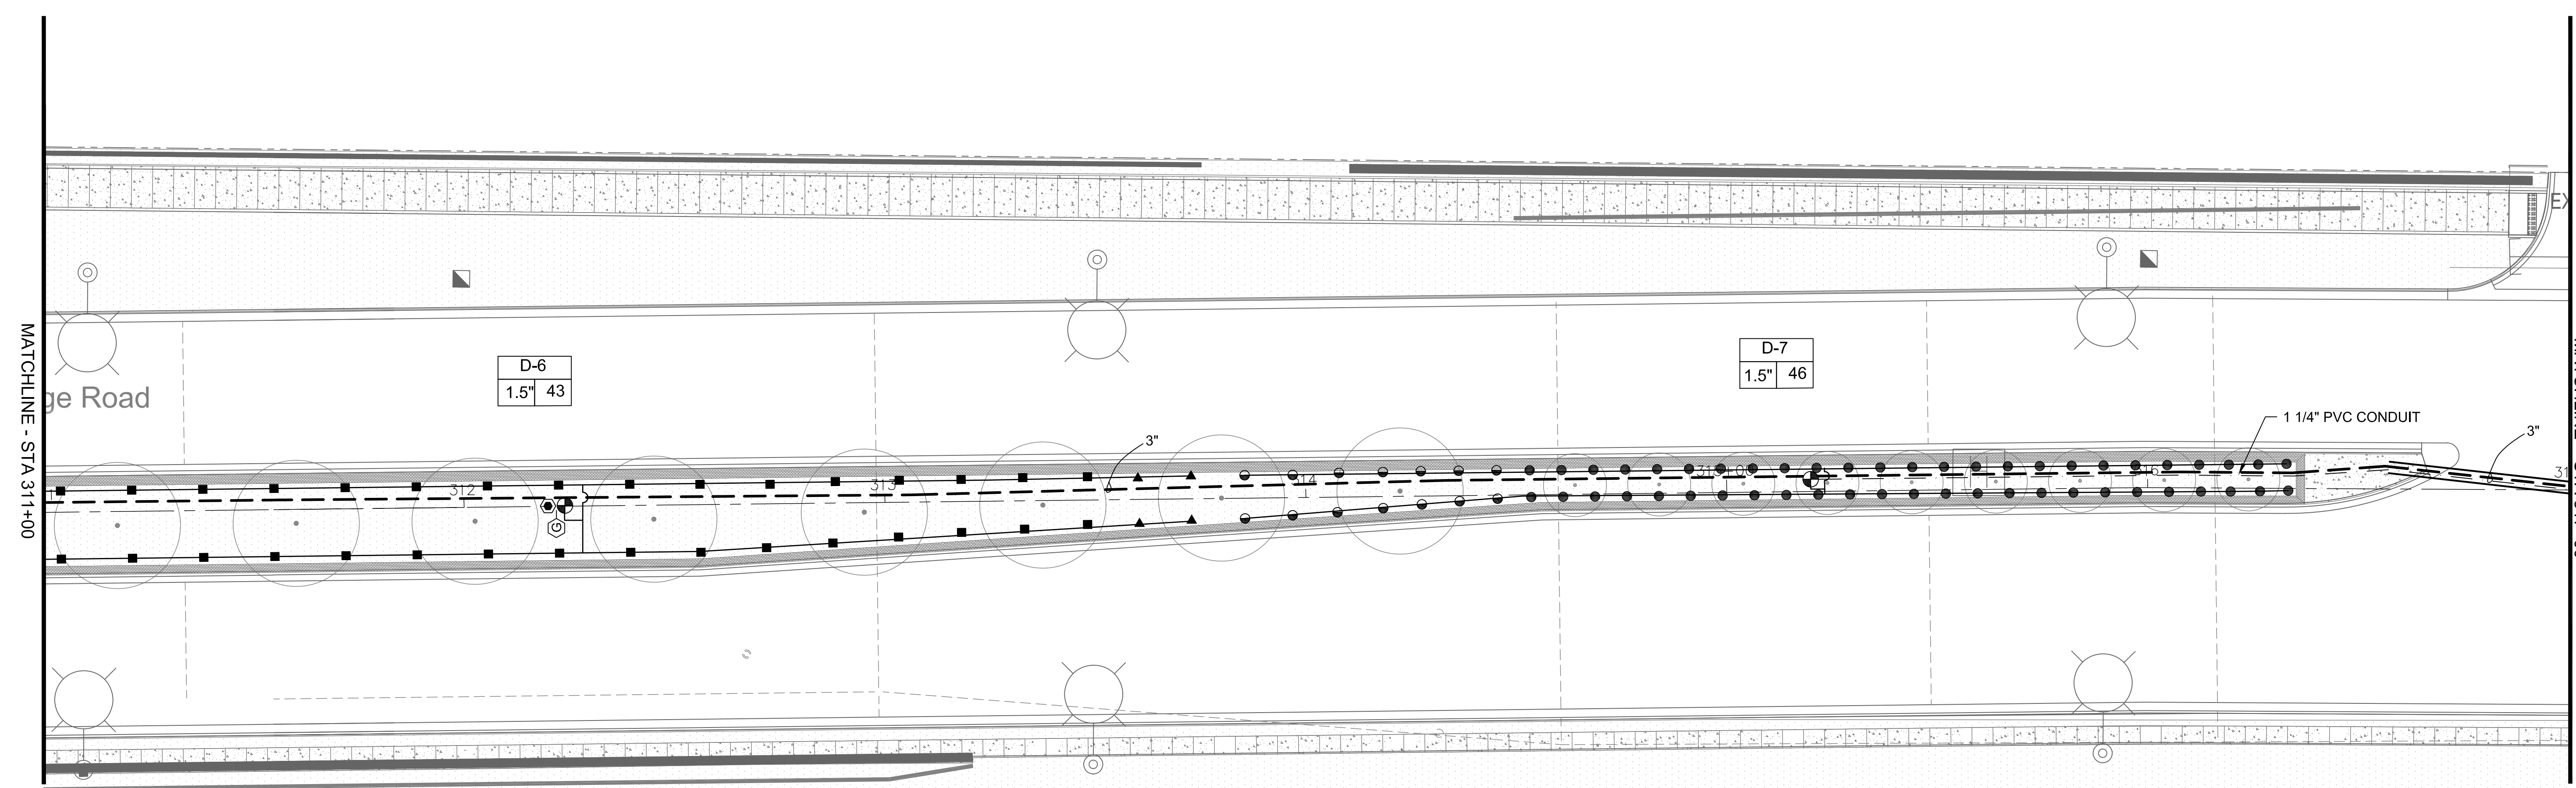



**LEGEND**

○ HUNTER 4" PRS30 SPRAY HEAD 5H	▶ LEEMCO MANUAL ISOLATION VALVE	Ⓟ BOOSTER PUMP STATION
● HUNTER 4" PRS30 SPRAY HEAD 8H	⊙ HUNTER LRC 1" QUICK COUPLER	Ⓡ FEBCO 825YA BACKFLOW PREVENTER
⦿ HUNTER 4" PRS30 SPRAY HEAD 10H-12H	— LATERAL PIPE	Ⓜ WATER METER (PROVIDED BY CITY)
▬ HUNTER 4" PRS 30 15' STRIP SPRAY HEAD	— 3" PVC CL200 SDR21 MAINLINE PIPE	⊖ BLOW OUT TEE
⊙ HUNTER 12" PRS30 SPRAY	Ⓢ HUNTER ACC-D DECODER CONTROLLER	Ⓧ GROUND ROD
■ HUNTER MP 2000 ROTATOR 4" PRS40	⊕ HUNTER SOLAR SYNC WEATHER SENSOR	
▲ HUNTER MP 1000 ROTATOR 4" PRS40	Ⓡ FLOW SENSOR	
⊕ HUNTER ICV 1.5" ELECTRIC VALVE	Ⓜ MASTER VALVE	
▣ HUNTER ICV 1" ELECTRIC VALVE		

**CENTRAL**  
Lawn Sprinklers Inc.  
239 King Street • Elk Grove Village, IL 60007 • Phone: (847) 364-6900 • Fax: (847) 364-9774

**LAGRANGE ROAD IMPROVEMENTS**  
**ORLAND PARK, ILLINOIS**  
Segment 3 - 143rd St to 131st St  
**IRRIGATION AS-BUILT DRAWING**

PROJECT NO.	15780
DESIGNED BY:	KM
DRAWN BY:	KM
CHECKED BY:	JC
DATE:	OCT 25, 2017
SCALE:	1" = 20'
SHEET	3

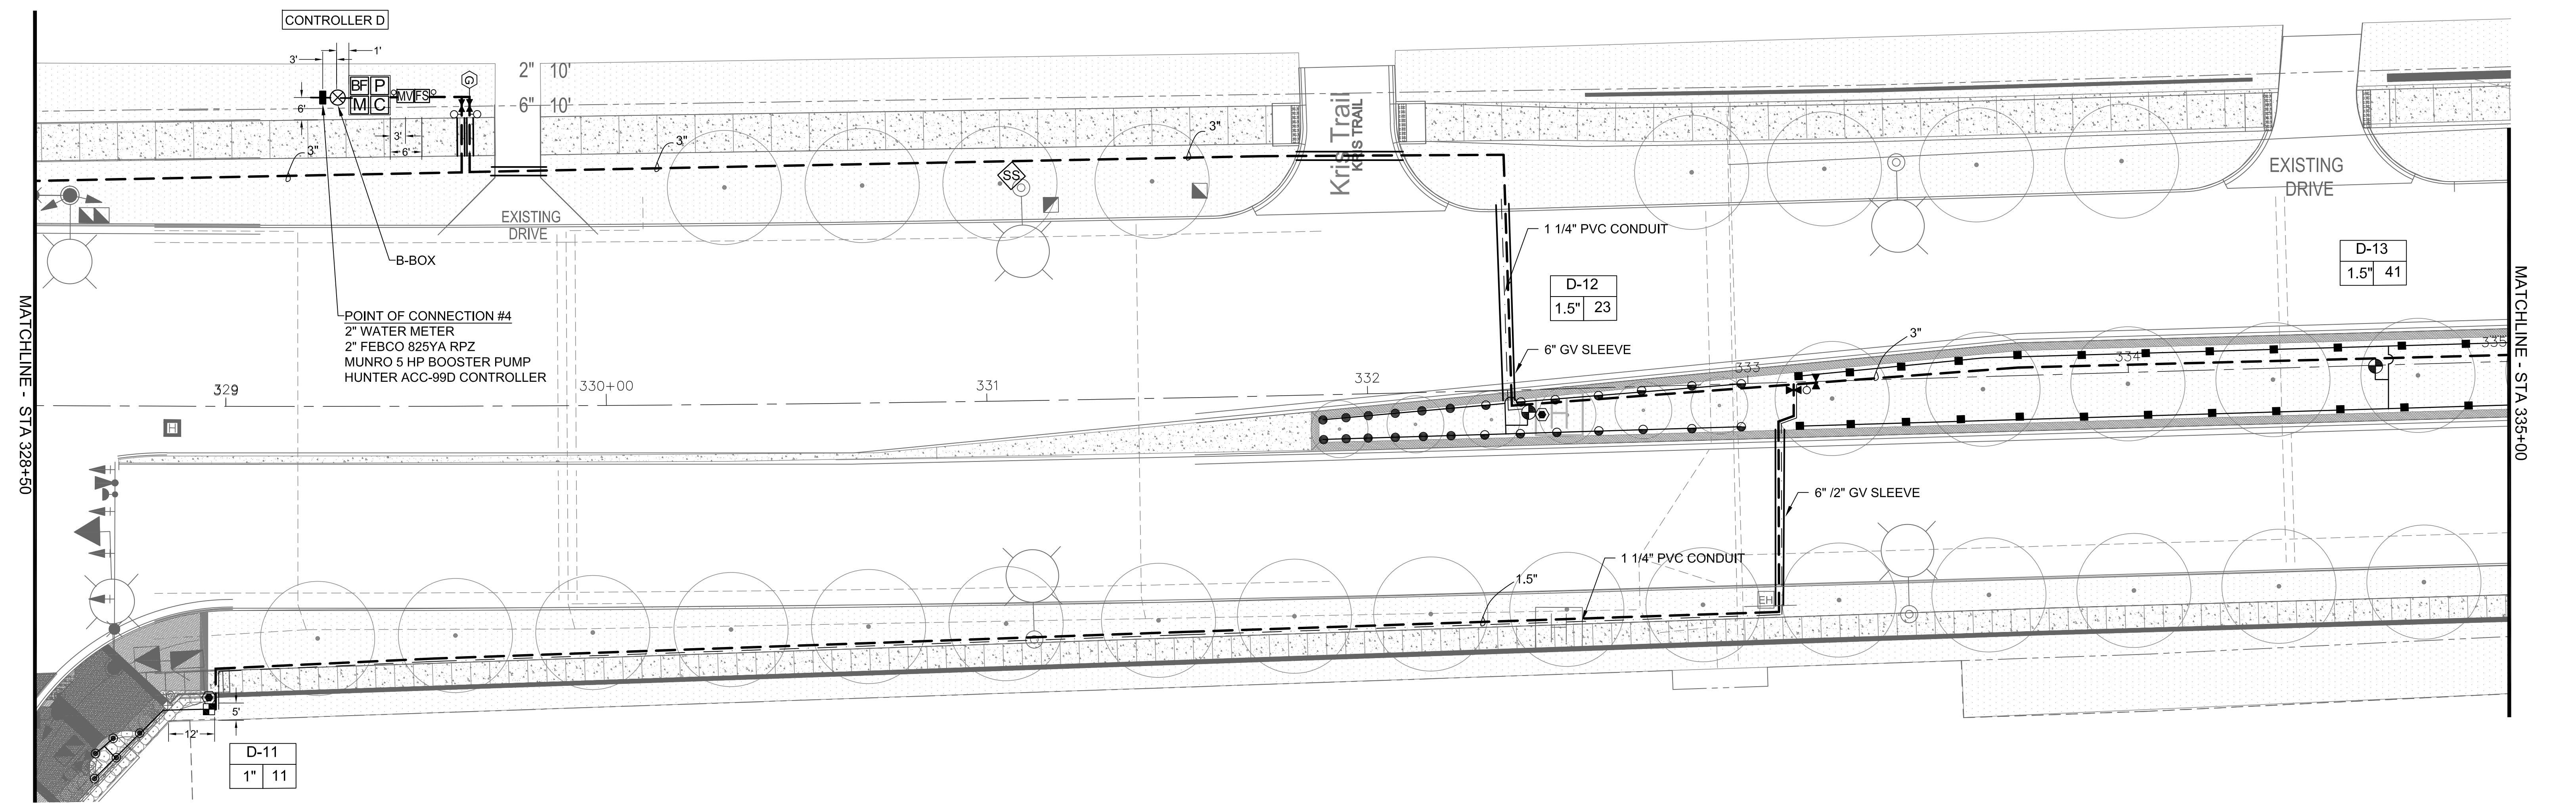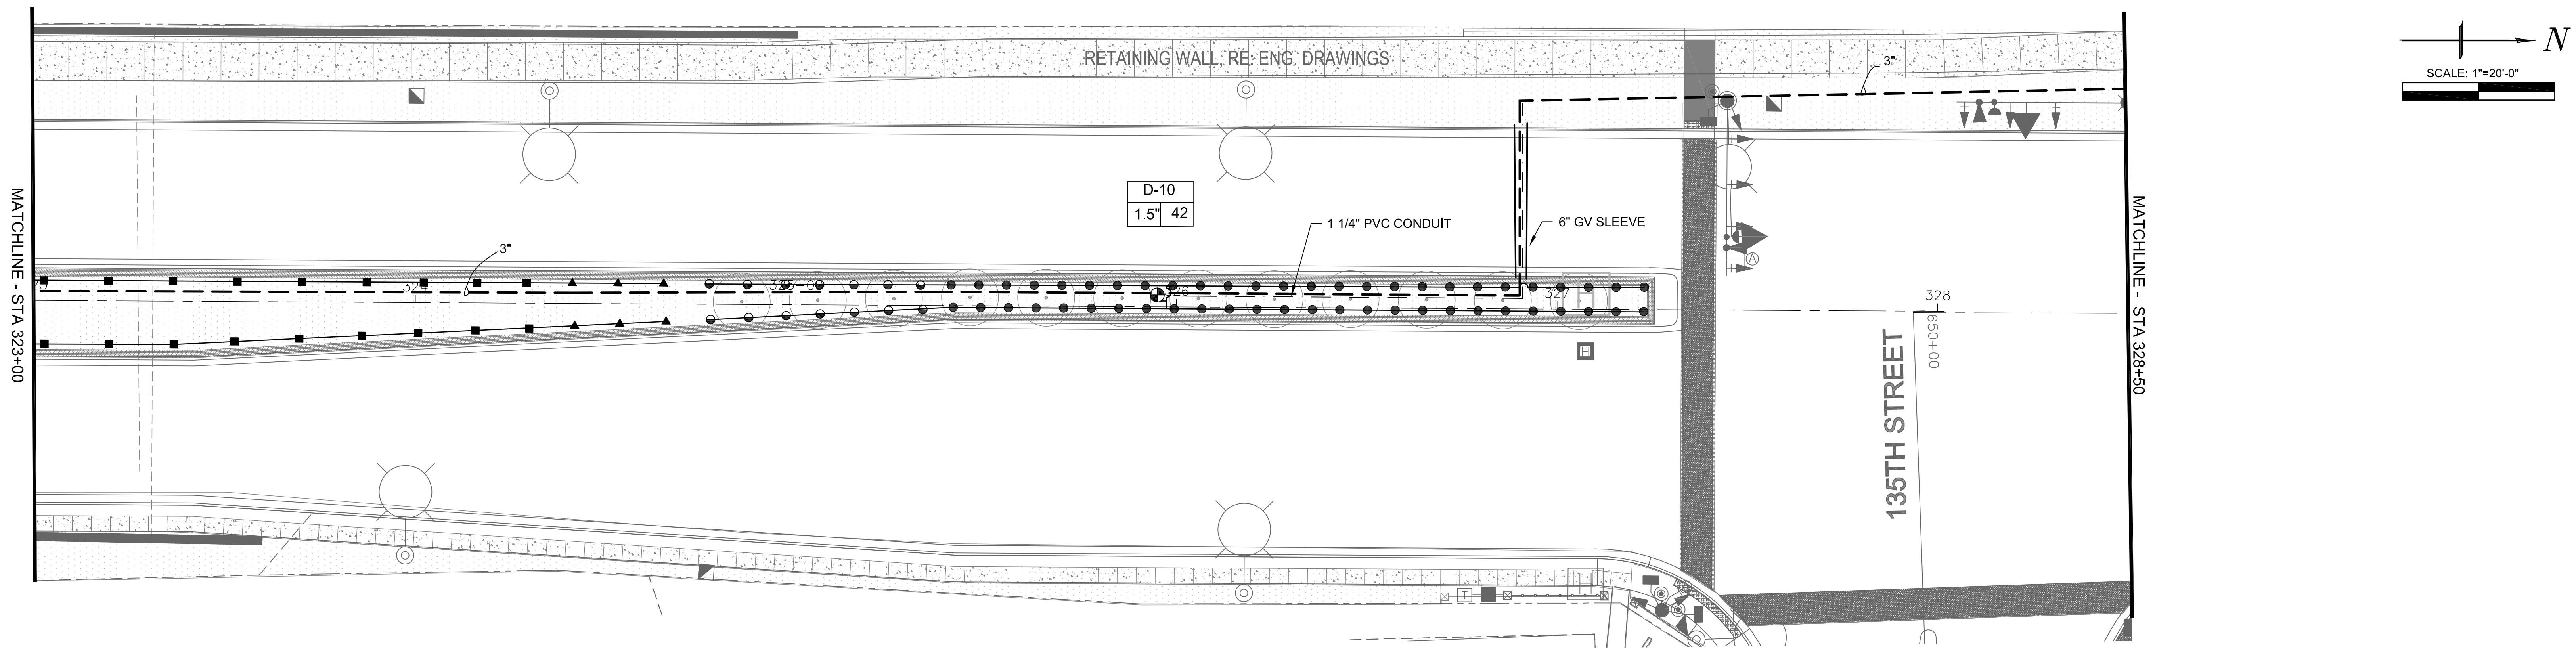



**LEGEND**

○ HUNTER 4" PRS30 SPRAY HEAD 5H	▶ LEEMCO MANUAL ISOLATION VALVE	Ⓟ BOOSTER PUMP STATION
● HUNTER 4" PRS30 SPRAY HEAD 8H	⊙ HUNTER LRC 1" QUICK COUPLER	Ⓛ FEBCO 825YA BACKFLOW PREVENTER
⊖ HUNTER 4" PRS30 SPRAY HEAD 10H-12H	— LATERAL PIPE	Ⓜ WATER METER (PROVIDED BY CITY)
■ HUNTER 4" PRS 30 15' STRIP SPRAY HEAD	— 3" PVC CL200 SDR21 MAINLINE PIPE	⊕ BLOW OUT TEE
⊙ HUNTER 12" PRS30 SPRAY	Ⓛ HUNTER ACC-D DECODER CONTROLLER	Ⓧ GROUND ROD
■ HUNTER MP 2000 ROTATOR 4" PRS40	⊖ HUNTER SOLAR SYNC WEATHER SENSOR	
▲ HUNTER MP 1000 ROTATOR 4" PRS40	Ⓛ FLOW SENSOR	
⊕ HUNTER ICV 1.5" ELECTRIC VALVE	Ⓜ MASTER VALVE	
■ HUNTER ICV 1" ELECTRIC VALVE		

**CENTRAL**  
Lawn Sprinklers Inc.  
239 King Street • Elk Grove Village, IL 60007 • Phone: (847) 364-6900 • Fax: (847) 364-9774

**LAGRANGE ROAD IMPROVEMENTS**  
ORLAND PARK, ILLINOIS  
Segment 3 - 143rd St to 131st St  
IRRIGATION AS-BUILT DRAWING

PROJECT NO.	15780
DESIGNED BY:	KM
DRAWN BY:	KM
CHECKED BY:	JC
DATE:	OCT 25, 2017
SCALE:	1" = 20'
SHEET	4

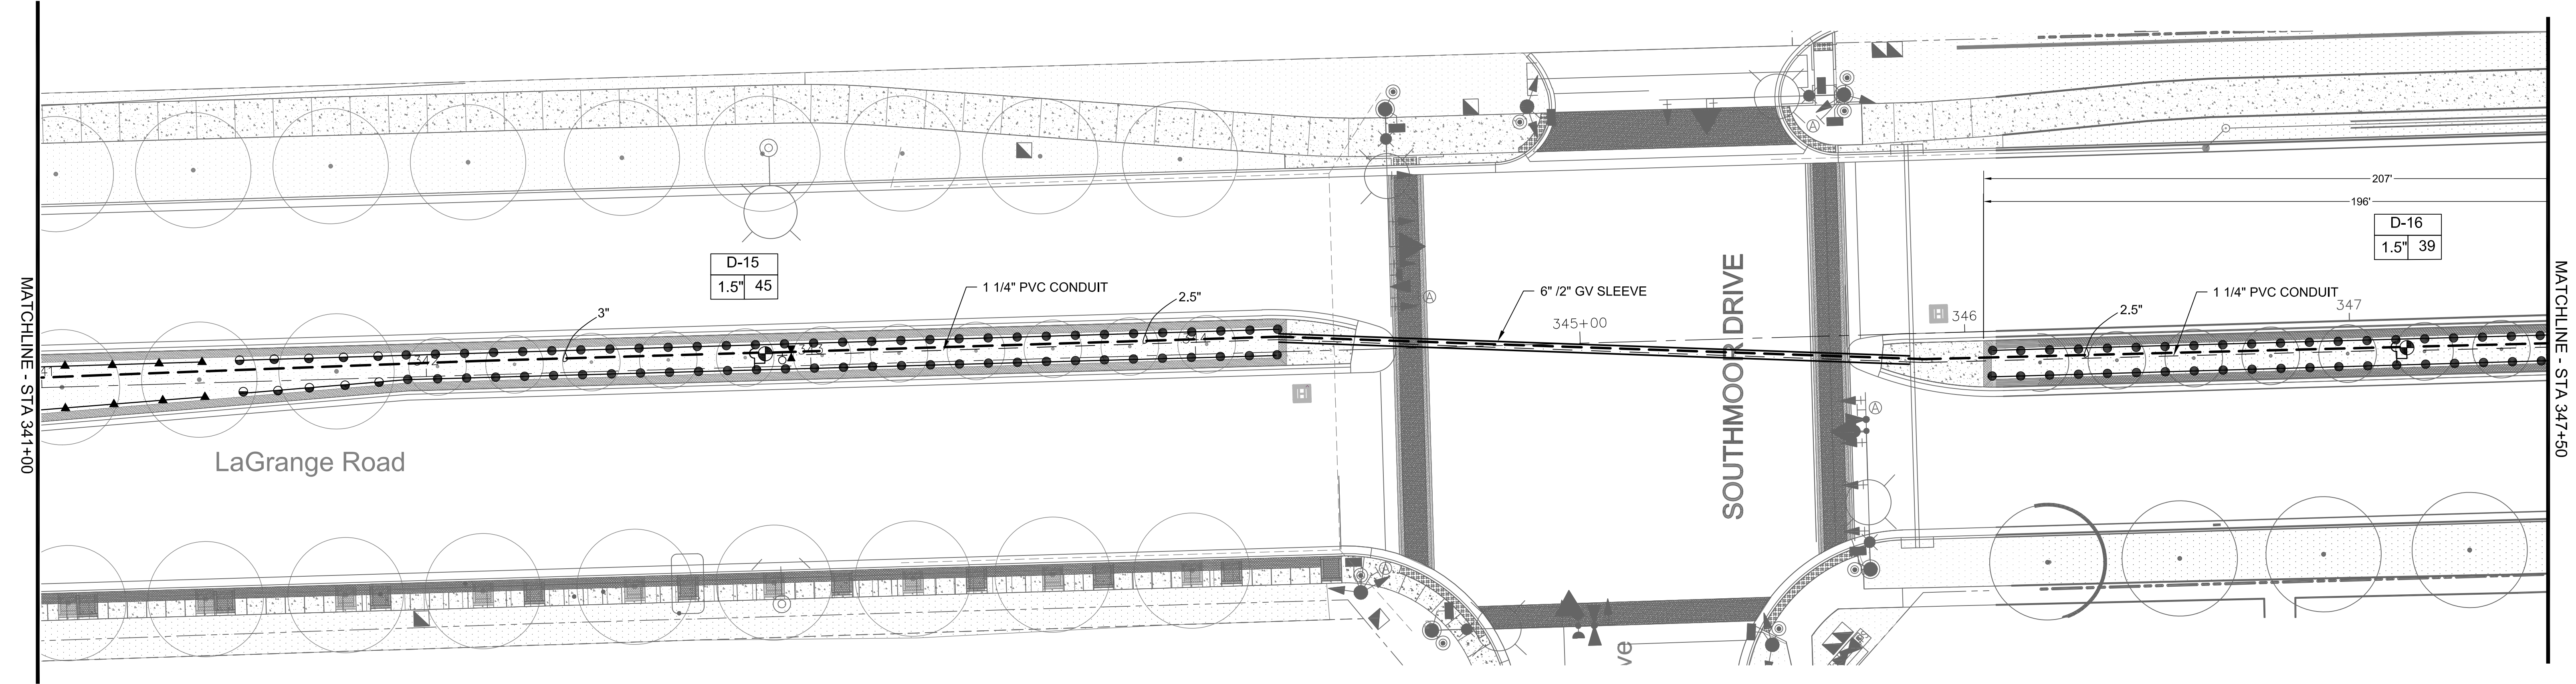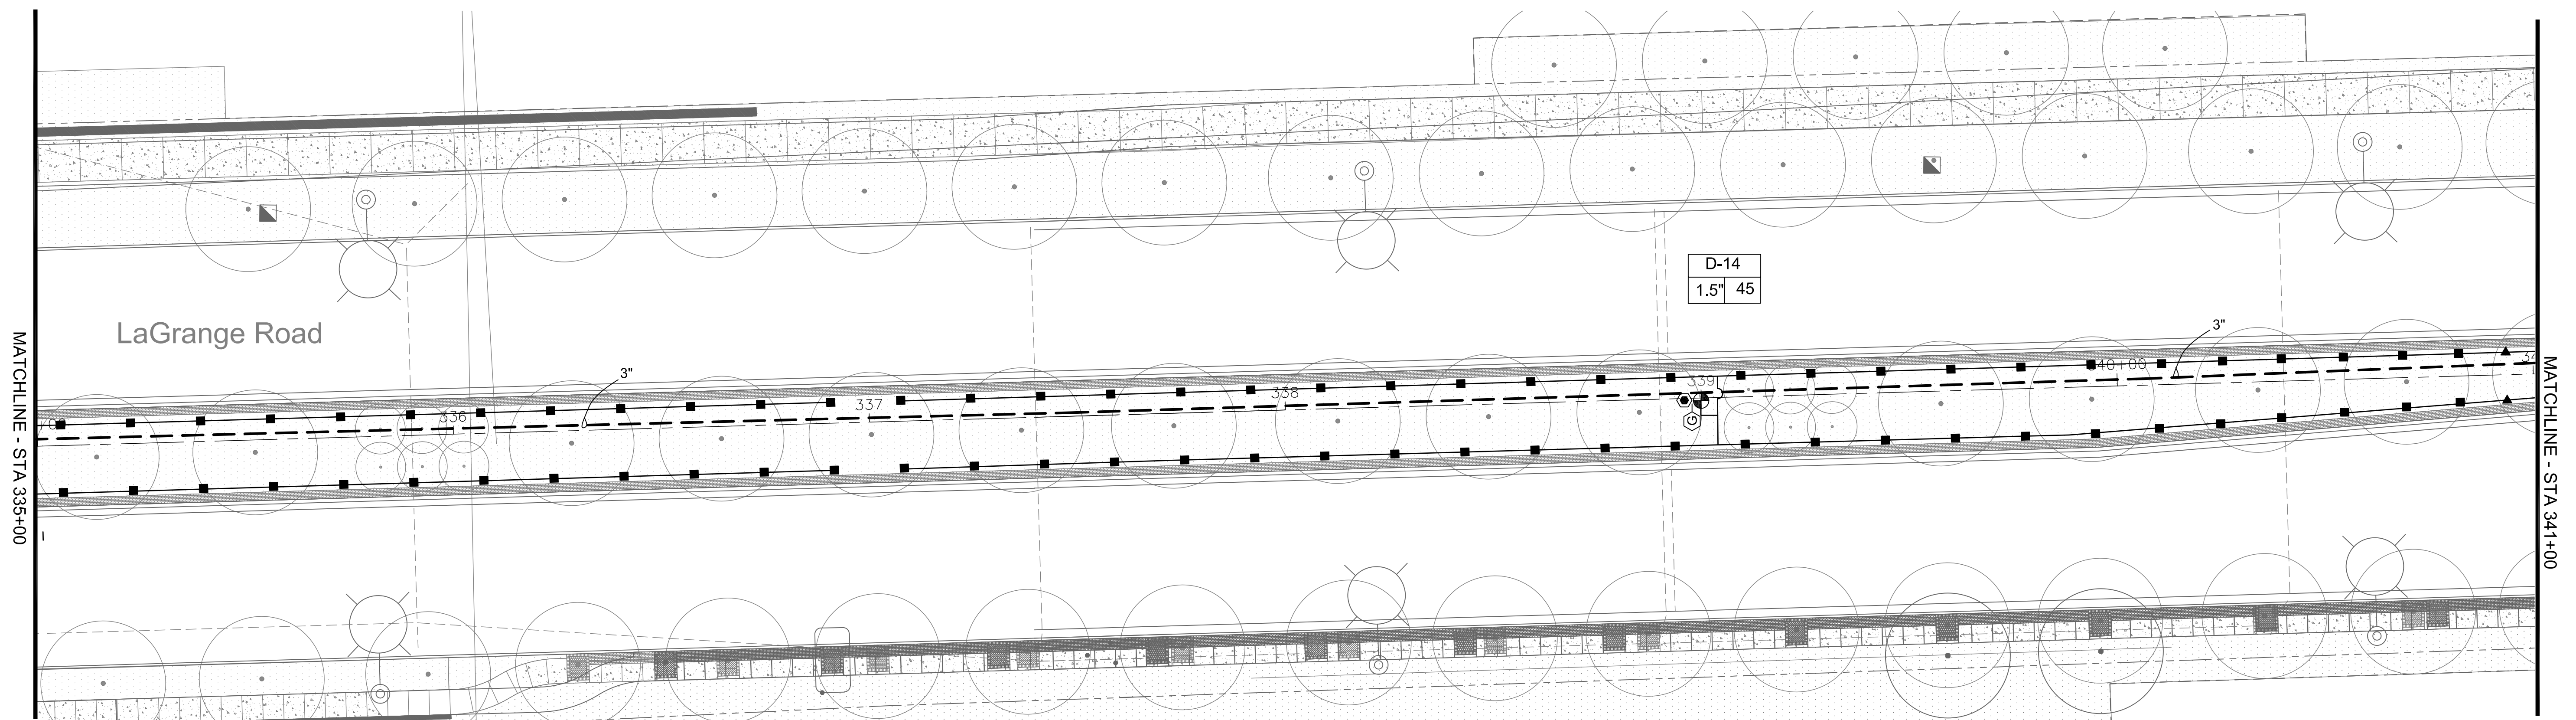


**LEGEND**

○ HUNTER 4" PRS30 SPRAY HEAD 5H	▶ LEEMCO MANUAL ISOLATION VALVE	Ⓟ BOOSTER PUMP STATION
● HUNTER 4" PRS30 SPRAY HEAD 8H	⊙ HUNTER LRC 1" QUICK COUPLER	Ⓡ FEBCO 825YA BACKFLOW PREVENTER
⊖ HUNTER 4" PRS30 SPRAY HEAD 10H-12H	— LATERAL PIPE	Ⓜ WATER METER (PROVIDED BY CITY)
▬ HUNTER 4" PRS 30 15' STRIP SPRAY HEAD	— 3" PVC CL200 SDR21 MAINLINE PIPE	⊕ BLOW OUT TEE
⊙ HUNTER 12" PRS30 SPRAY	Ⓢ HUNTER ACC-D DECODER CONTROLLER	Ⓧ GROUND ROD
■ HUNTER MP 2000 ROTATOR 4" PRS40	Ⓢ HUNTER SOLAR SYNC WEATHER SENSOR	
▲ HUNTER MP 1000 ROTATOR 4" PRS40	Ⓢ FLOW SENSOR	
⊕ HUNTER ICV 1.5" ELECTRIC VALVE	Ⓜ MASTER VALVE	
Ⓜ HUNTER ICV 1" ELECTRIC VALVE		


**CENTRAL**  
Lawn Sprinklers Inc.  
239 King Street • Elk Grove Village, IL 60007 • Phone: (847) 364-6900 • Fax: (847) 364-9774

**LAGRANGE ROAD IMPROVEMENTS**  
**ORLAND PARK, ILLINOIS**  
Segment 3 - 143rd St to 131st St  
**IRRIGATION AS-BUILT DRAWING**

PROJECT NO.	15780
DESIGNED BY:	KM
DRAWN BY:	KM
CHECKED BY:	JC
DATE:	OCT 25, 2017
SCALE:	1" = 20'
SHEET	5

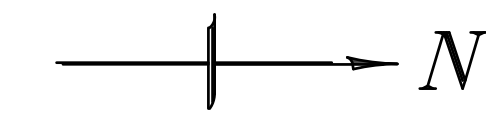

SCALE: 1"=20'-0"

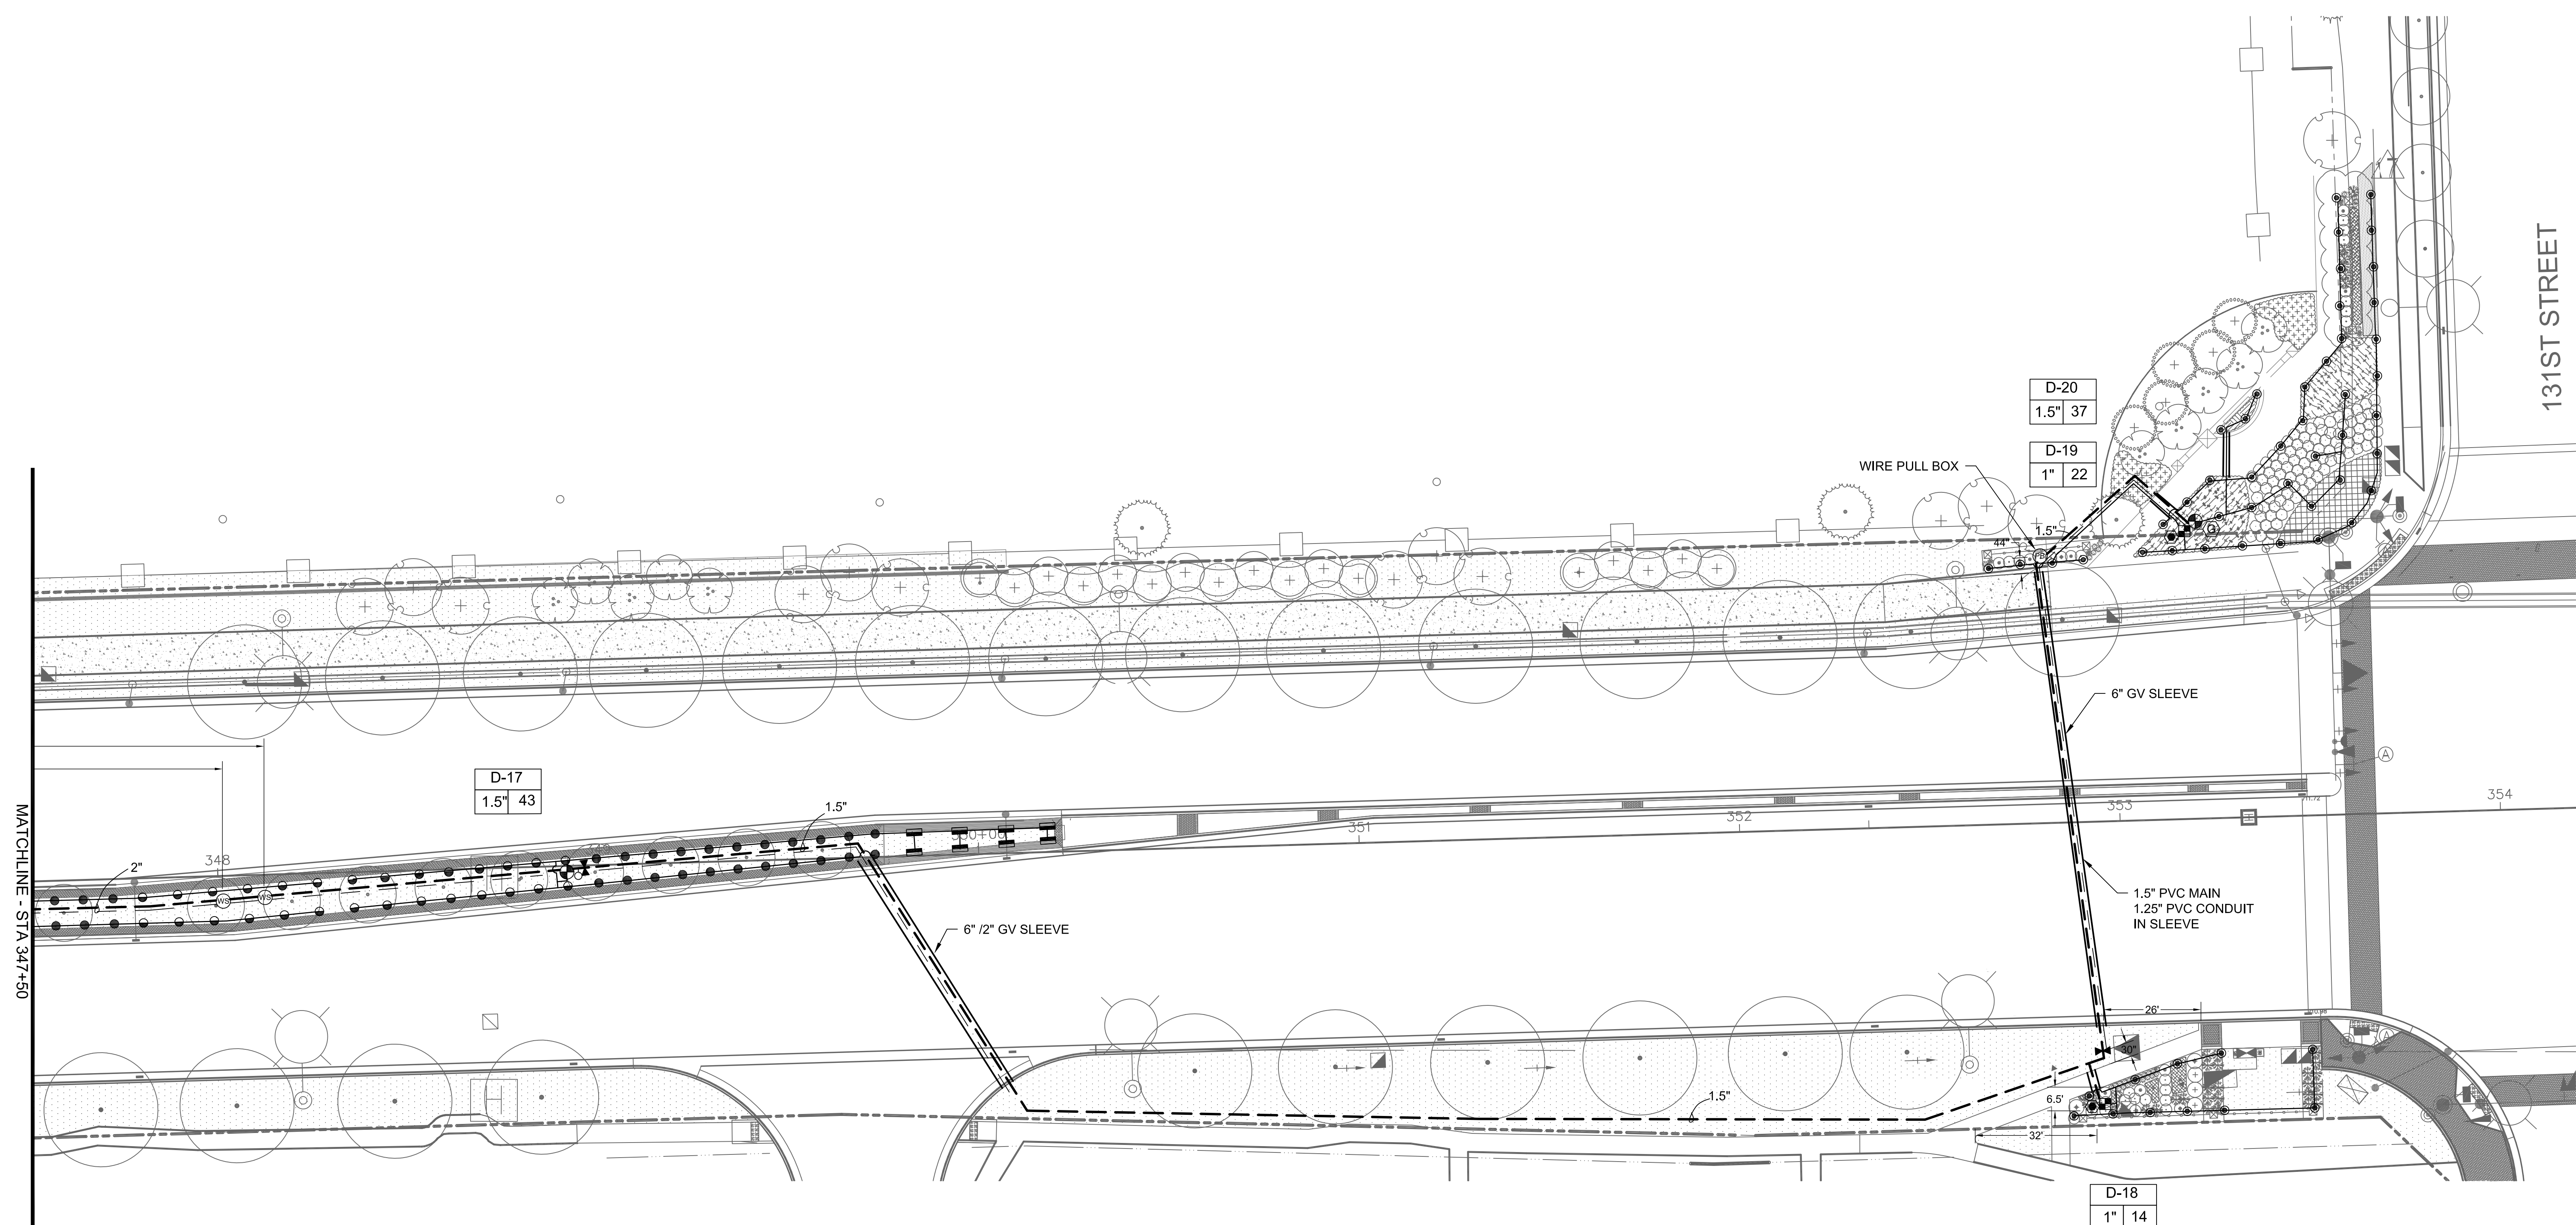

MATCHLINE - STA 347+50

131ST STREET

D-17  
1.5" 43

D-20  
1.5" 37

D-19  
1" 22

D-18  
1" 14

**LEGEND**

○ HUNTER 4" PRS30 SPRAY HEAD 5H	▶ LEEMCO MANUAL ISOLATION VALVE	Ⓟ BOOSTER PUMP STATION
● HUNTER 4" PRS30 SPRAY HEAD 8H	⊙ HUNTER LRC 1" QUICK COUPLER	Ⓛ FEBCO 825YA BACKFLOW PREVENTER
⊖ HUNTER 4" PRS30 SPRAY HEAD 10H-12H	— LATERAL PIPE	Ⓜ WATER METER (PROVIDED BY CITY)
■ HUNTER 4" PRS 30 15' STRIP SPRAY HEAD	— 3" PVC CL200 SDR21 MAINLINE PIPE	⊕ BLOW OUT TEE
⊙ HUNTER 12" PRS30 SPRAY	Ⓢ HUNTER ACC-D DECODER CONTROLLER	Ⓧ GROUND ROD
■ HUNTER MP 2000 ROTATOR 4" PRS40	⊙ HUNTER SOLAR SYNC WEATHER SENSOR	
▲ HUNTER MP 1000 ROTATOR 4" PRS40	Ⓢ FLOW SENSOR	
⊕ HUNTER ICV 1.5" ELECTRIC VALVE	Ⓜ MASTER VALVE	
■ HUNTER ICV 1" ELECTRIC VALVE		

**CENTRAL**  
Lawn Sprinklers Inc.  
239 King Street • Elk Grove Village, IL 60007 • Phone: (847) 364-6900 • Fax: (847) 364-9774

**LAGRANGE ROAD IMPROVEMENTS**  
**ORLAND PARK, ILLINOIS**  
Segment 3 - 143rd St to 131st St  
**IRRIGATION AS-BUILT DRAWING**

PROJECT NO.	15780
DESIGNED BY:	KM
DRAWN BY:	KM
CHECKED BY:	JC
DATE:	OCT 25, 2017
SCALE:	1" = 20'
SHEET	6