


BOARD APPROVED

CASE NO. 2008-0689

11-3-08

CTIONS

CTIONS

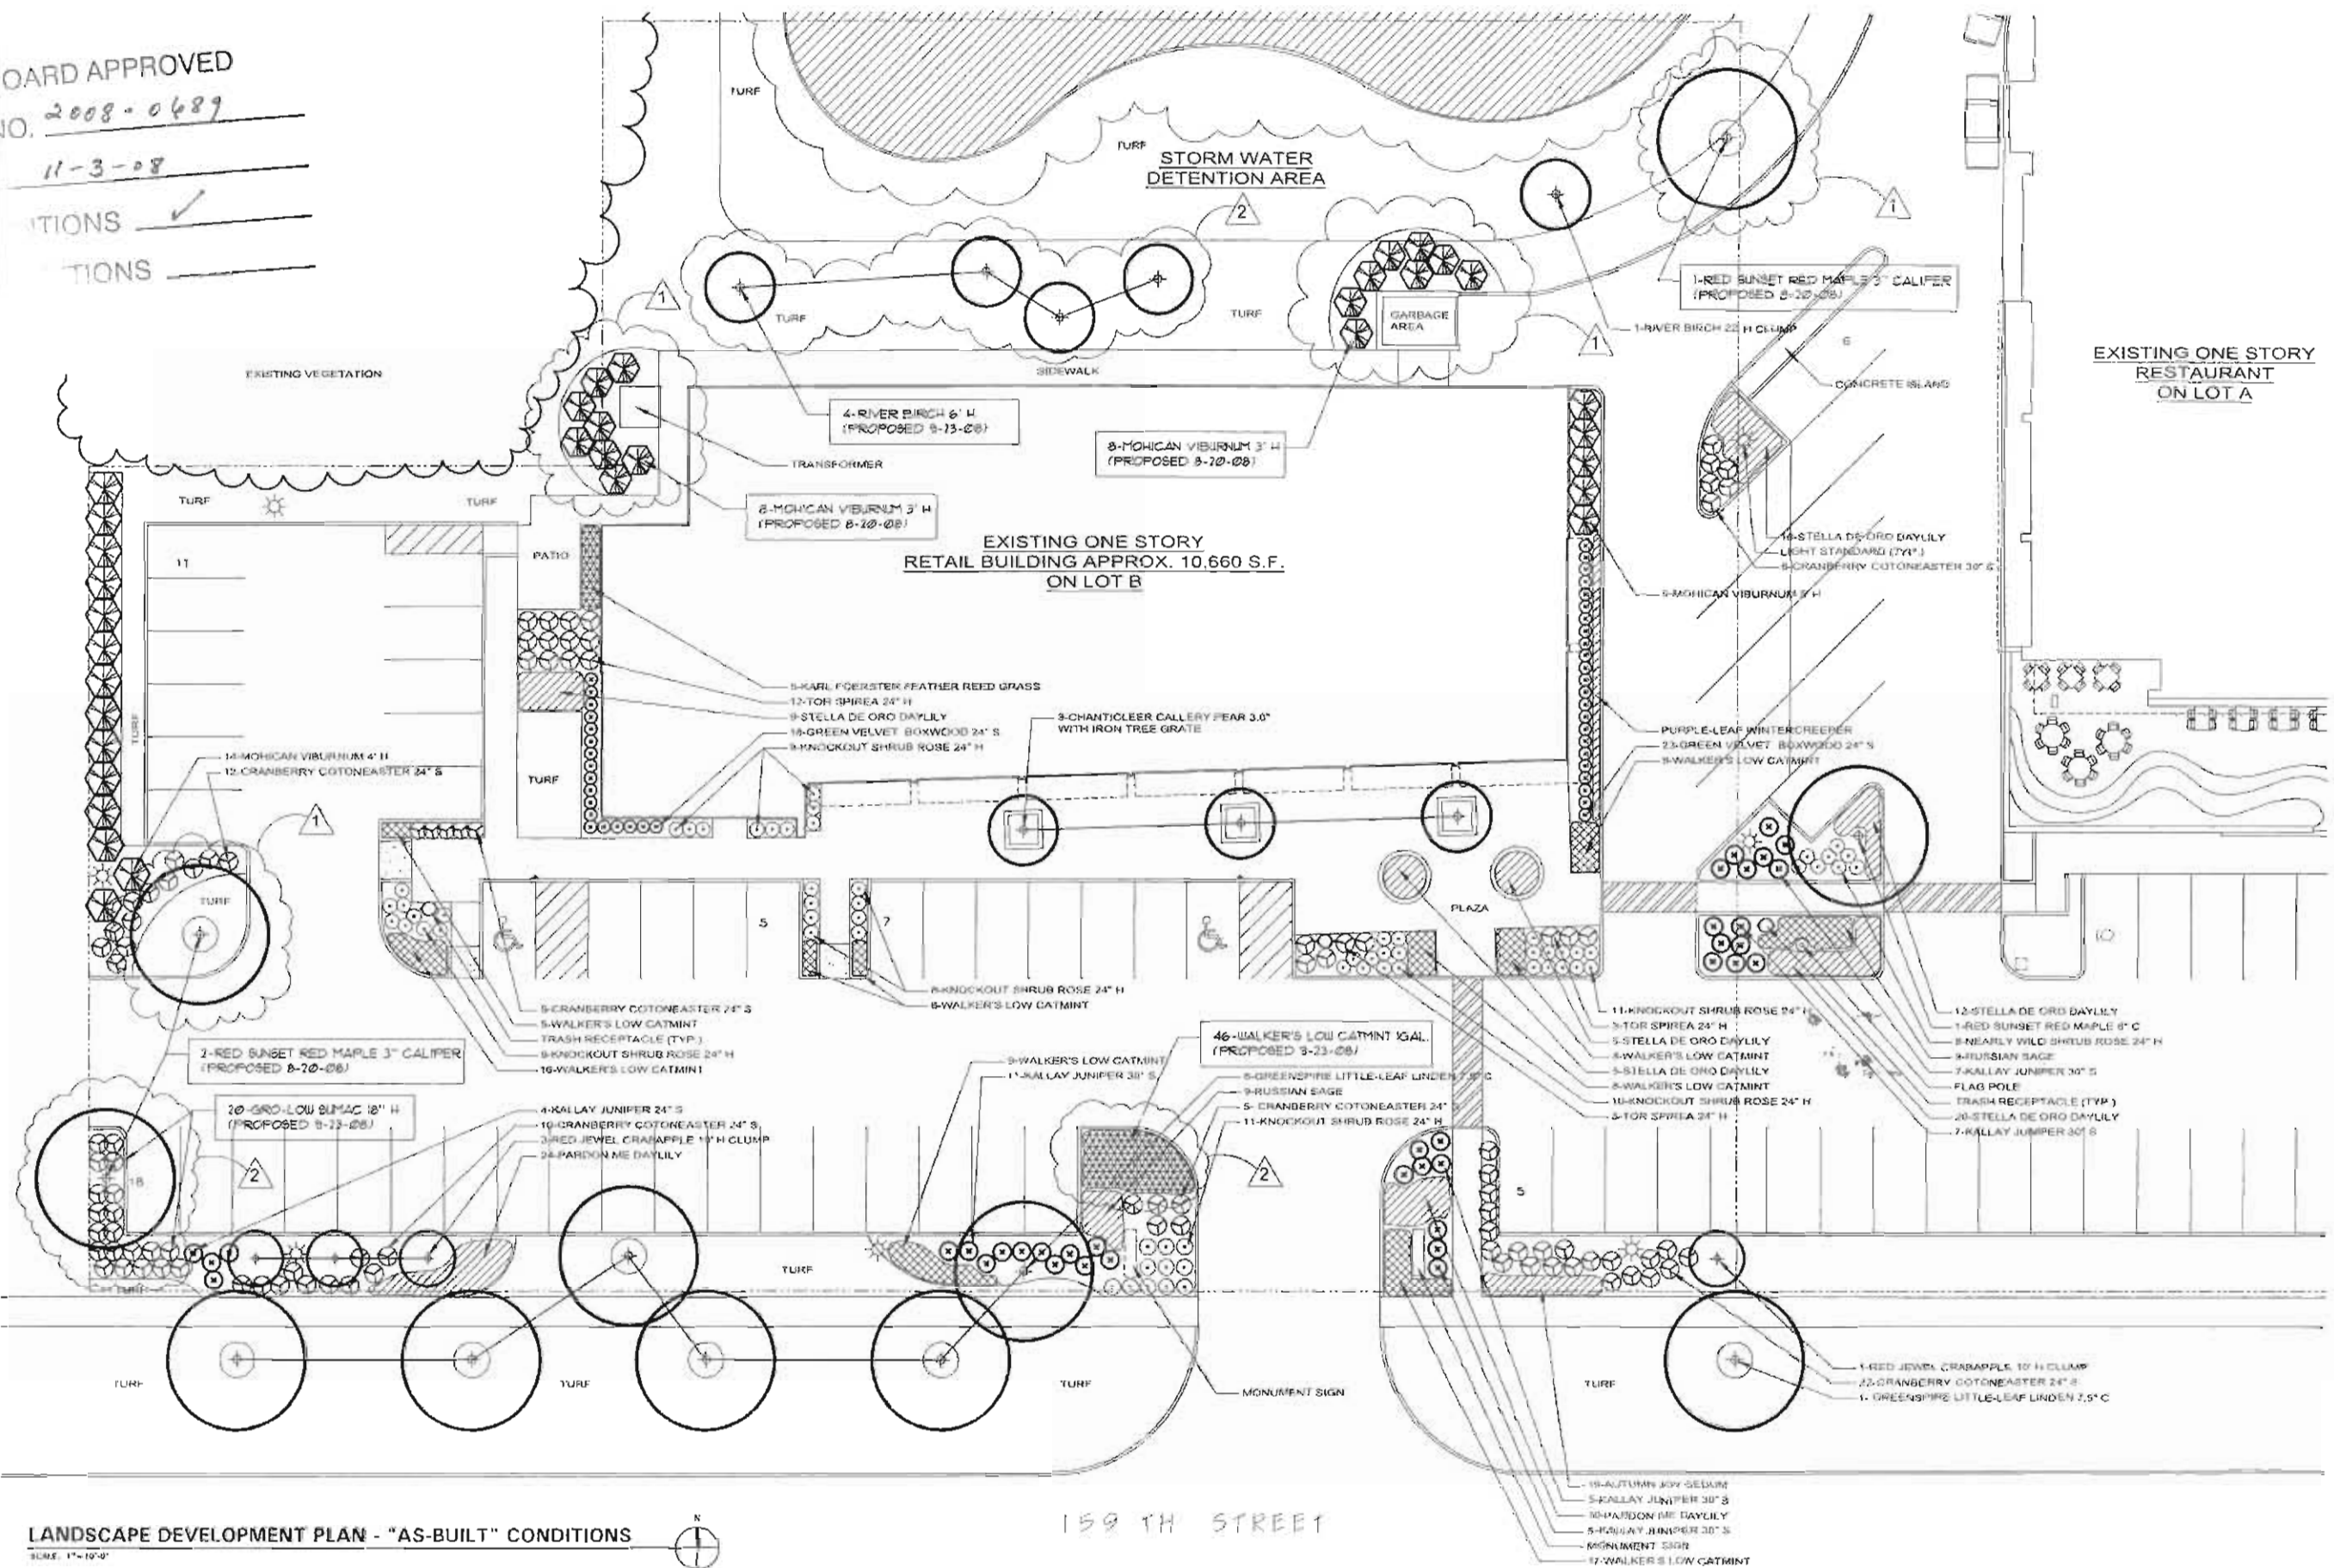

JEK DEVELOPMENT
222 S. WILSON AVE. SUITE 100
SPRINGFIELD, IL 62761

tripptedi design, p.c.
LANDSCAPE ARCHITECTURE
800 S. WILSON AVE. SUITE 100
SPRINGFIELD, IL 62761
618-213-8500 FAX 618-213-8500

VILLAGE REVIEW SUBMITTAL
VILLAGE REVIEW SUBMITTAL

8-20-2008
8-23-2008

LANDSCAPE DEVELOPMENT PLAN -
"AS-BUILT" CONDITIONS

NEW PATIO RETAIL CENTER
7850 WEST 159TH STREET
ORLAND PARK, ILLINOIS

DATE: 8-23-2008
PROJECT: NEW PATIO RETAIL CENTER
DRAWN BY: J. J. J. J.
CHECKED BY: J. J. J. J.

L1