



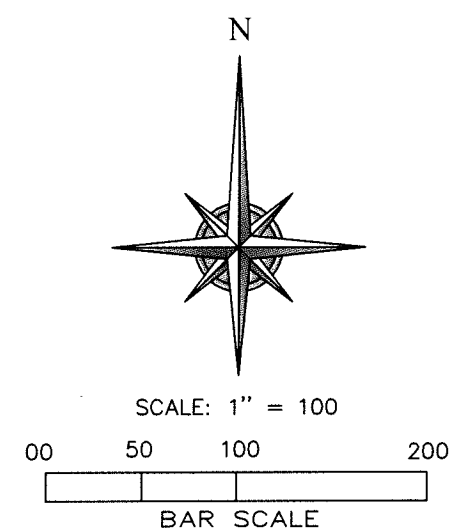

LEGEND	
	PROPERTY LINE
	PRO LEASE LINE
	PRO EASEMENT LINE
	CONCRETE
	EVERGREEN/DECIDUOUS WITH SIZE IN INCHES
	GAS VALVE
	MANHOLE
	FIRE HYDRANT
	B-BOX / SERVICE VALVE
	POST LIGHT/GROUND LIGHT
	FENCE LINE
	OVERHEAD LINE
	TYPICAL SIGN
	UTILITY POLE
	PEDESTAL (telco, elec, cable)
	GAS METER
	ELECTRIC METER
	U.G. TELCO LINE
	U.G. ELECTRIC LINE
	FIBER OPTIC LINE

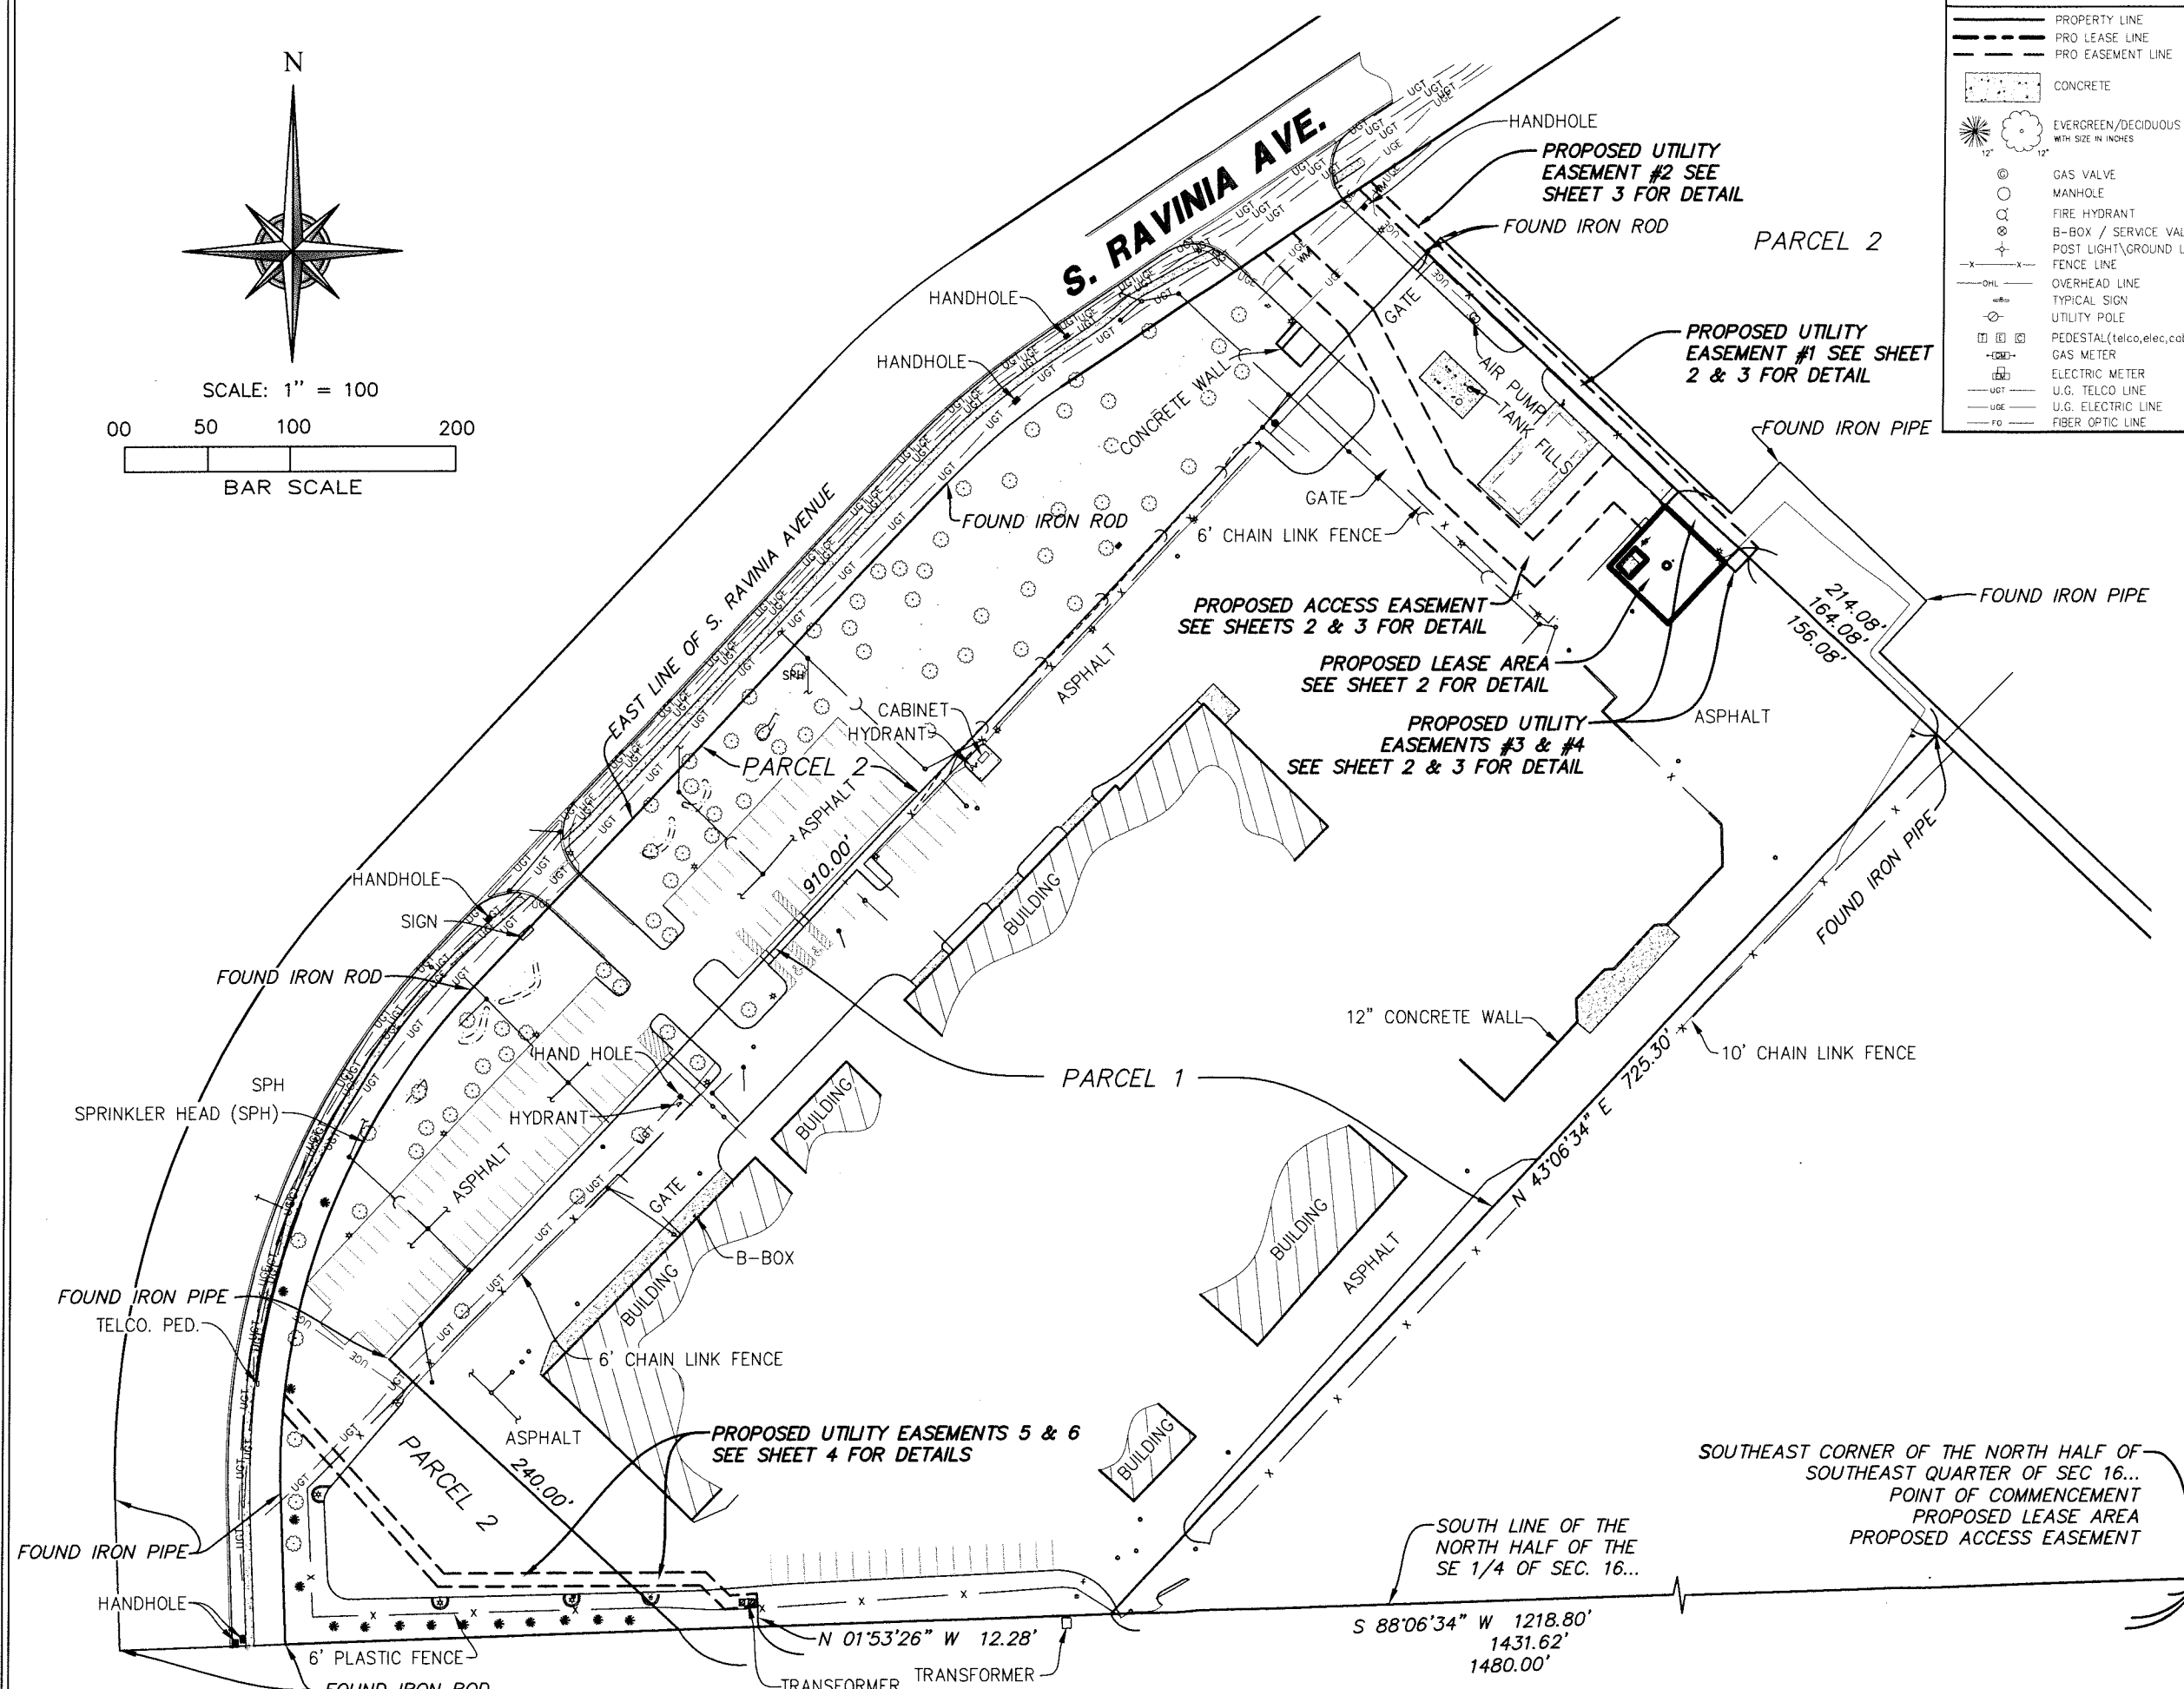

Eco-Site[®]

240 LEIGH FARM ROAD, SUITE 415
DURHAM, NC 27707

PROJECT INFORMATION:

94TH AVENUE / IL0130

15855 S. RAVINIA AVE.
ORLAND PARK, IL 60482
COOK COUNTY
S16218

CURRENT ISSUE DATE:

6/28/18

ISSUED FOR:

REV.	DATE	ISSUED FOR	BY
1	11/28/16	PER COMMENTS	KCH
2	3/20/17	REVISED LEASE AREA REVISED EASEMENTS	RM
3	10/30/17	PER COMMENTS	KCH
4	3/2/18	AS-BUILT	KCH
5	4/11/18	REVISED EASEMENTS	REM
6	6/28/18	REVISED EASEMENTS	KCH

CONSULTANT:

WT

Group

Engineering • Design • Consulting

2675 Pratum Avenue
Hoffman Estates, Illinois 60192
PH: (224) 293-6333 FAX: (224) 293-6444
www.wtengineering.com
IL License No.: 184.007570-0015 Exp: 04/30/19
COPYRIGHT © 2018 THE WT GROUP, LLC

DRAWN BY: CHK: APV:

KCH

FIM

FIM

LICENSER:

FRANK I. MATIJC
PROFESSIONAL LAND SURVEYOR
STATE OF ILLINOIS
LICENSE # 035-003556
EXPIRES: 11/30/2019 SIGNED: 6/28/18

SHEET TITLE:

SURVEY

SHEET NUMBER: REVISION:

S-1

6

OF 6 SHEETS

PROJECT INFORMATION:

94TH AVENUE / IL0130

15655 S. RAVINIA AVE.
ORLAND PARK, IL 60462
COOK COUNTY

CURRENT ISSUE DATE:

6/28/18

ISSUED FOR:

REV. DATE: ISSUED FOR: BY:

REV.	DATE	ISSUED FOR	BY
1	11/29/16	PER COMMENTS	KCH
2	3/20/17	REVISED LEASE AREA	RM
3	10/30/17	PER COMMENTS	KCH
4	3/2/18	AS-BUILT	KCH
5	4/11/18	REVISED EASEMENTS	RM
6	6/28/18	REVISED EASEMENTS	KCH

CONSULTANT:

WT
Group

Engineering • Design • Consulting

2875 Pratum Avenue

Hoffman Estates, Illinois 60192

PH: (224) 293-6333 FAX: (224) 293-6444

www.wtengineering.com

IL License No. 184.007570-0015 Exp. 04/30/19

COPYRIGHT © 2018 THE W.T. GROUP, LLC

DRAWN BY: CHK: APV:

KCH

FIM

FIM

LICENSER:

FRANK I. MATIJC
PROFESSIONAL LAND SURVEYOR
STATE OF ILLINOIS
LICENSE # 035-003556

EXPIRES: 11/30/2019 SIGNED: 6/28/18

SHEET TITLE:

SURVEY



SHEET NUMBER:

S-2

REVISION:

6

OF 6 SHEETS

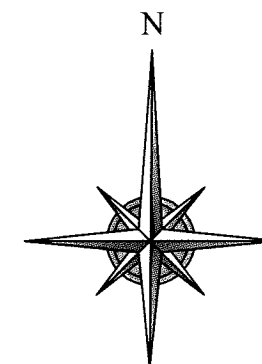
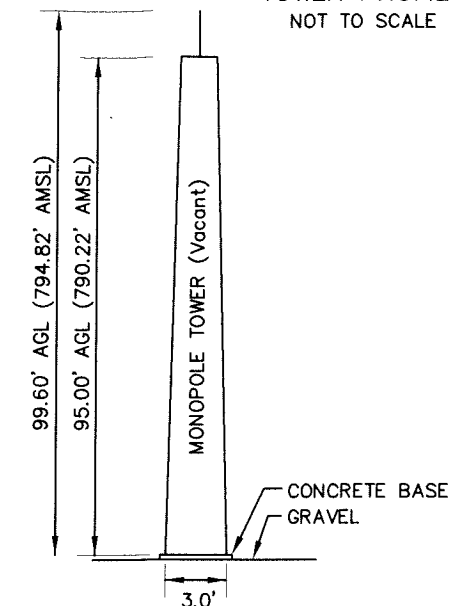
TOWER PROFILE
NOT TO SCALE


SCALE: 1" = 20'

LEGEND

---	PROPERTY LINE
---	PRO LEASE LINE
---	PRO EASEMENT LINE
CONCRETE	CONCRETE
EVERGREEN/DECIDUOUS WITH SIZE IN INCHES	EVERGREEN/DECIDUOUS WITH SIZE IN INCHES
GAS VALVE	GAS VALVE
MANHOLE	MANHOLE
FIRE HYDRANT	FIRE HYDRANT
B-BOX / SERVICE VALVE	B-BOX / SERVICE VALVE
POST LIGHT/GROUND LIGHT	POST LIGHT/GROUND LIGHT
FENCE LINE	FENCE LINE
OVERHEAD LINE	OVERHEAD LINE
TYPICAL SIGN	TYPICAL SIGN
UTILITY POLE	UTILITY POLE
PEDESTAL (telco, elec, cable)	PEDESTAL (telco, elec, cable)
GAS METER	GAS METER
ELECTRIC METER	ELECTRIC METER
U.G. TELCO LINE	U.G. TELCO LINE
U.G. ELECTRIC LINE	U.G. ELECTRIC LINE
FIBER OPTIC LINE	FIBER OPTIC LINE

LINE	BEARING	DISTANCE
A	N 46°53'26" W	10.00'
B	N 43°06'34" E	15.00'
C	S 46°53'26" E	10.00'
D	S 43°06'34" W	15.00'
E	N 46°53'26" W	50.00'
F	N 43°06'34" E	11.60'
G	S 46°53'26" E	50.00'
H	S 43°06'34" W	11.60'
I	S 43°06'34" W	11.60'
J	N 46°53'26" W	8.00'
K	N 43°06'34" E	11.60'
L	S 46°53'26" E	8.00'
M	S 43°06'34" W	8.00'

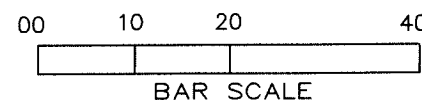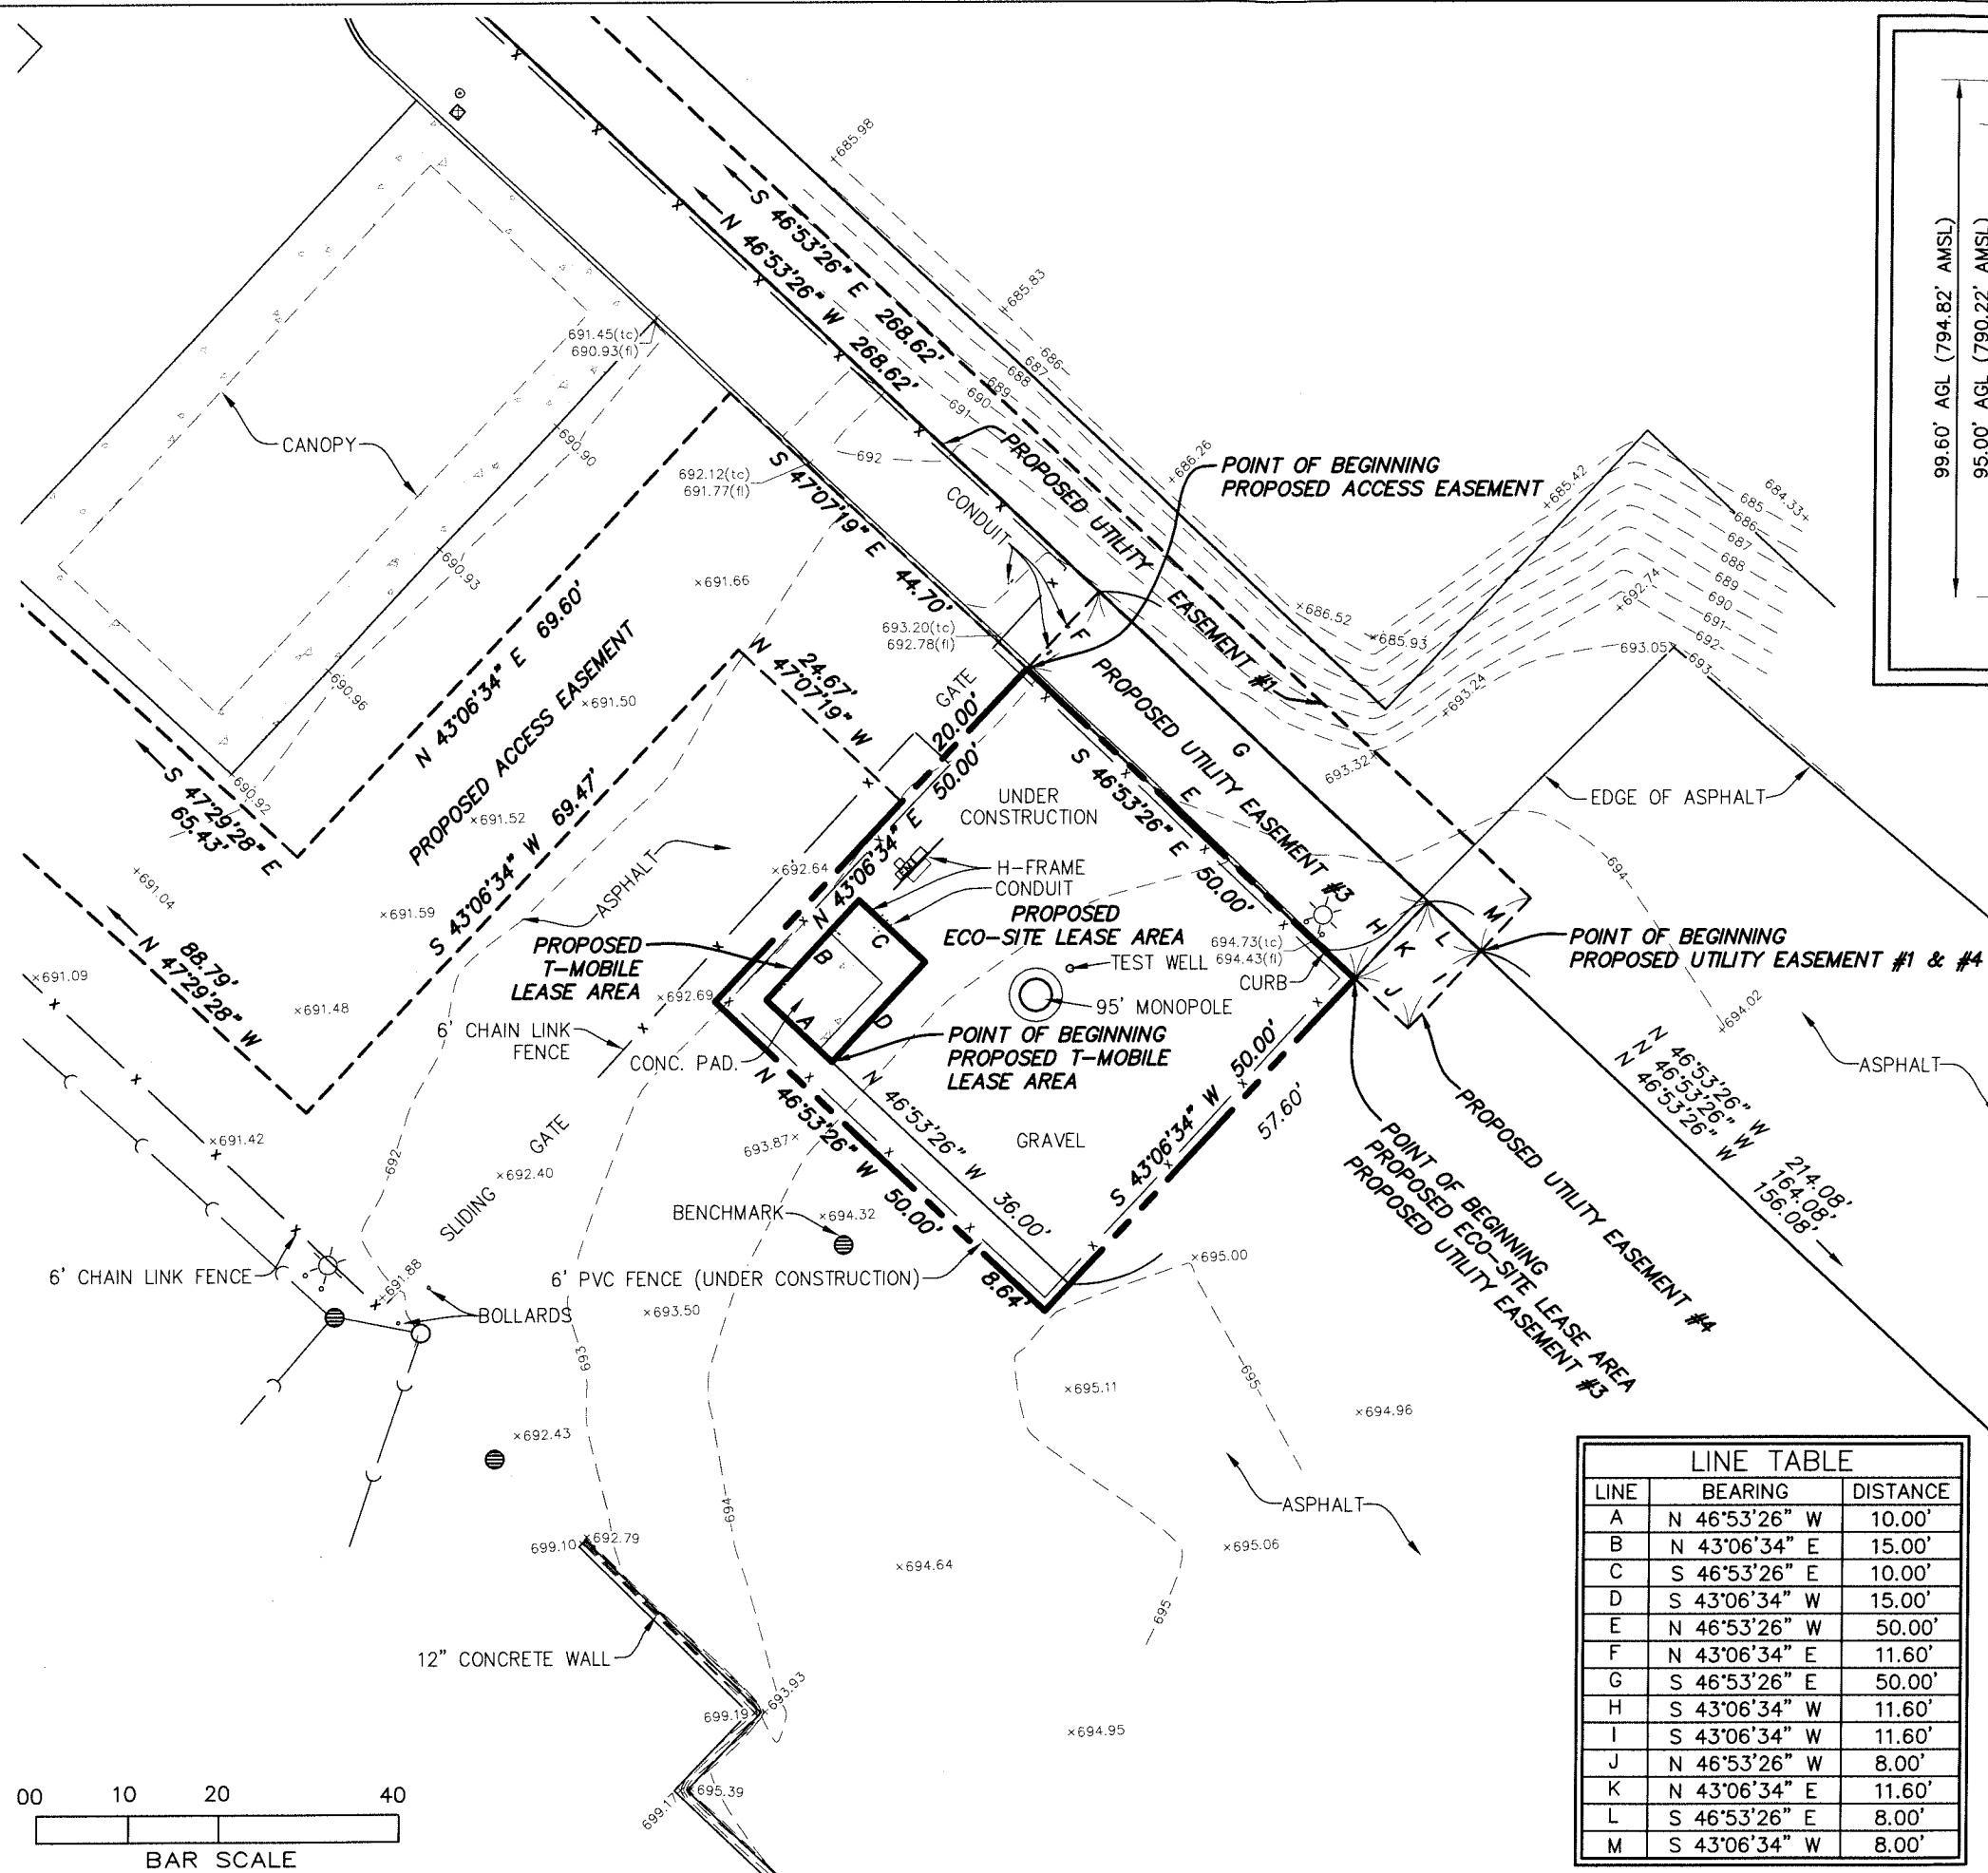

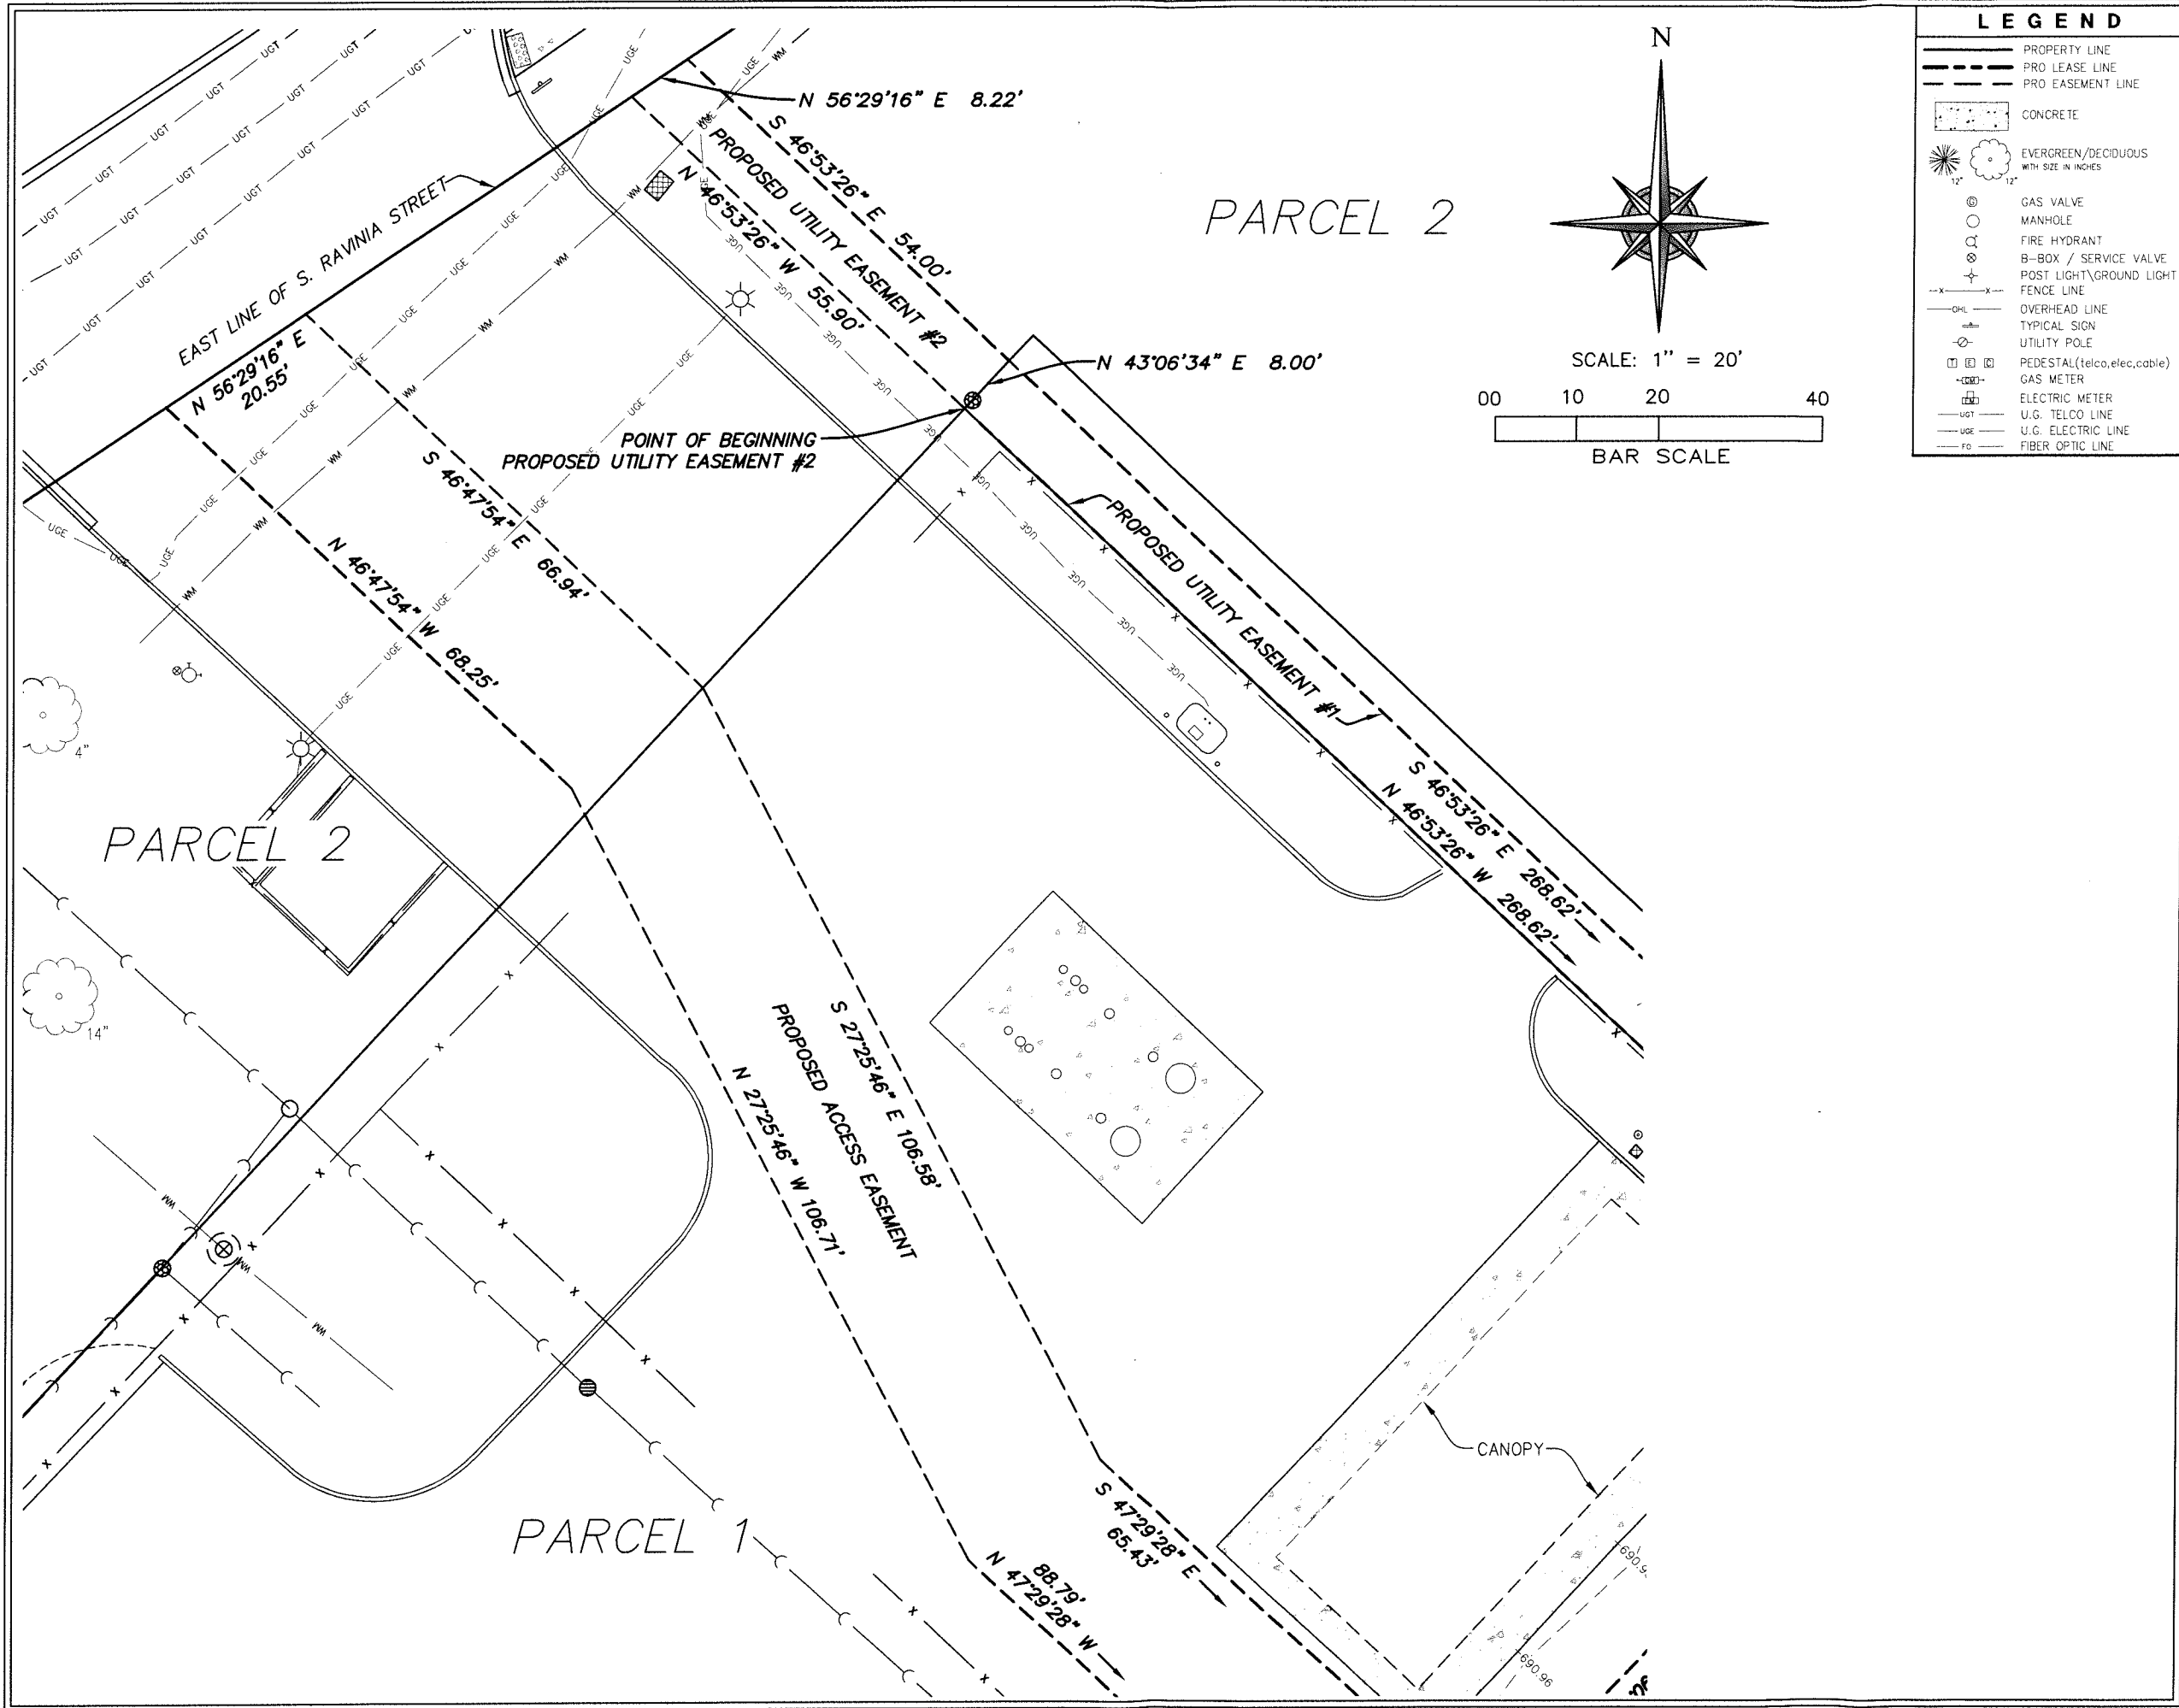

Eco-Site

240 LEIGH FARM ROAD, SUITE 415
DURHAM, NC 27707

PROJECT INFORMATION:

94TH AVENUE / IL0130

15655 S. RAVINIA AVE.
ORLAND PARK, IL 60462
COOK COUNTY

CURRENT ISSUE DATE:

6/28/18

ISSUED FOR:

REV.	DATE	ISSUED FOR:	BY:
1	11/29/16	PER COMMENTS	KCH
2	3/20/17	REVISED LEASE AREA	RM
3	10/30/17	REVISED EASEMENTS	
4	3/2/18	PER COMMENTS	KCH
5	4/11/18	AS-BUILT	KCH
6	4/11/18	REVISED EASEMENTS	REM
7	6/28/18	REVISED EASEMENTS	KCH

CONSULTANT:

WT Group

Engineering • Design • Consulting

2675 Pratum Avenue
Hoffman Estates, Illinois 60192
PH: (224) 293-6333 FAX: (224) 293-6444
www.wtengineering.com
IL License No.: 184.007570-0015 Exp: 04/30/19
COPYRIGHT © 2018 THE WT GROUP, LLC

DRAWN BY:	CHK:	APV:
KCH	FIM	FIM

LICENSER:


FRANK I. MATIĆ
PROFESSIONAL LAND SURVEYOR
STATE OF ILLINOIS
LICENSE # 035-003556
EXPIRES: 11/30/2019 SIGNED: 6/28/18

SHEET TITLE:

SURVEY

SHEET NUMBER:	REVISION:
S-3	6

OF 6 SHEETS

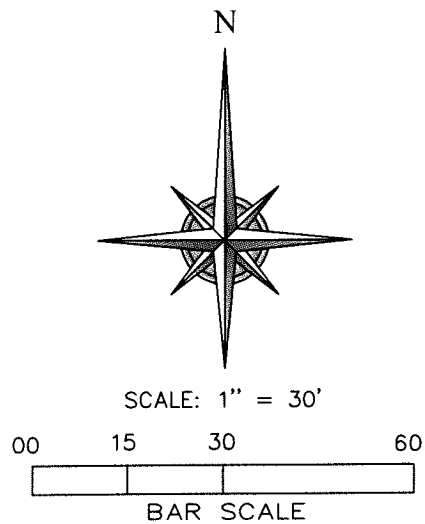

LOCATION MAP

LEGEND	
	PROPERTY LINE
	PRO LEASE LINE
	PRO EASEMENT LINE
	CONCRETE
	EVERGREEN/DECIDUOUS WITH SIZE IN INCHES
	GAS VALVE
	MANHOLE
	FIRE HYDRANT
	B-BOX / SERVICE VALVE
	POST LIGHT/GROUND LIGHT
	FENCE LINE
	OVERHEAD LINE
	TYPICAL SIGN
	UTILITY POLE
	PEDESTAL (telco, elec, cable)
	GAS METER
	ELECTRIC METER
	U.G. TELCO LINE
	U.G. ELECTRIC LINE
	FIBER OPTIC LINE

Eco-Site[®]
240 LEIGH FARM ROAD, SUITE 415
DURHAM, NC 27707

PROJECT INFORMATION:

94TH AVENUE / IL0130

15655 S. RAVINIA AVE.
ORLAND PARK, IL 60462
COOK COUNTY
S16218

CURRENT ISSUE DATE:

6/28/18

ISSUED FOR:	
REV.	DATE
1	11/29/16
2	3/20/17
3	10/30/17
4	3/2/18
5	4/11/18
6	6/28/18

CONSULTANT:

WT Group

Engineering • Design • Consulting

2675 Pratum Avenue
Hoffman Estates, Illinois 60192
PH: (224) 293-6333 FAX: (224) 293-6444
www.wtengineering.com

IL License No.: 184 007570-0015 Exp: 04/30/19

COPYRIGHT © 2018 THE WT GROUP, LLC

DRAWN BY:	CHK:	APV:
KCH	FIM	FIM


LICENSER:

FRANK I. MATIĆ
PROFESSIONAL LAND SURVEYOR
STATE OF ILLINOIS
LICENSE # 035-003556
EXPIRES: 11/30/2019 SIGNED: 6/28/18

SHEET TITLE:

SURVEY

SHEET NUMBER:	REVISION:
S-4	6
OF 6 SHEETS	

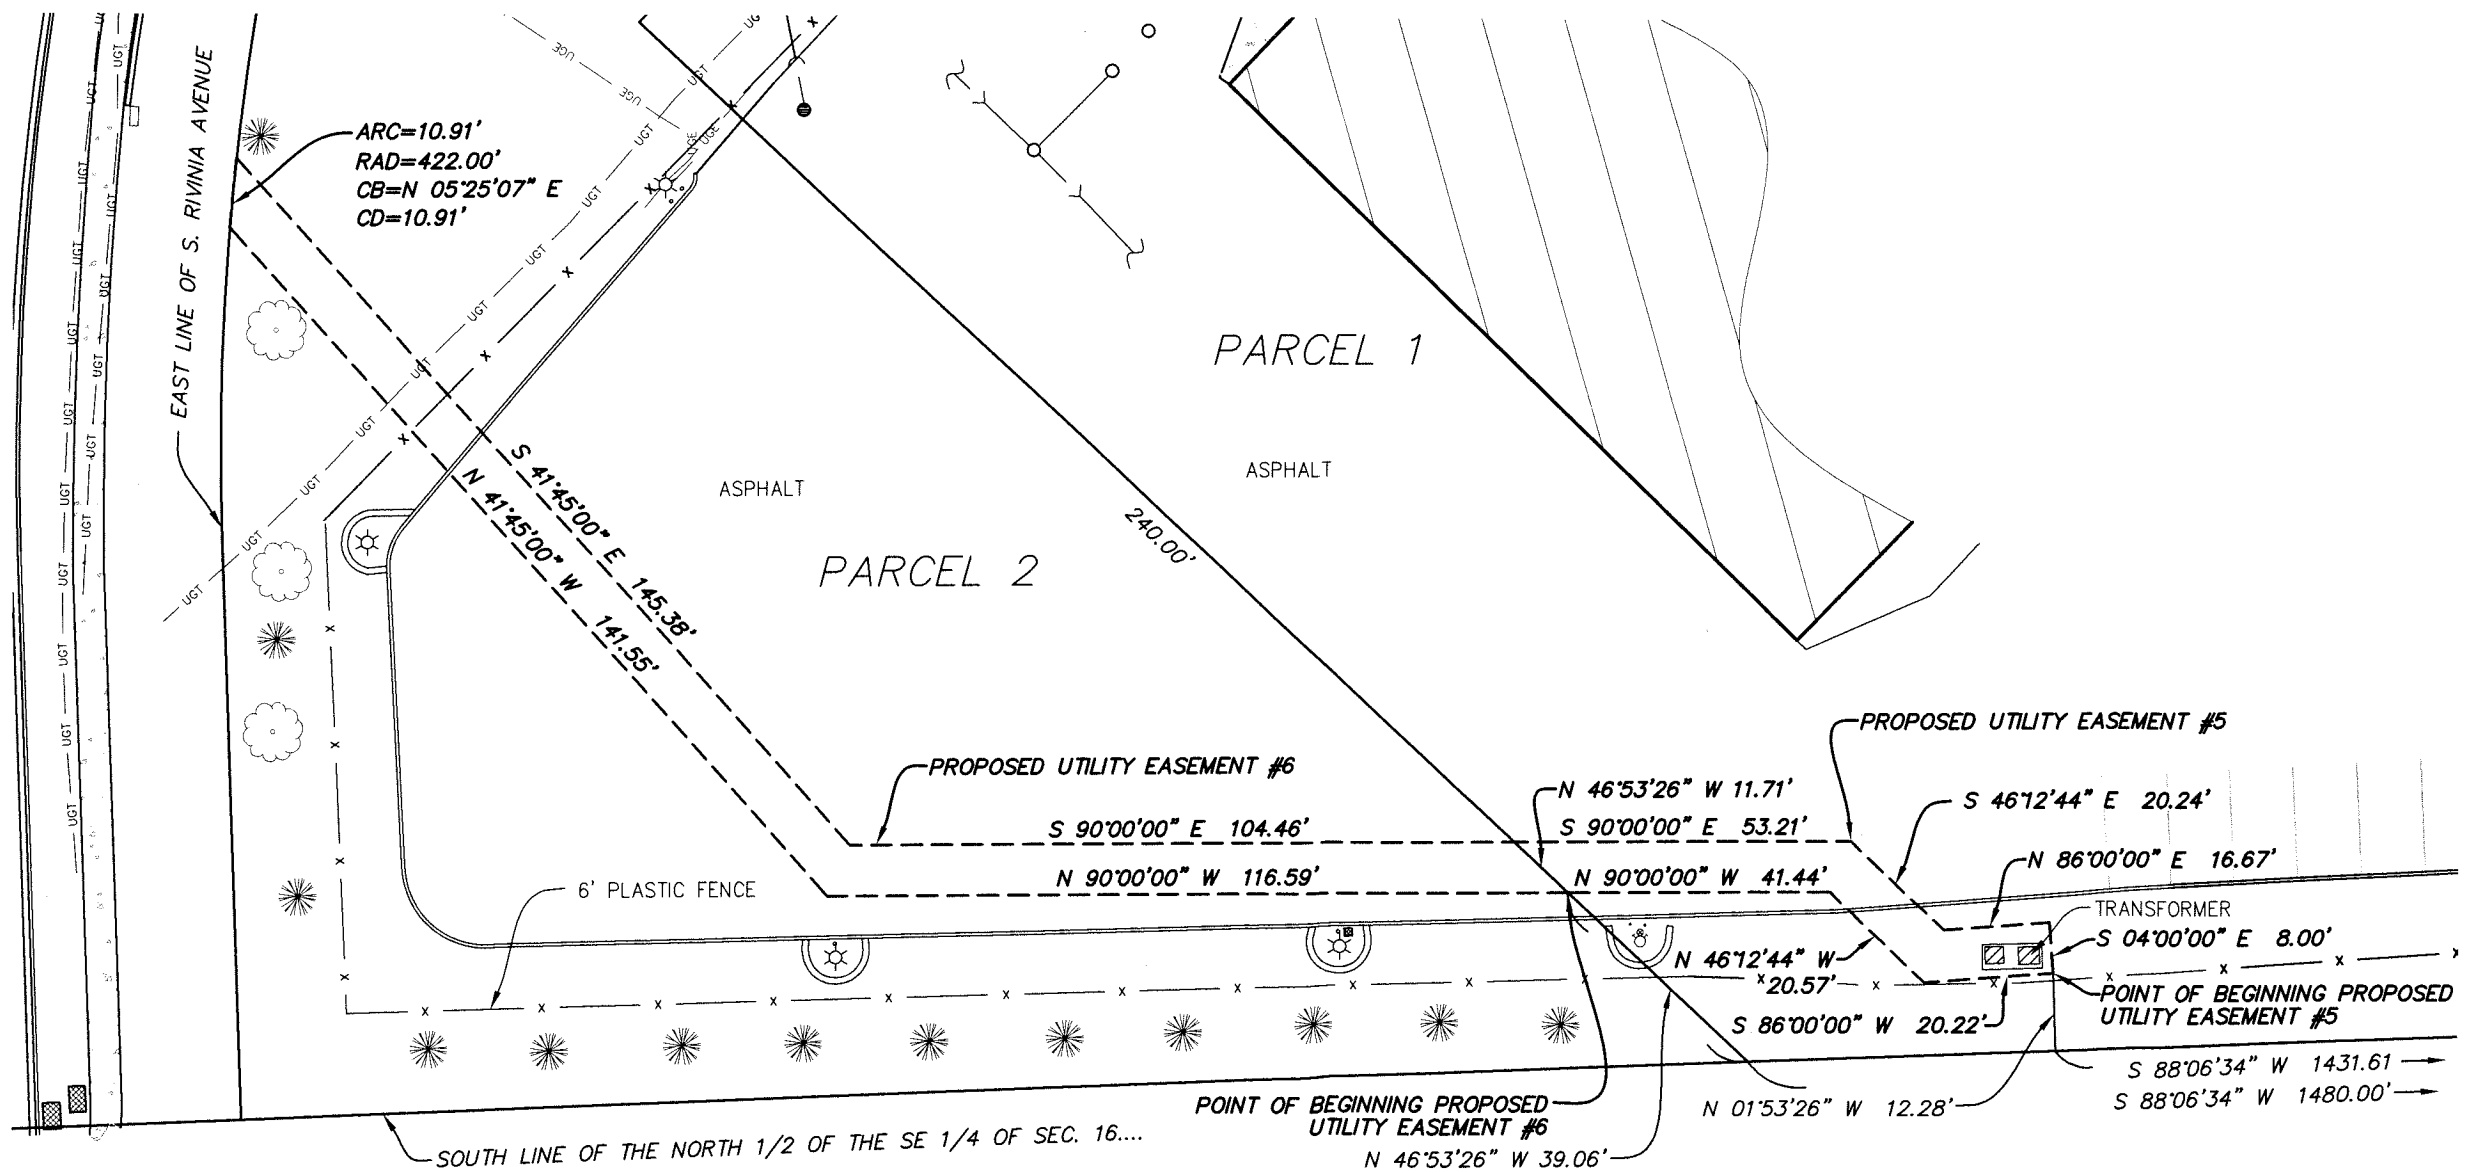

PROPOSED ECO-SITE LEASE AREA DESCRIPTION

THAT PART OF THE NORTH HALF OF THE SOUTHEAST QUARTER OF SECTION 16, TOWNSHIP 36 NORTH, RANGE 12 EAST OF THE THIRD PRINCIPAL MERIDIAN IN COOK COUNTY, ILLINOIS, DESCRIBED AS FOLLOWS: COMMENCING AT THE SOUTHEAST CORNER OF THE NORTH HALF OF THE SOUTHEAST QUARTER OF SAID SECTION 16; THENCE SOUTH 88 DEGREES 06 MINUTES 34 SECONDS WEST ALONG THE SOUTH LINE OF SAID NORTH HALF, 1218.80 FEET; THENCE NORTH 43 DEGREES 06 MINUTES 34 SECONDS EAST ALONG THE SOUTHEASTERLY PROPERTY LINE OF PARCEL 1 OF THE PARENT PARCEL, 725.30 FEET TO THE NORTHEASTERLY CORNER OF SAID PARCEL ONE; THENCE NORTH 46 DEGREES 53 MINUTES 26 SECONDS WEST ALONG THE NORTHEASTERLY PROPERTY LINE OF SAID PARCEL 1 A DISTANCE OF 164.08 FEET; THENCE SOUTH 43 DEGREES 06 MINUTES 34 SECONDS WEST, 11.60 TO THE POINT OF BEGINNING; THENCE CONTINUING SOUTH 43 DEGREES 06 MINUTES 34 SECONDS WEST, 50.00 FEET; THENCE NORTH 46 DEGREES 53 MINUTES 26 SECONDS WEST, 50.00 FEET; THENCE NORTH 43 DEGREES 06 MINUTES 34 SECONDS EAST, 50.00 FEET TO A POINT ON SAID NORTHEASTERLY LINE; THENCE SOUTH 46 DEGREES 53 MINUTES 26 SECONDS EAST ALONG SAID LINE, 50.00 FEET TO THE POINT OF BEGINNING, CONTAINING 2,500.00 SQUARE FEET, ALL IN COOK COUNTY, ILLINOIS.

PROPOSED T-MOBILE LEASE AREA DESCRIPTION

THAT PART OF THE NORTH HALF OF THE SOUTHEAST QUARTER OF SECTION 16, TOWNSHIP 36 NORTH, RANGE 12 EAST OF THE THIRD PRINCIPAL MERIDIAN IN COOK COUNTY, ILLINOIS, DESCRIBED AS FOLLOWS: COMMENCING AT THE SOUTHEAST CORNER OF THE NORTH HALF OF THE SOUTHEAST QUARTER OF SAID SECTION 16; THENCE SOUTH 88 DEGREES 06 MINUTES 34 SECONDS WEST ALONG THE SOUTH LINE OF SAID NORTH HALF, 1218.80 FEET; THENCE NORTH 43 DEGREES 06 MINUTES 34 SECONDS EAST ALONG THE SOUTHEASTERLY PROPERTY LINE OF PARCEL 1 OF THE PARENT PARCEL, 725.30 FEET TO THE NORTHEASTERLY CORNER OF SAID PARCEL 1; THENCE NORTH 46 DEGREES 53 MINUTES 26 SECONDS WEST ALONG THE NORTHEASTERLY PROPERTY LINE OF SAID PARCEL 1 A DISTANCE OF 164.08 FEET; THENCE SOUTH 43 DEGREES 06 MINUTES 34 SECONDS WEST, 57.60 FEET; THENCE NORTH 46 DEGREES 53 MINUTES 26 SECONDS WEST, 36.00 FEET TO THE POINT OF BEGINNING; THENCE CONTINUING NORTH 46 DEGREES 53 MINUTES 26 SECONDS WEST, 10.00 FEET; THENCE NORTH 43 DEGREES 06 MINUTES 34 SECONDS EAST, 15.00 FEET; THENCE SOUTH 46 DEGREES 53 MINUTES 26 SECONDS EAST, 10.00 FEET; THENCE SOUTH 43 DEGREES 06 MINUTES 34 SECONDS WEST, 15.00 FEET TO THE POINT OF BEGINNING, CONTAINING 150.00 SQUARE FEET, ALL IN COOK COUNTY, ILLINOIS.

PROPOSED ACCESS EASEMENT DESCRIPTION

THAT PART OF THE NORTH HALF OF THE SOUTHEAST QUARTER OF SECTION 16, TOWNSHIP 36 NORTH, RANGE 12 EAST OF THE THIRD PRINCIPAL MERIDIAN IN COOK COUNTY, ILLINOIS, DESCRIBED AS FOLLOWS: COMMENCING AT THE SOUTHEAST CORNER OF THE NORTH HALF OF THE SOUTHEAST QUARTER OF SAID SECTION 16; THENCE SOUTH 88 DEGREES 06 MINUTES 34 SECONDS WEST ALONG THE SOUTH LINE OF SAID NORTH HALF, 1218.80 FEET; THENCE NORTH 43 DEGREES 06 MINUTES 34 SECONDS EAST ALONG THE SOUTHEASTERLY PROPERTY LINE OF PARCEL 1 OF THE PARENT PARCEL, 725.30 FEET TO THE NORTHEASTERLY CORNER OF PARCEL 1; THENCE NORTH 46 DEGREES 53 MINUTES 26 SECONDS WEST ALONG THE NORTHEASTERLY PROPERTY LINE OF SAID PARCEL 1 A DISTANCE OF 214.08 FEET; THENCE SOUTH 43 DEGREES 06 MINUTES 34 SECONDS WEST, 11.60 FEET TO THE NORTHERLY MOST CORNER OF THE AFORESAID LEASE AREA, SAID POINT ALSO BEING THE POINT OF BEGINNING; THENCE SOUTH 43 DEGREES 06 MINUTES 34 SECONDS WEST ALONG THE NORTHWEST LINE OF SAID LEASE AREA, 20.00 FEET; THENCE NORTH 47 DEGREES 07 MINUTES 19 SECONDS WEST, 24.67 FEET; THENCE SOUTH 43 DEGREES 06 MINUTES 34 SECONDS WEST, 69.47 FEET; THENCE NORTH 47 DEGREES 29 MINUTES 28 SECONDS WEST, 88.79 FEET; THENCE NORTH 27 DEGREES 25 MINUTES 46 SECONDS WEST, 106.71 FEET; THENCE NORTH 46 DEGREES 47 MINUTES 54 SECONDS WEST, 68.25 FEET TO THE EAST LINE OF SOUTH RAVINIA AVENUE; THENCE NORTH 56 DEGREES 29 MINUTES 16 SECONDS EAST ALONG SAID EAST LINE, 20.55 FEET; THENCE SOUTH 46 DEGREES 47 MINUTES 54 SECONDS EAST, 66.94 FEET; THENCE SOUTH 27 DEGREES 25 MINUTES 46 SECONDS EAST, 106.58 FEET; THENCE SOUTH 47 DEGREES 29 MINUTES 28 SECONDS EAST, 65.43 FEET; THENCE NORTH 43 DEGREES 06 MINUTES 34 SECONDS EAST, 69.60 FEET; THENCE SOUTH 47 DEGREES 07 MINUTES 19 SECONDS EAST, 44.70 FEET TO THE POINT OF BEGINNING, CONTAINING 7,113.22 SQUARE FEET, ALL IN COOK COUNTY, ILLINOIS.

PROPOSED UTILITY EASEMENT #1 DESCRIPTION

THAT PART OF THE NORTH HALF OF THE SOUTHEAST QUARTER OF SECTION 16, TOWNSHIP 36 NORTH, RANGE 12 EAST OF THE THIRD PRINCIPAL MERIDIAN IN COOK COUNTY, ILLINOIS, DESCRIBED AS FOLLOWS: COMMENCING AT THE SOUTHEAST CORNER OF THE NORTH HALF OF THE SOUTHEAST QUARTER OF SAID SECTION 16; THENCE SOUTH 88 DEGREES 06 MINUTES 34 SECONDS WEST ALONG THE SOUTH LINE OF SAID NORTH HALF, 1218.80 FEET; THENCE NORTH 43 DEGREES 06 MINUTES 34 SECONDS EAST ALONG THE SOUTHEASTERLY PROPERTY LINE OF PARCEL 1 OF THE PARENT PARCEL, 725.30 FEET TO THE NORTHEASTERLY CORNER OF SAID PARCEL 1; THENCE NORTH 46 DEGREES 53 MINUTES 26 SECONDS WEST ALONG THE NORTHEASTERLY PROPERTY LINE OF SAID PARCEL 1 A DISTANCE OF 156.08 FEET TO THE POINT OF BEGINNING; THENCE CONTINUING NORTH 46 DEGREES 53 MINUTES 26 SECONDS WEST, 268.62 FEET TO THE WEST LINE OF SAID PARCEL 1; THENCE NORTH DEGREES 06 MINUTES 34 SECONDS EAST ALONG SAID WEST LINE, 8.00 FEET; THENCE SOUTH 46 DEGREES 53 MINUTES 26 SECONDS EAST, 268.62 FEET; THENCE SOUTH 43 DEGREES 06 MINUTES 34 SECONDS WEST, 8.00 FEET TO SAID NORTHEASTERLY LINE OF PARCEL 1, SAID POINT ALSO BEING THE POINT OF BEGINNING, CONTAINING 2148.99 SQUARE FEET, ALL IN COOK COUNTY, ILLINOIS.

PROPOSED UTILITY EASEMENT #2 DESCRIPTION

THAT PART OF THE NORTH HALF OF THE SOUTHEAST QUARTER OF SECTION 16, TOWNSHIP 36 NORTH, RANGE 12 EAST OF THE THIRD PRINCIPAL MERIDIAN IN COOK COUNTY, ILLINOIS, DESCRIBED AS FOLLOWS: COMMENCING AT THE SOUTHEAST CORNER OF THE NORTH HALF OF THE SOUTHEAST QUARTER OF SAID SECTION 16; THENCE SOUTH 88 DEGREES 06 MINUTES 34 SECONDS WEST ALONG THE SOUTH LINE OF SAID NORTH HALF, 1218.80 FEET; THENCE NORTH 43 DEGREES 06 MINUTES 34 SECONDS EAST ALONG THE SOUTHEASTERLY PROPERTY LINE OF PARCEL 1 OF THE PARENT PARCEL, 725.30 FEET TO THE NORTHEASTERLY CORNER OF SAID PARCEL 1; THENCE NORTH 46 DEGREES 53 MINUTES 26 SECONDS WEST ALONG THE NORTHEASTERLY PROPERTY LINE OF SAID PARCEL 1 A DISTANCE OF 156.08 FEET; THENCE CONTINUING NORTH 46 DEGREES 53 MINUTES 26 SECONDS WEST, 268.62 FEET TO THE WEST LINE OF SAID PARCEL 1, SAID POINT ALSO BEING THE POINT OF BEGINNING; THENCE NORTH 46 DEGREES 53 MINUTES 26 SECONDS WEST, 55.90 FEET TO THE EAST LINE OF RAVINIA STREET; THENCE NORTH 56 DEGREES 29 MINUTES 16 SECONDS EAST ALONG SAID EAST LINE, 8.22 FEET; THENCE SOUTH 46 DEGREES 53 MINUTES 26 SECONDS EAST, 54.00 FEET TO SAID WEST LINE OF PARCEL 1; THENCE SOUTH 43 DEGREES 06 MINUTES 34 SECONDS WEST ALONG SAID WEST LINE, 8.00 FEET TO THE POINT OF BEGINNING, CONTAINING 439.59 SQUARE FEET, ALL IN COOK COUNTY, ILLINOIS.

PROPOSED UTILITY EASEMENT #3 DESCRIPTION

THAT PART OF THE NORTH HALF OF THE SOUTHEAST QUARTER OF SECTION 16, TOWNSHIP 36 NORTH, RANGE 12 EAST OF THE THIRD PRINCIPAL MERIDIAN IN COOK COUNTY, ILLINOIS, DESCRIBED AS FOLLOWS: COMMENCING AT THE SOUTHEAST CORNER OF THE NORTH HALF OF THE SOUTHEAST QUARTER OF SAID SECTION 16; THENCE SOUTH 88 DEGREES 06 MINUTES 34 SECONDS WEST ALONG THE SOUTH LINE OF SAID NORTH HALF, 1218.80 FEET; THENCE NORTH 43 DEGREES 06 MINUTES 34 SECONDS EAST ALONG THE SOUTHEASTERLY PROPERTY LINE OF PARCEL 1 OF THE PARENT PARCEL, 725.30 FEET TO THE NORTHEASTERLY CORNER OF SAID PARCEL 1; THENCE NORTH 46 DEGREES 53 MINUTES 26 SECONDS WEST ALONG THE NORTHEASTERLY PROPERTY LINE OF SAID PARCEL 1 A DISTANCE OF 156.08 FEET; THENCE SOUTH 43 DEGREES 06 MINUTES 34 SECONDS WEST, 11.60 FEET; THENCE NORTH 46 DEGREES 53 MINUTES 26 SECONDS WEST, 8.00 FEET TO THE EASTERLY MOST CORNER OF THE AFORESAID LEASE AREA, SAID POINT ALSO BEING THE POINT OF BEGINNING; THENCE NORTH 46 DEGREES 53 MINUTES 26 SECONDS WEST ALONG THE NORTHEASTERLY LINE OF SAID LEASE AREA, 50.00 FEET; THENCE NORTH 43 DEGREES 06 MINUTES 34 SECONDS EAST, 11.60 FEET TO SAID NORTHEASTERLY LINE OF PARCEL 1; THENCE SOUTH 46 DEGREES 53 MINUTES 26 SECONDS EAST ALONG SAID NORTHEASTERLY LINE, 50.00 FEET; THENCE SOUTH 43 DEGREES 06 MINUTES 34 SECONDS WEST, 11.60 FEET TO THE POINT OF BEGINNING, CONTAINING 579.86 SQUARE FEET, ALL IN COOK COUNTY, ILLINOIS.

PROPOSED UTILITY EASEMENT #4 DESCRIPTION

THAT PART OF THE NORTH HALF OF THE SOUTHEAST QUARTER OF SECTION 16, TOWNSHIP 36 NORTH, RANGE 12 EAST OF THE THIRD PRINCIPAL MERIDIAN IN COOK COUNTY, ILLINOIS, DESCRIBED AS FOLLOWS: COMMENCING AT THE SOUTHEAST CORNER OF THE NORTH HALF OF THE SOUTHEAST QUARTER OF SAID SECTION 16; THENCE SOUTH 88 DEGREES 06 MINUTES 34 SECONDS WEST ALONG THE SOUTH LINE OF SAID NORTH HALF, 1218.80 FEET; THENCE NORTH 43 DEGREES 06 MINUTES 34 SECONDS EAST ALONG THE SOUTHEASTERLY PROPERTY LINE OF PARCEL 1 OF THE PARENT PARCEL, 725.30 FEET TO THE NORTHEASTERLY CORNER OF SAID PARCEL 1; THENCE NORTH 46 DEGREES 53 MINUTES 26 SECONDS WEST ALONG THE NORTHEASTERLY PROPERTY LINE OF SAID PARCEL 1 A DISTANCE OF 156.08 FEET TO THE POINT OF BEGINNING; THENCE SOUTH 43 DEGREES 06 MINUTES 34 SECONDS WEST, 11.60 FEET; THENCE NORTH 46 DEGREES 53 MINUTES 26 SECONDS WEST, 8.00 FEET TO THE EASTERLY MOST CORNER OF THE AFORESAID LEASE AREA; THENCE NORTH 43 DEGREES 06 MINUTES 34 SECONDS EAST, 11.60 FEET TO SAID NORTHEASTERLY LINE OF PARCEL 1; THENCE SOUTH 46 DEGREES 53 MINUTES 26 SECONDS EAST ALONG SAID NORTHEASTERLY LINE, 8.00 FEET TO THE POINT OF BEGINNING, CONTAINING 92.78 SQUARE FEET, ALL IN COOK COUNTY, ILLINOIS.

PROPOSED UTILITY EASEMENT #5 DESCRIPTION

THAT PART OF THE NORTH HALF OF THE SOUTHEAST QUARTER OF SECTION 16, TOWNSHIP 36 NORTH, RANGE 12 EAST OF THE THIRD PRINCIPAL MERIDIAN IN COOK COUNTY, ILLINOIS, DESCRIBED AS FOLLOWS: COMMENCING AT THE SOUTHEAST CORNER OF THE NORTH HALF OF THE SOUTHEAST QUARTER OF SAID SECTION 16; THENCE SOUTH 88 DEGREES 06 MINUTES 34 SECONDS WEST ALONG THE SOUTH LINE OF SAID NORTH HALF, 1431.61 FEET; THENCE NORTH 01 DEGREES 53 MINUTES 26 SECONDS WEST, 12.28 FEET TO THE POINT OF BEGINNING; THENCE SOUTH 86 DEGREES 00 MINUTES 00 SECONDS WEST, 20.22 FEET; THENCE NORTH 46 DEGREES 12 MINUTES 44 SECONDS WEST, 20.57 FEET; THENCE NORTH 90 DEGREES 00 MINUTES 00 SECONDS WEST, 41.44 FEET TO THE WEST LINE OF PARCEL 1 OF THE PARENT PARCEL; THENCE NORTH 46 DEGREES 53 MINUTES 26 SECONDS WEST ALONG SAID WEST LINE, 11.71 FEET; THENCE SOUTH 90 DEGREES 00 MINUTES 00 SECONDS EAST, 53.21 FEET; THENCE SOUTH 46 DEGREES 12 MINUTES 44 SECONDS EAST, 20.24 FEET; THENCE NORTH 86 DEGREES 00 MINUTES 00 SECONDS EAST, 16.67 FEET; THENCE SOUTH 04 DEGREES 00 MINUTES 00 SECONDS EAST, 8.00 FEET TO THE POINT OF BEGINNING, CONTAINING 689.43 SQUARE FEET, ALL IN COOK COUNTY, ILLINOIS.

PROPOSED UTILITY EASEMENT #6 DESCRIPTION

THAT PART OF THE NORTH HALF OF THE SOUTHEAST QUARTER OF SECTION 16, TOWNSHIP 36 NORTH, RANGE 12 EAST OF THE THIRD PRINCIPAL MERIDIAN IN COOK COUNTY, ILLINOIS, DESCRIBED AS FOLLOWS: COMMENCING AT THE SOUTHEAST CORNER OF THE NORTH HALF OF THE SOUTHEAST QUARTER OF SAID SECTION 16; THENCE SOUTH 88 DEGREES 06 MINUTES 34 SECONDS WEST ALONG THE SOUTH LINE OF SAID NORTH HALF, 1480.00 FEET TO THE SOUTHWEST CORNER OF PARCEL 1 OF THE PARENT PARCEL; THENCE NORTH 46 DEGREES 53 MINUTES 26 SECONDS WEST ALONG THE WEST LINE OF SAID PARCEL 1, 39.06 FEET; THENCE NORTH 90 DEGREES 00 MINUTES 00 SECONDS WEST, 116.59 FEET; THENCE NORTH 41 DEGREES 45 MINUTES 00 SECONDS WEST, 141.55 FEET TO THE EAST RIGHT OF WAY LINE OF RAVINIA AVENUE; THENCE NORTHEASTERLY ALONG SAID EAST RIGHT OF WAY LINE 10.91 FEET BEING A CURVE TO THE RIGHT, HAVING A RADIUS OF 422.00 FEET (CHORD BEARS NORTH 05 DEGREES 25 MINUTES 07 SECONDS EAST, 10.91 FEET); THENCE SOUTH 41 DEGREES 45 MINUTES 00 SECONDS EAST, 145.38 FEET; THENCE SOUTH 90 DEGREES 00 MINUTES 00 SECONDS EAST, 104.46 FEET TO SAID WEST LINE OF PARCEL 1; THENCE SOUTH 46 DEGREES 53 MINUTES 26 SECONDS EAST ALONG SAID WEST LINE, 11.71 FEET TO THE POINT OF BEGINNING, CONTAINING 2031.96 SQUARE FEET, ALL IN COOK COUNTY, ILLINOIS.

Eco-Site

240 LEIGH FARM ROAD, SUITE 415
DURHAM, NC 27707

PROJECT INFORMATION:

94TH AVENUE / IL0130

15855 S. RAVINIA AVE.
ORLAND PARK, IL 60482
COOK COUNTY
S18218

CURRENT ISSUE DATE:

6/28/18

ISSUED FOR:

REV.	DATE	ISSUED FOR:	BY:
1	11/29/16	PER COMMENTS	KCH
2	3/20/17	REVISED LEASE AREA REVISED EASEMENTS	RM
3	10/30/17	PER COMMENTS	KCH
4	3/2/18	AS-BUILT	KCH
5	4/11/18	REVISED EASEMENTS	REM
6	6/28/18	REVISED EASEMENTS	KCH

CONSULTANT:

WT
Group

Engineering • Design • Consulting

2675 Pratum Avenue
Hoffman Estates, Illinois 60192
PH: (224) 293-6333 FAX: (224) 293-6444
www.wtengineering.com

IL License No.: 184.007570-0015 Exp: 04/30/19

COPYRIGHT © 2018 THE W-T GROUP, LLC

DRAWN BY:

CHK:

APV:

KCH

FIM

FIM

LICENSER:

FRANK I. MATIJC
PROFESSIONAL LAND SURVEYOR
STATE OF ILLINOIS
LICENSE # 035-003556

EXPIRES: 11/30/2019 SIGNED: 6/28/18

SHEET TITLE:

SURVEY

SHEET NUMBER:

REVISION:

S-5

6

OF 6 SHEETS

PARCEL ONE

ALSO:

PARCEL 2 PER DOCUMENT #99119453 DATED 02/04/1999

NOTES:

- STATE OF ILLINOIS)
) SS
COUNTY OF COOK)

WE W-T LAND SURVEYING DO HEREBY DECLARE THAT WE HAVE SURVEYED THE ABOVE DESCRIBED PROPOSED LEASE AREA AND THAT THIS PLAT IS A CORRECT REPRESENTATION OF SAID SURVEY.

THE WT GROUP, LLC

PROFESSIONAL LAND SURVEYOR
 FRANJO I. MATICIC
 035-003556
 HOFFMAN ESTATES ILLINOIS
 STATE OF ILLINOIS

240 LEIGH FARM ROAD, SUITE 415
DURHAM, NC 27707

PROJECT INFORMATION:

94TH AVENUE / IL0130

15655 S. RAVINIA AVE.
ORLAND PARK, IL 60462
COOK COUNTY
S16218

☐ CURRENT ISSUE DATE:

6/28/18

ISSUED FOR:

[illegible]

☐ CONSULTANT:



Engineering • Design • Consulting

2675 Pratum Avenue
Hoffman Estates, Illinois 60192
PH: (224) 293-6333 FAX: (224) 293-6444
www.wfengengineering.com

COPYRIGHT © 2018 THE W-T GROUP, LLC

DRAWN BY:	CHK:	APV:
KCH	FIM	F

☐ LICENSER

FRANK I. MATICIC
PROFESSIONAL LAND SURVEYOR
STATE OF ILLINOIS
LICENSE # 035-003556
EXPIRES: 11/30/2019 SIGNED: 6/28/

SHEET TITLE:

SURVEY

SHEET NUMBER: REVISION

S-6

6

OF 6 SHEETS