
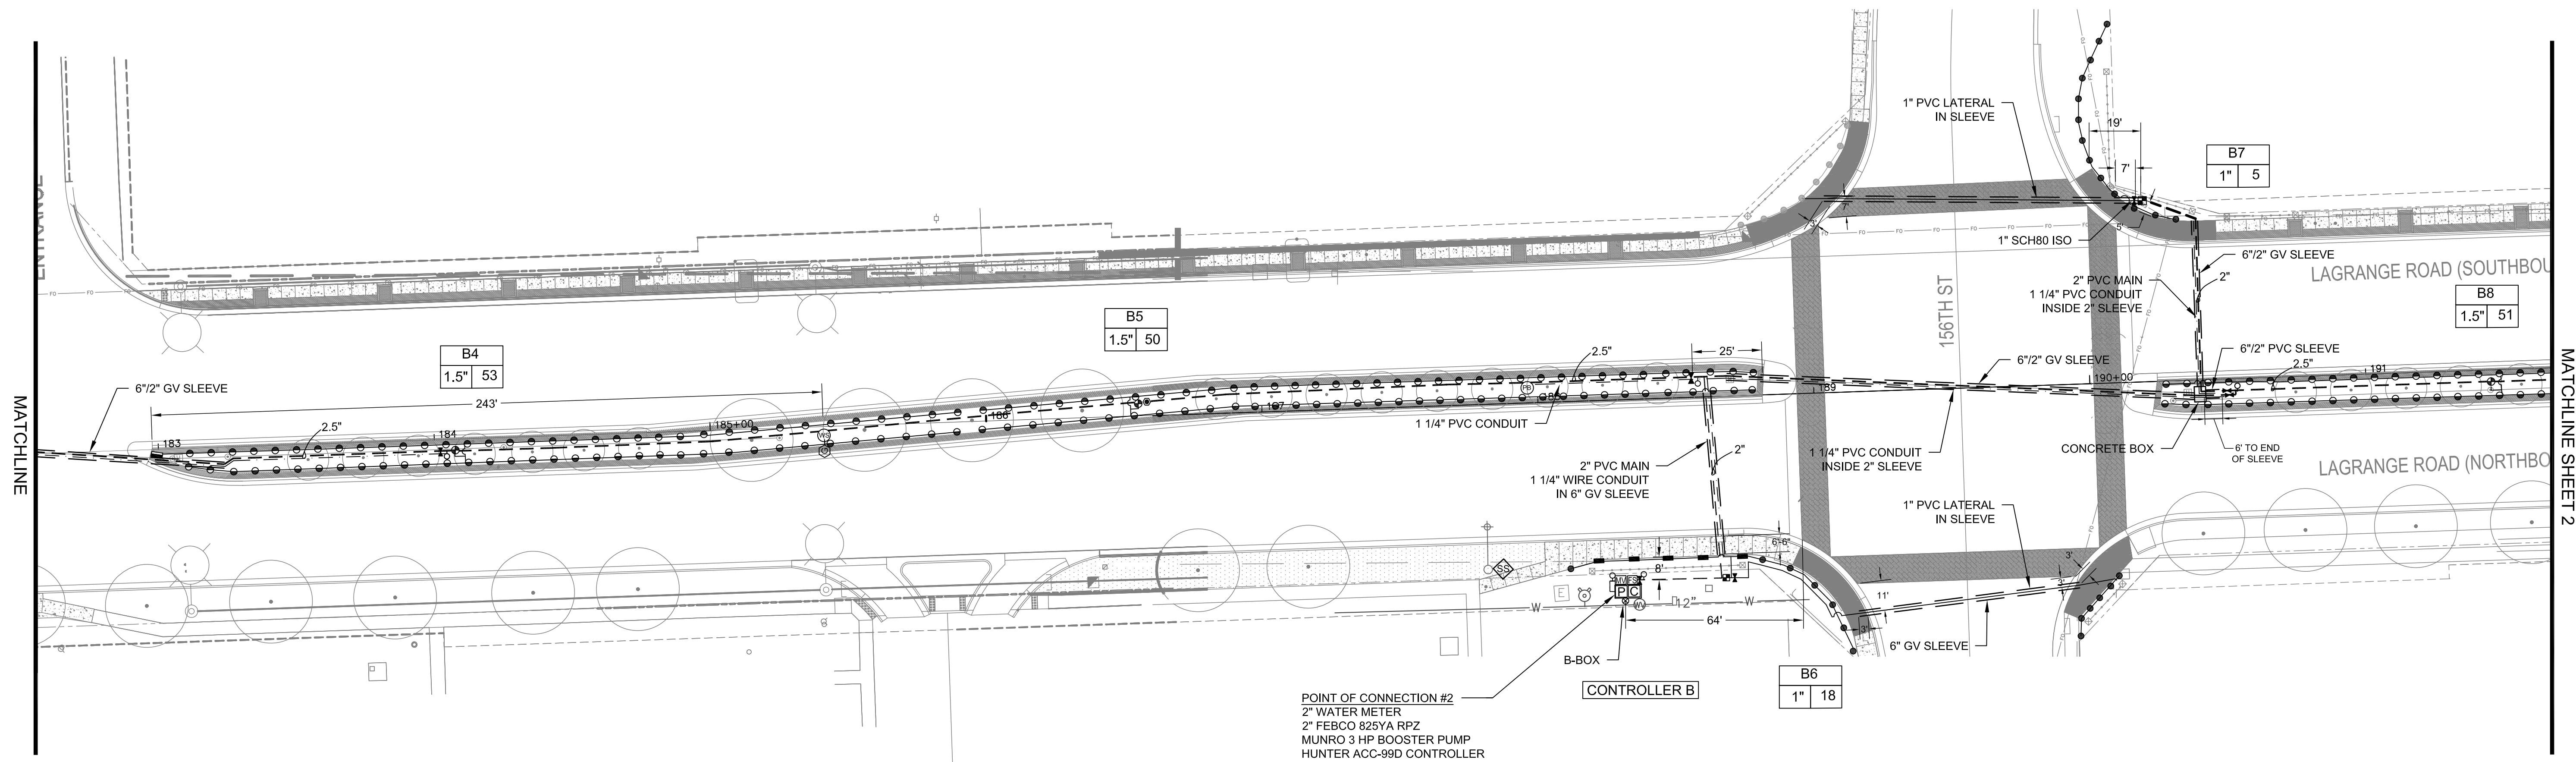
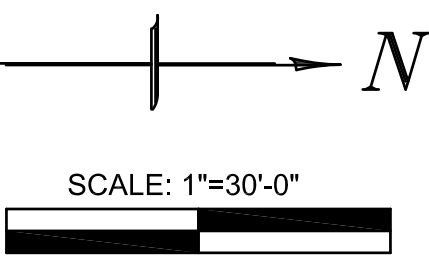


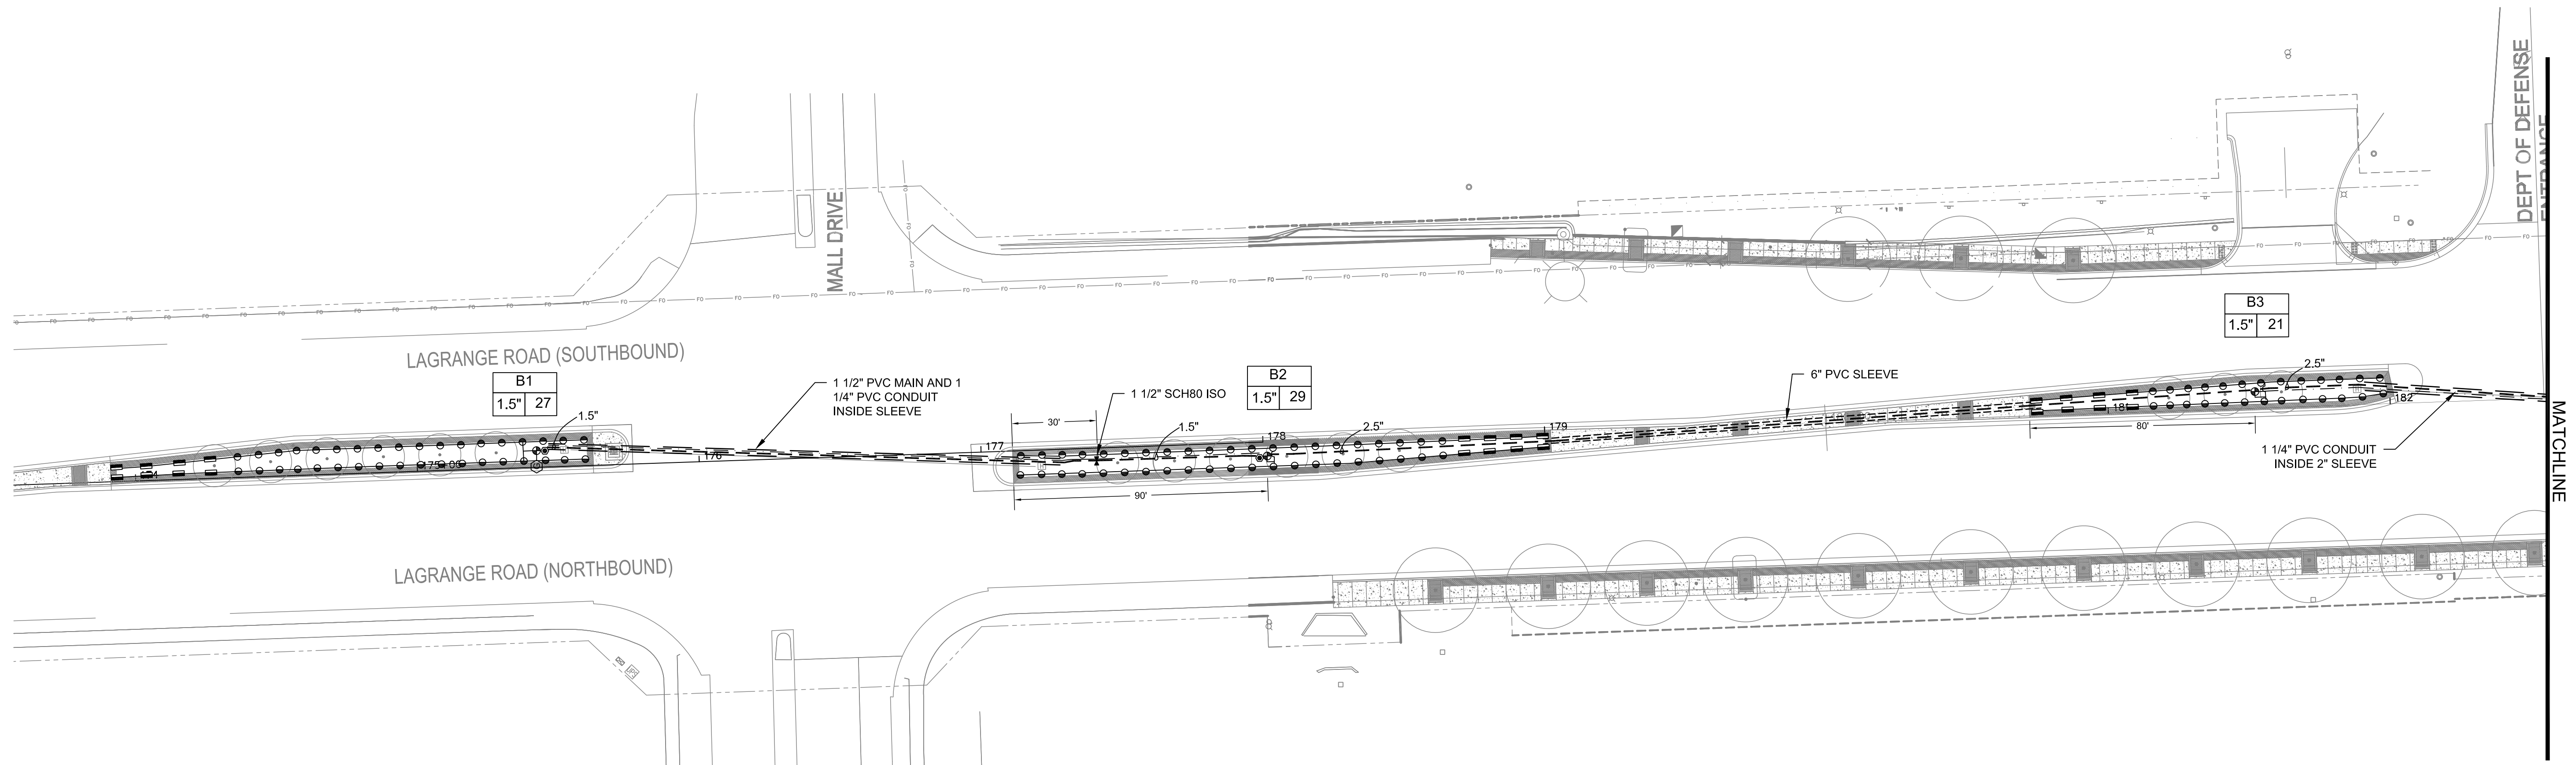

LEGEND




- HUNTER 4" SPRAY HEAD, 8' - 17' RADIUS
- HUNTER 12" SPRAY HEAD, 8' - 17' RADIUS
- HUNTER 4" SPRAY HEAD 15' STRIP
- HUNTER 12" SPRAY HEAD 15' STRIP
- ⊕ HUNTER ICV 1.5" ELECTRIC VALVE
- ⊕ HUNTER ICV 1" ELECTRIC VALVE
- ⋈ LEEMCO MANUAL ISOLATION VALVE
- ⊙ HUNTER 1" QUICK COUPLER
- POLY HD LATERAL PIPE
- 3" PVC CL200 SDR21 MAINLINE PIPE
- IRRIGATION SLEEVE
- ⊠ HUNTER ACC-D DECODER CONTROLLER
- ⊠ HUNTER SOLAR SYNC WEATHER SENSOR
- ⊠ IRRIGATION BOOSTER PUMP STATION
- ⊠ B-BOX

CENTRAL
Lawn Sprinklers Inc.

239 King Street • Elk Grove Village, IL 60007 • Phone: (847) 364-6900 • Fax: (847) 364-9774

LAGRANGE ROAD IMPROVEMENTS
ORLAND PARK, ILLINOIS
Segment 2 - 159th St to 143rd St
IRRIGATION AS-BUILT

PROJECT NO.	15780
DESIGNED BY:	KM
DRAWN BY:	KM
CHECKED BY:	JC
DATE:	OCT 31, 2017
SCALE:	1" = 30'
SHEET	1

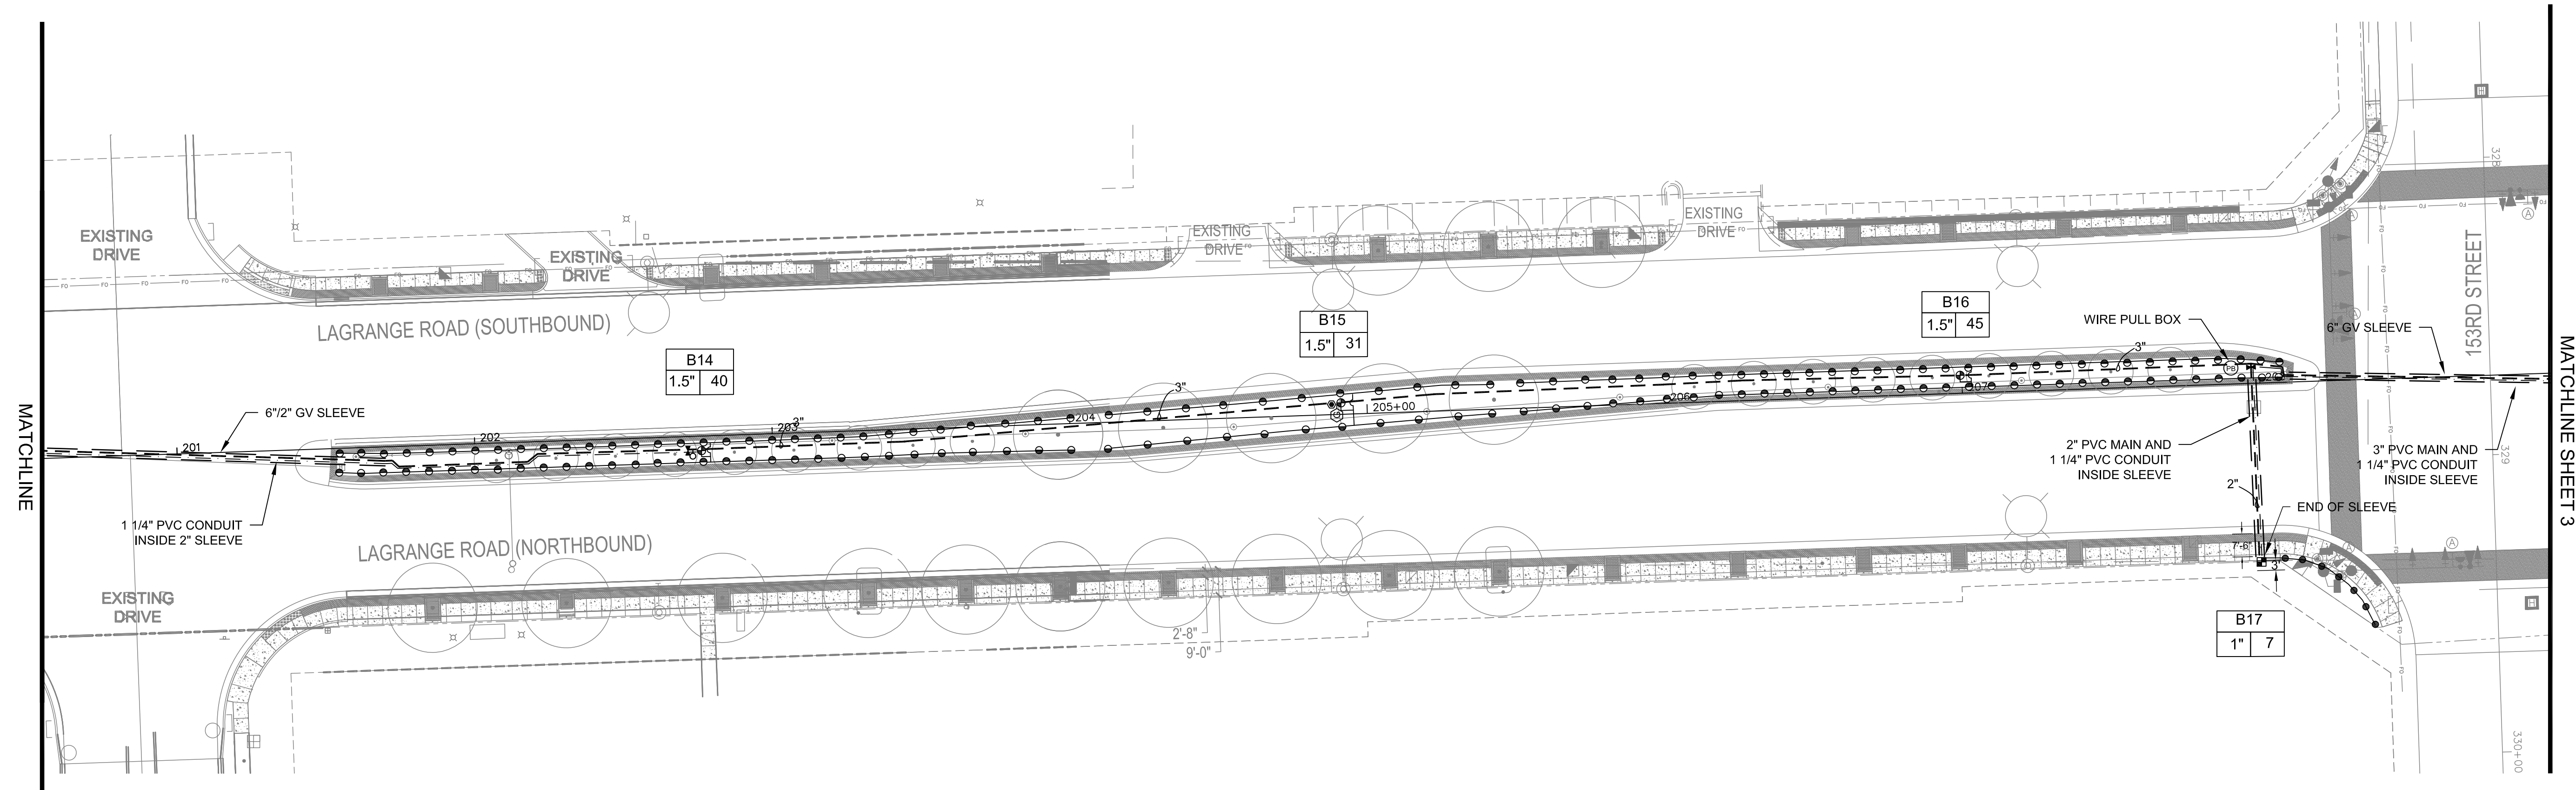
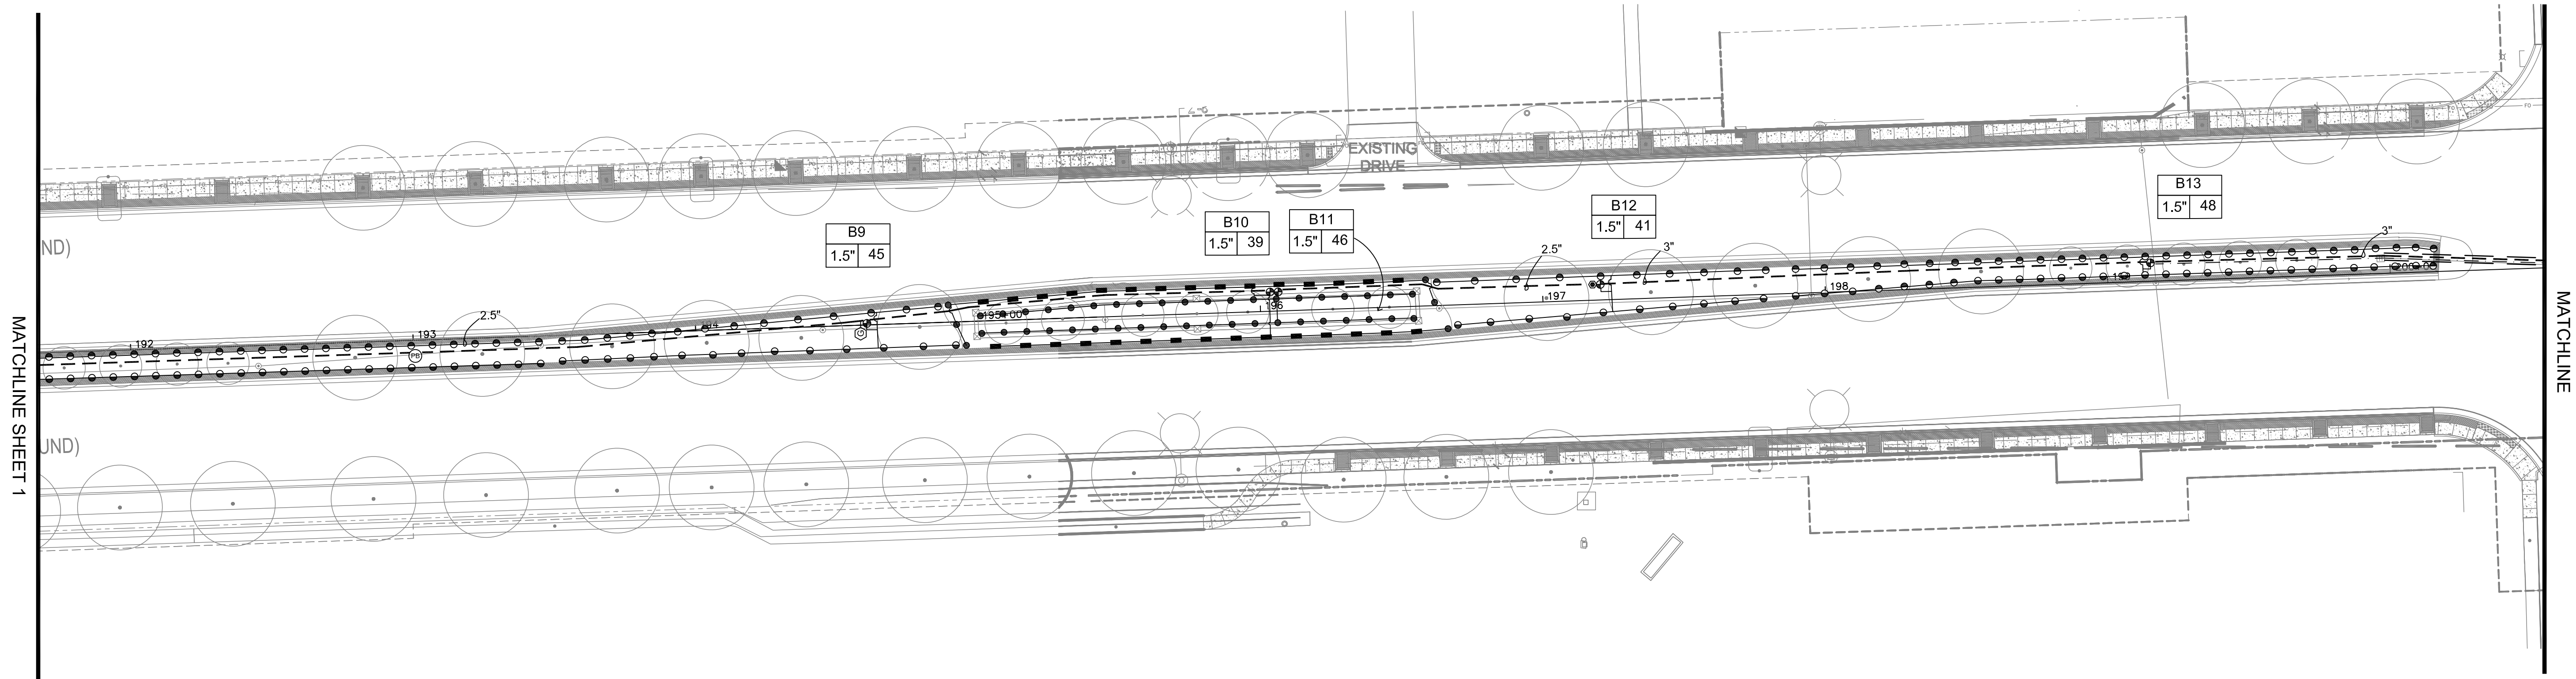
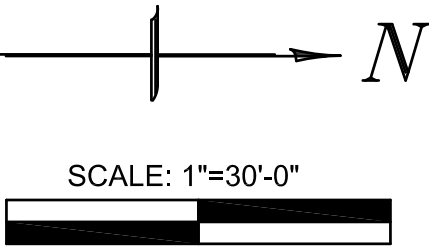


LEGEND	
HUNTER 4" SPRAY HEAD, 8' - 17' RADIUS	POLY HD LATERAL PIPE
HUNTER 12" SPRAY HEAD, 8' - 17' RADIUS	3" PVC CL200 SDR21 MAINLINE PIPE
HUNTER 4" SPRAY HEAD 15' STRIP	IRRIGATION SLEEVE
HUNTER 12" SPRAY HEAD 15' STRIP	HUNTER ACC-D DECODER CONTROLLER
HUNTER ICV 1.5" ELECTRIC VALVE	HUNTER SOLAR SYNC WEATHER SENSOR
HUNTER ICV 1" ELECTRIC VALVE	IRRIGATION BOOSTER PUMP STATION
LEEMCO MANUAL ISOLATION VALVE	B-BOX
HUNTER 1" QUICK COUPLER	

CENTRAL
Lawn Sprinklers Inc.
239 King Street • Elk Grove Village, IL 60007 • Phone: (847) 364-6900 • Fax: (847) 364-9774

LAGRANGE ROAD IMPROVEMENTS
ORLAND PARK, ILLINOIS
Segment 2 - 159th St to 143rd St
IRRIGATION AS-BUILT

PROJECT NO.	15780
DESIGNED BY:	KM
DRAWN BY:	KM
CHECKED BY:	JC
DATE:	OCT 31, 2017
SCALE:	1" = 30'
SHEET	2

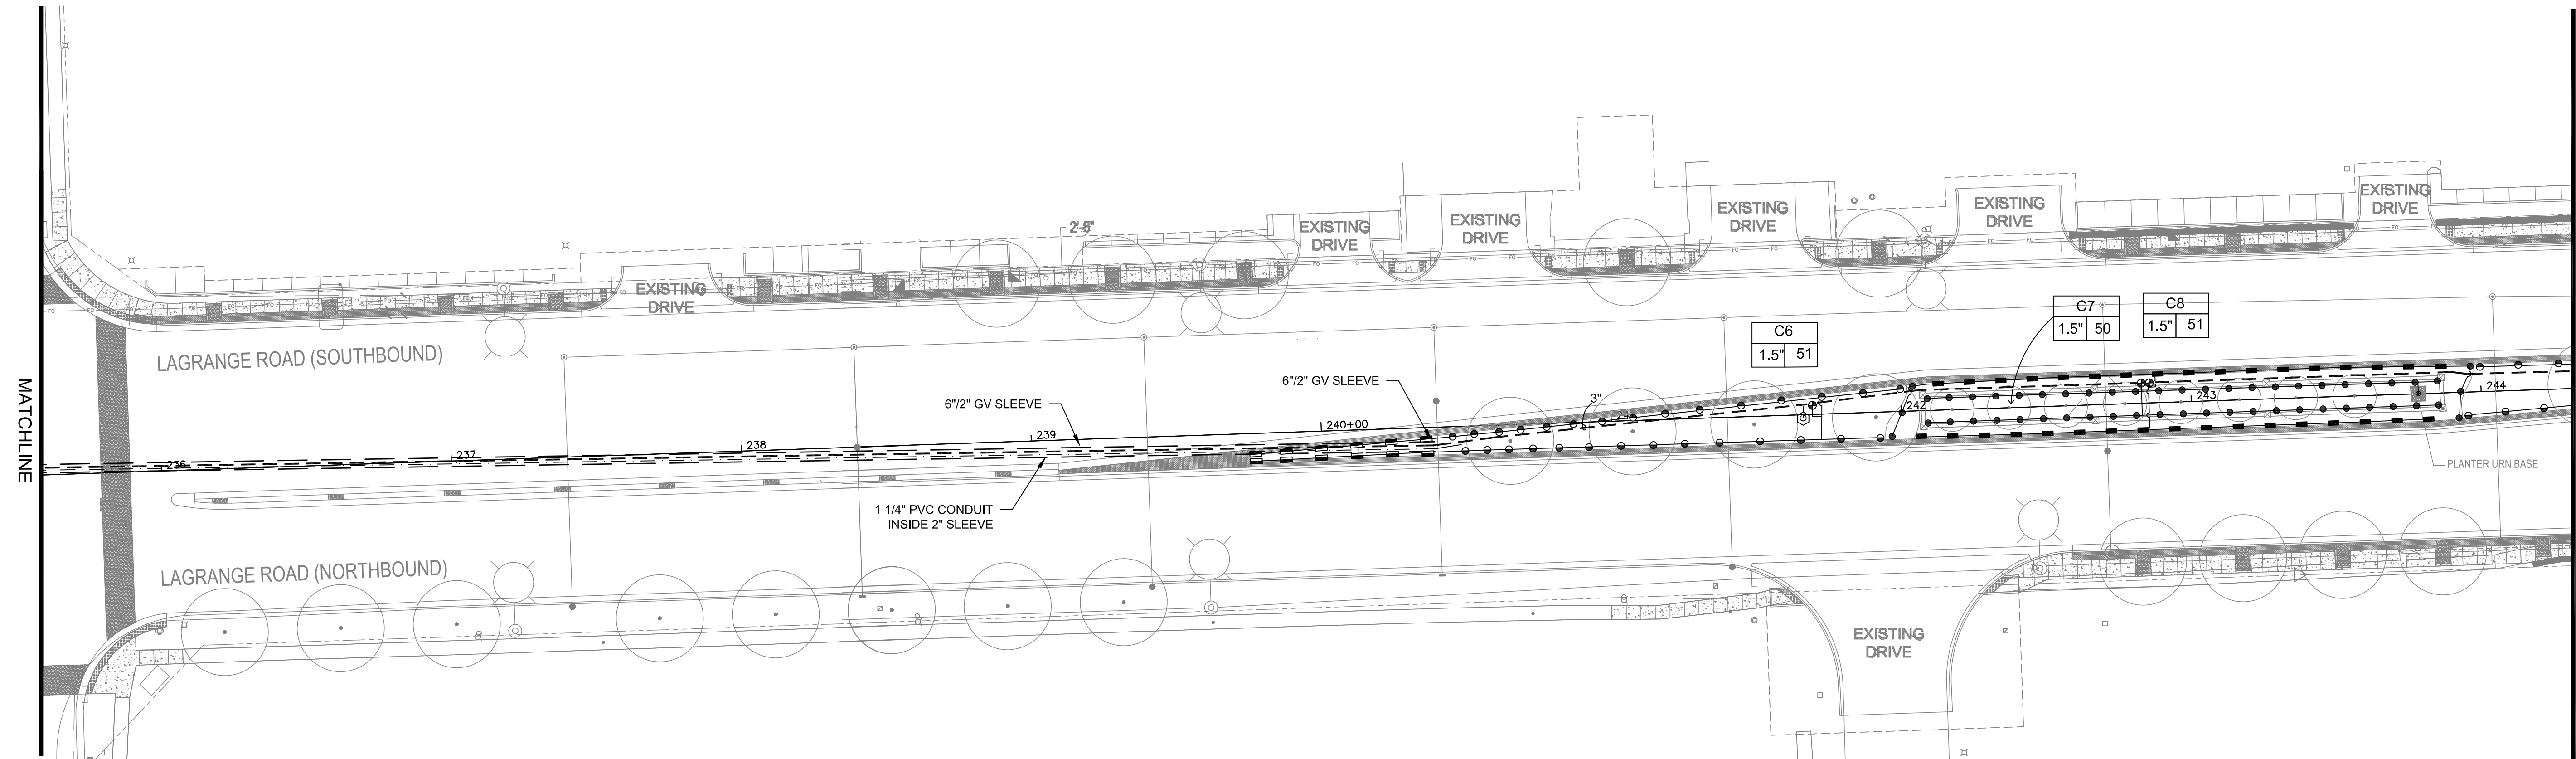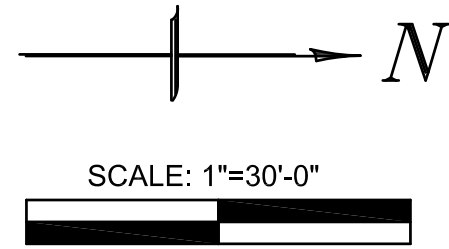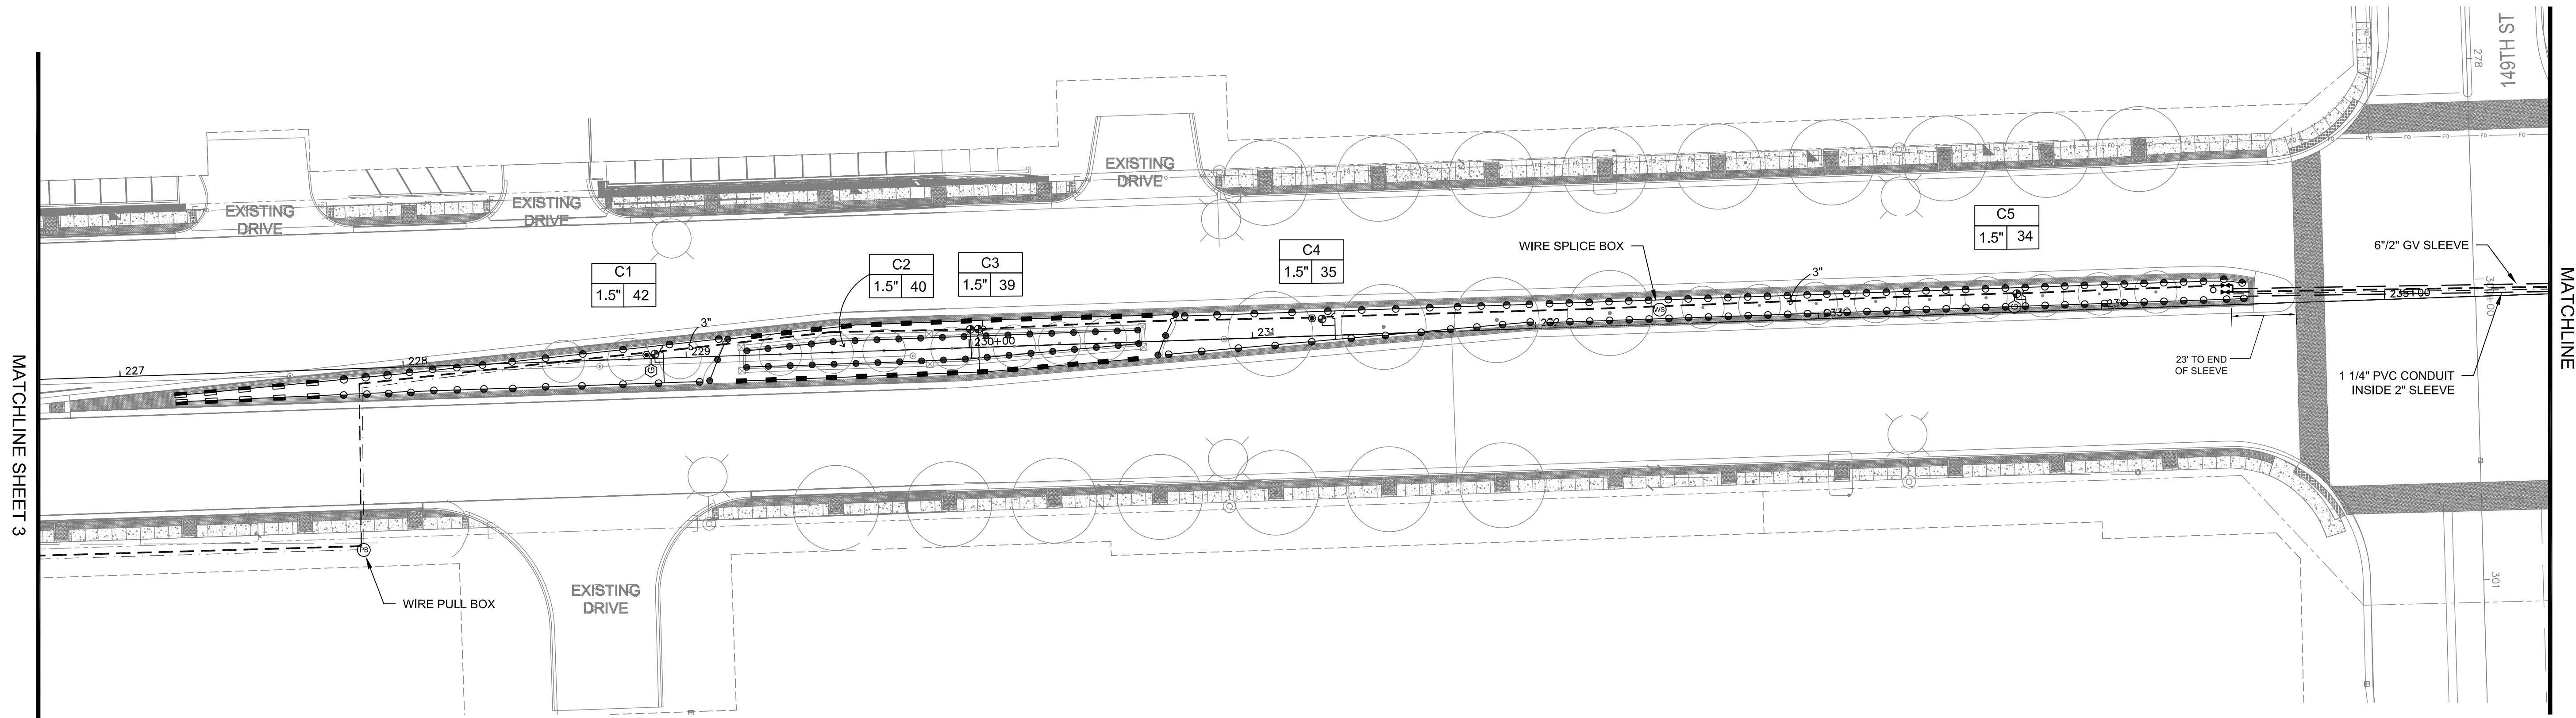


LEGEND	
● HUNTER 4" SPRAY HEAD, 8' - 17' RADIUS	— POLY HD LATERAL PIPE
● HUNTER 12" SPRAY HEAD, 8' - 17' RADIUS	— 3" PVC CL200 SDR21 MAINLINE PIPE
▬ HUNTER 4" SPRAY HEAD 15' STRIP	— IRRIGATION SLEEVE
▬ HUNTER 12" SPRAY HEAD 15' STRIP	□ HUNTER ACC-D DECODER CONTROLLER
⊕ HUNTER ICV 1.5" ELECTRIC VALVE	⬡ HUNTER SOLAR SYNC WEATHER SENSOR
▣ HUNTER ICV 1" ELECTRIC VALVE	□ IRRIGATION BOOSTER PUMP STATION
⋈ LEEMCO MANUAL ISOLATION VALVE	⊗ B-BOX
⊙ HUNTER 1" QUICK COUPLER	

CENTRAL
Lawn Sprinklers Inc.

239 King Street • Elk Grove Village, IL 60007 • Phone: (847) 364-6900 • Fax: (847) 364-9774

LAGRANGE ROAD IMPROVEMENTS
ORLAND PARK, ILLINOIS
Segment 2 - 159th St to 143rd St
IRRIGATION AS-BUILT

PROJECT NO.	15780
DESIGNED BY:	KM
DRAWN BY:	KM
CHECKED BY:	JC
DATE:	OCT 31, 2017
SCALE:	1" = 30'
SHEET	4

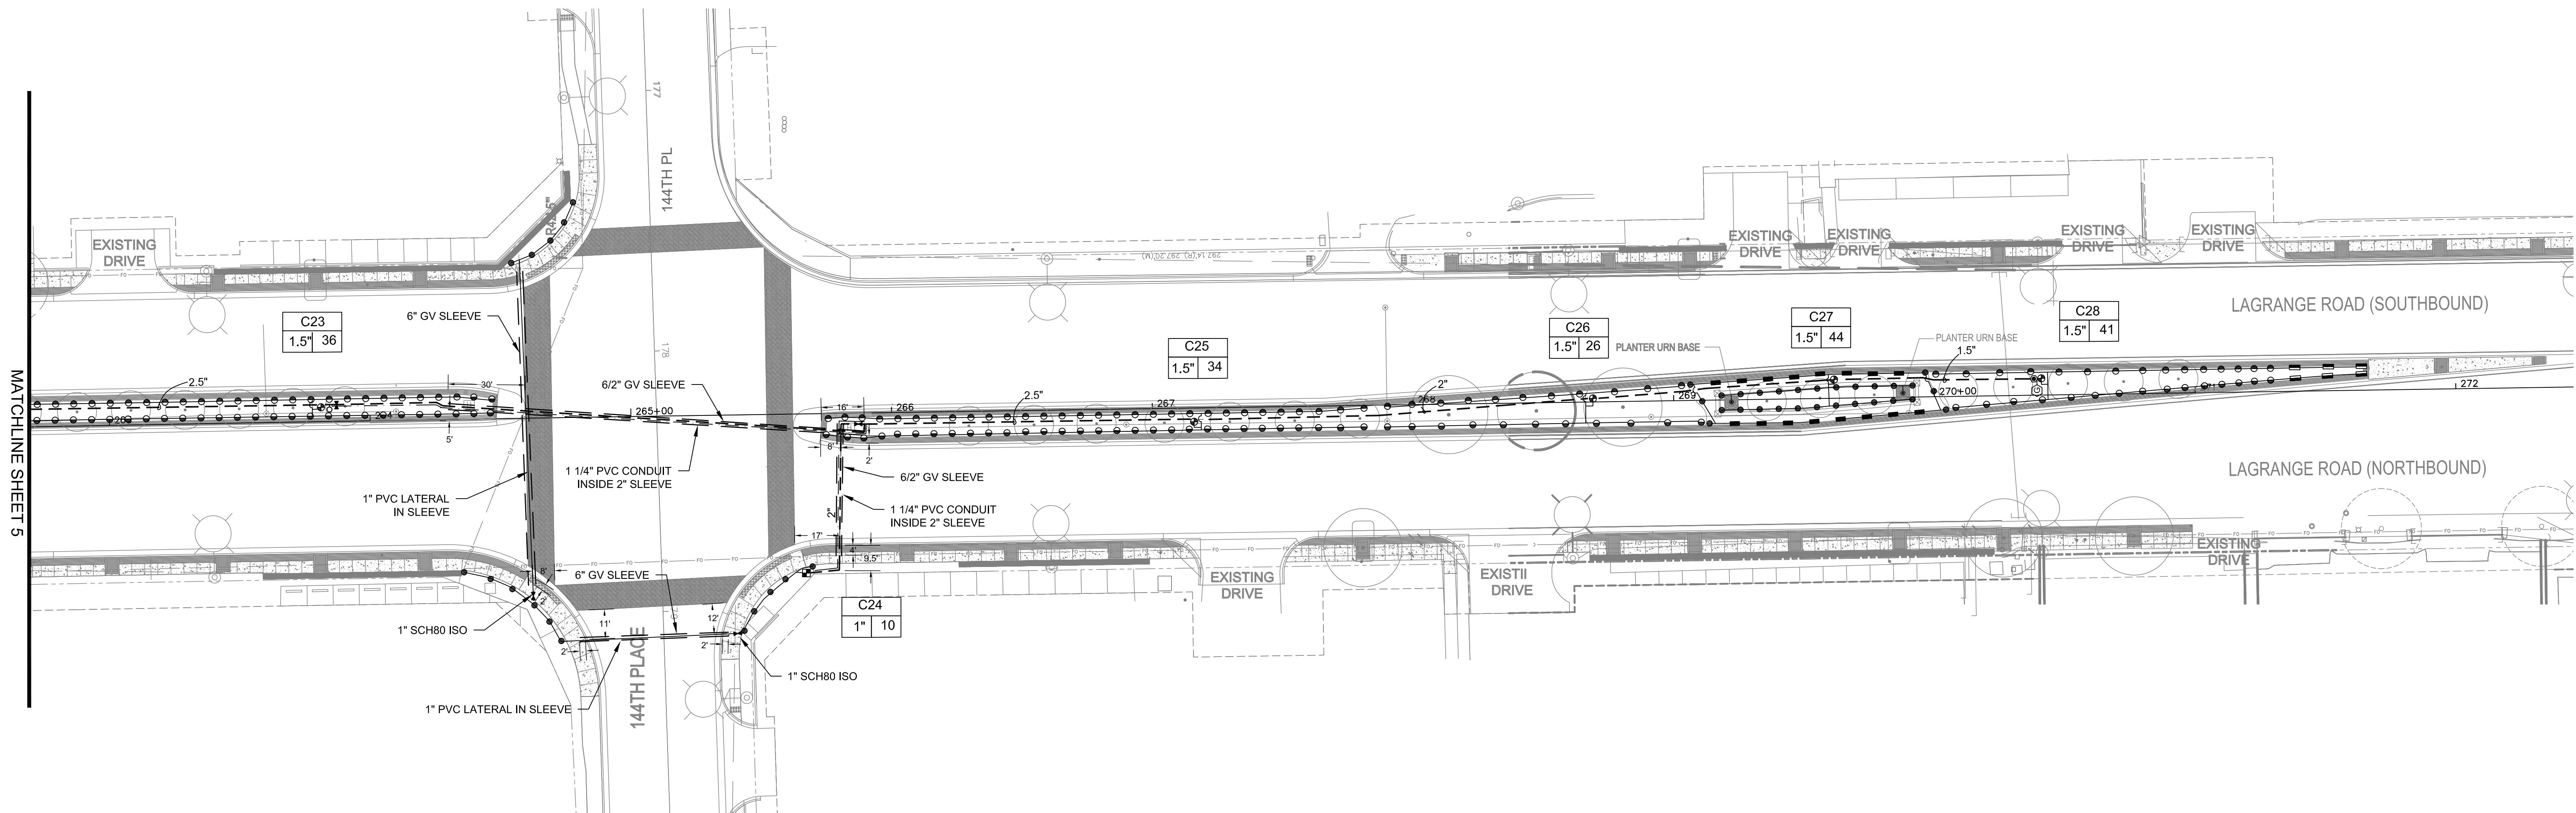

LEGEND	
	HUNTER 4" SPRAY HEAD, 8' - 17' RADIUS
	HUNTER 12" SPRAY HEAD, 8' - 17' RADIUS
	HUNTER 4" SPRAY HEAD 15' STRIP
	HUNTER 12" SPRAY HEAD 15' STRIP
	HUNTER ICV 1.5" ELECTRIC VALVE
	HUNTER ICV 1" ELECTRIC VALVE
	LEEMCO MANUAL ISOLATION VALVE
	HUNTER 1" QUICK COUPLER
	POLY HD LATERAL PIPE
	3" PVC CL200 SDR21 MAINLINE PIPE
	IRRIGATION SLEEVE
	HUNTER ACC-D DECODER CONTROLLER
	HUNTER SOLAR SYNC WEATHER SENSOR
	IRRIGATION BOOSTER PUMP STATION
	B-BOX

CENTRAL
Lawn Sprinklers Inc.

239 King Street • Elk Grove Village, IL 60007 • Phone: (847) 364-6900 • Fax: (847) 364-9774

LAGRANGE ROAD IMPROVEMENTS
ORLAND PARK, ILLINOIS
Segment 2 - 159th St to 143rd St
IRRIGATION AS-BUILT

PROJECT NO.	15780
DESIGNED BY:	KM
DRAWN BY:	KM
CHECKED BY:	JC
DATE:	OCT 31, 2017
SCALE:	1" = 30'
SHEET	6