
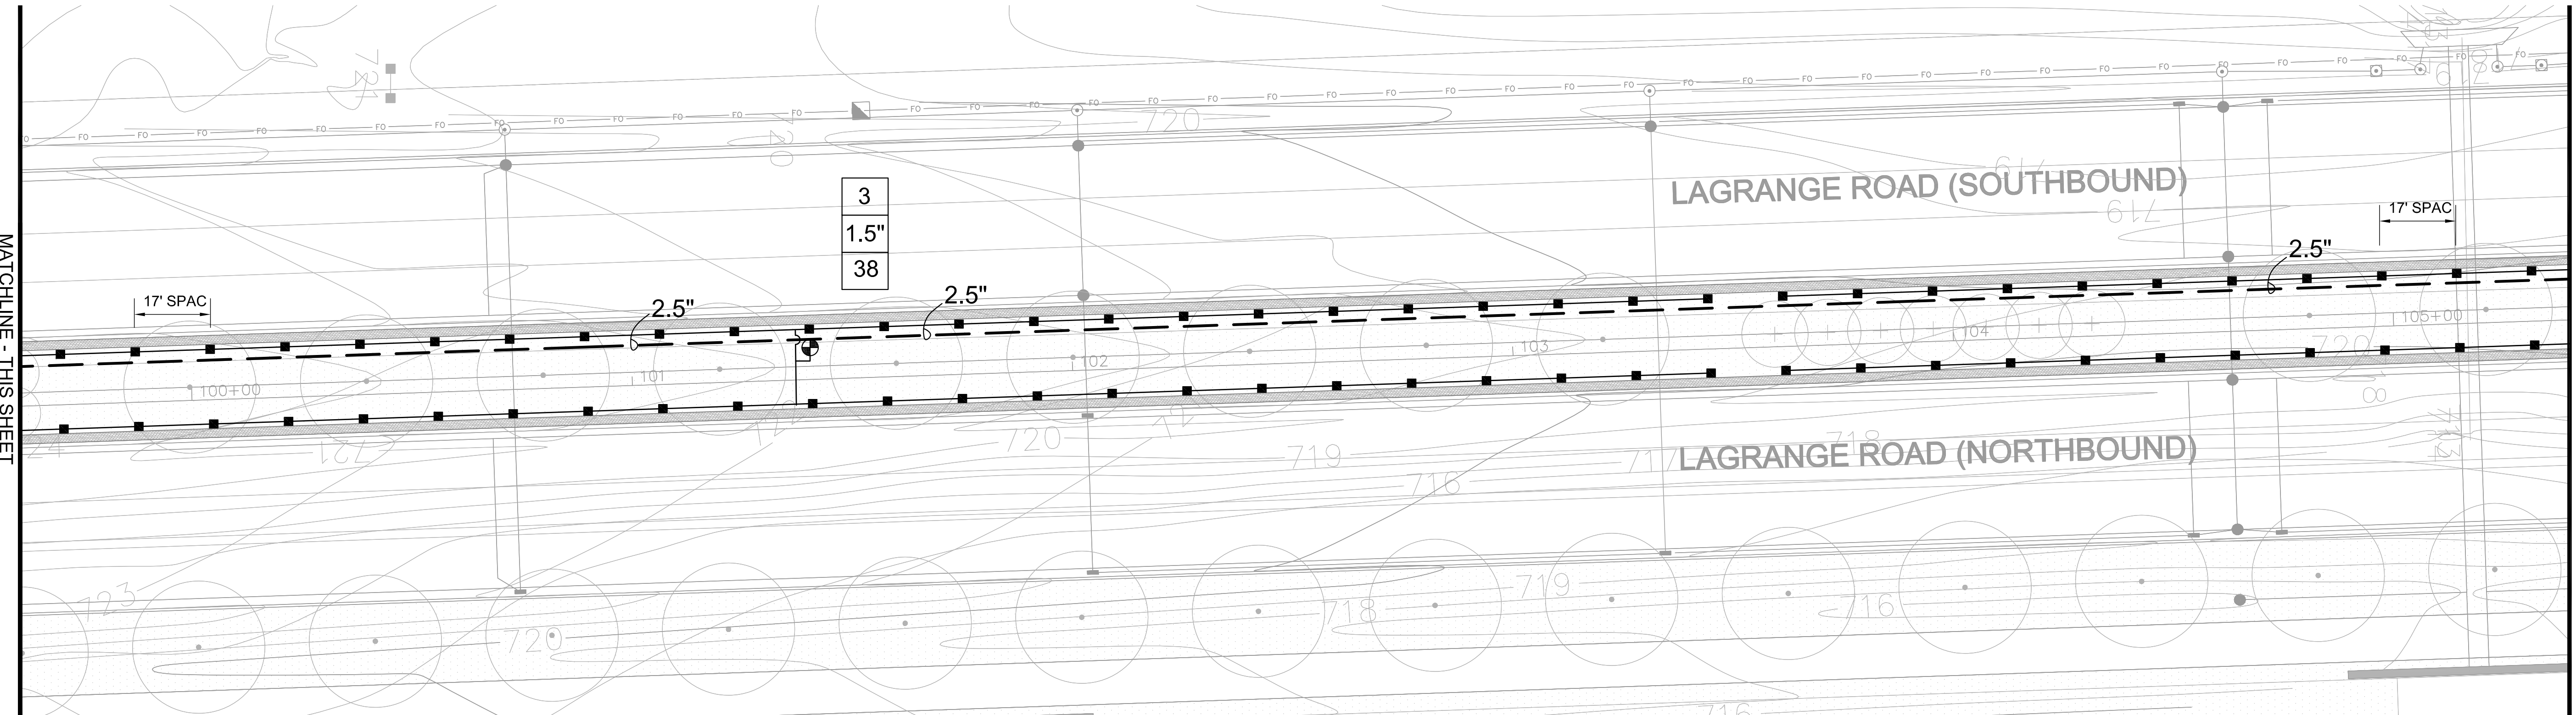
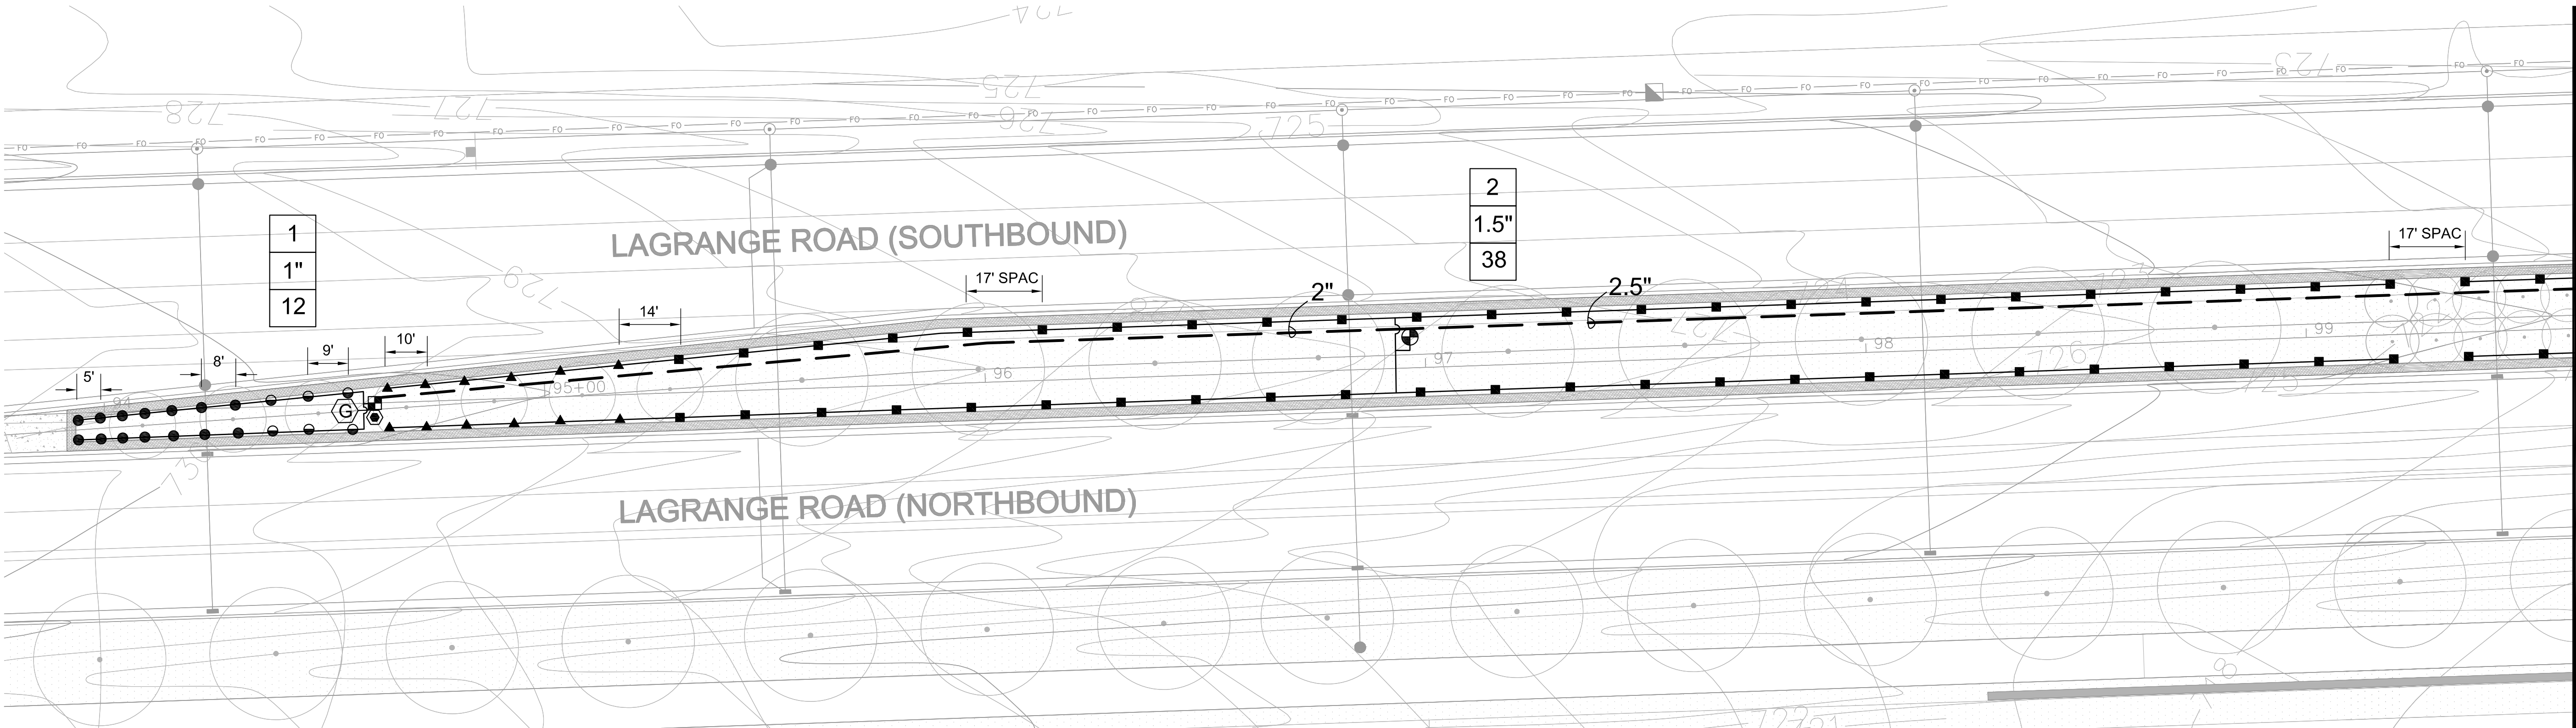


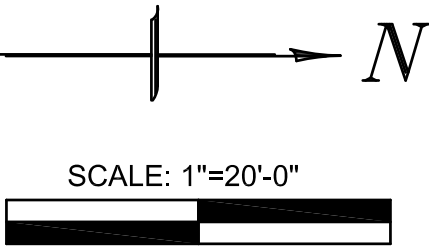

LEGEND		
HUNTER 8H SPRAY HEAD 4" PRS30	LEEMCO MANUAL ISOLATION VALVE	BOOSTER PUMP STATION
HUNTER 10H SPRAY HEAD 4" PRS30	HUNTER LRC 1" QUICK COUPLER	FEBCO 825YA BACKFLOW PREVENTER
HUNTER STRIP SPRAY HEAD 4" PRS 30	LATERAL PIPE	WATER METER (PROVIDED BY CITY)
HUNTER MP 2000 ROTATOR 4" PRS40	3" PVC CL200 SDR21 MAINLINE PIPE	MASTER VALVE
HUNTER MP 1000 ROTATOR 4" PRS40	HUNTER ACC-99D DECODER CONTROLLER	BLOW OUT TEE
HUNTER ICV 1.5" ELECTRIC VALVE	HUNTER SOLAR SYNC WEATHER SENSOR	GROUND ROD
HUNTER ICV 1" ELECTRIC VALVE	FLOW SENSOR	
HUNTER 1" DRIP ZONE VALVE		

CENTRAL

Lawn Sprinklers Inc.

239 King Street • Elk Grove Village, IL 60007 • Phone: (847) 364-6900 • Fax: (847) 364-9774




LAGRANGE ROAD IMPROVEMENTS

ORLAND PARK, ILLINOIS

SEGMENT 1 - 171ST TO 159TH

IRRIGATION AS-BUILT

PROJECT NO.	15780
DESIGNED BY:	KM
DRAWN BY:	KM
CHECKED BY:	JC
DATE:	SEPTEMBER 16, 2016
SCALE:	1" = 20'
SHEET	1

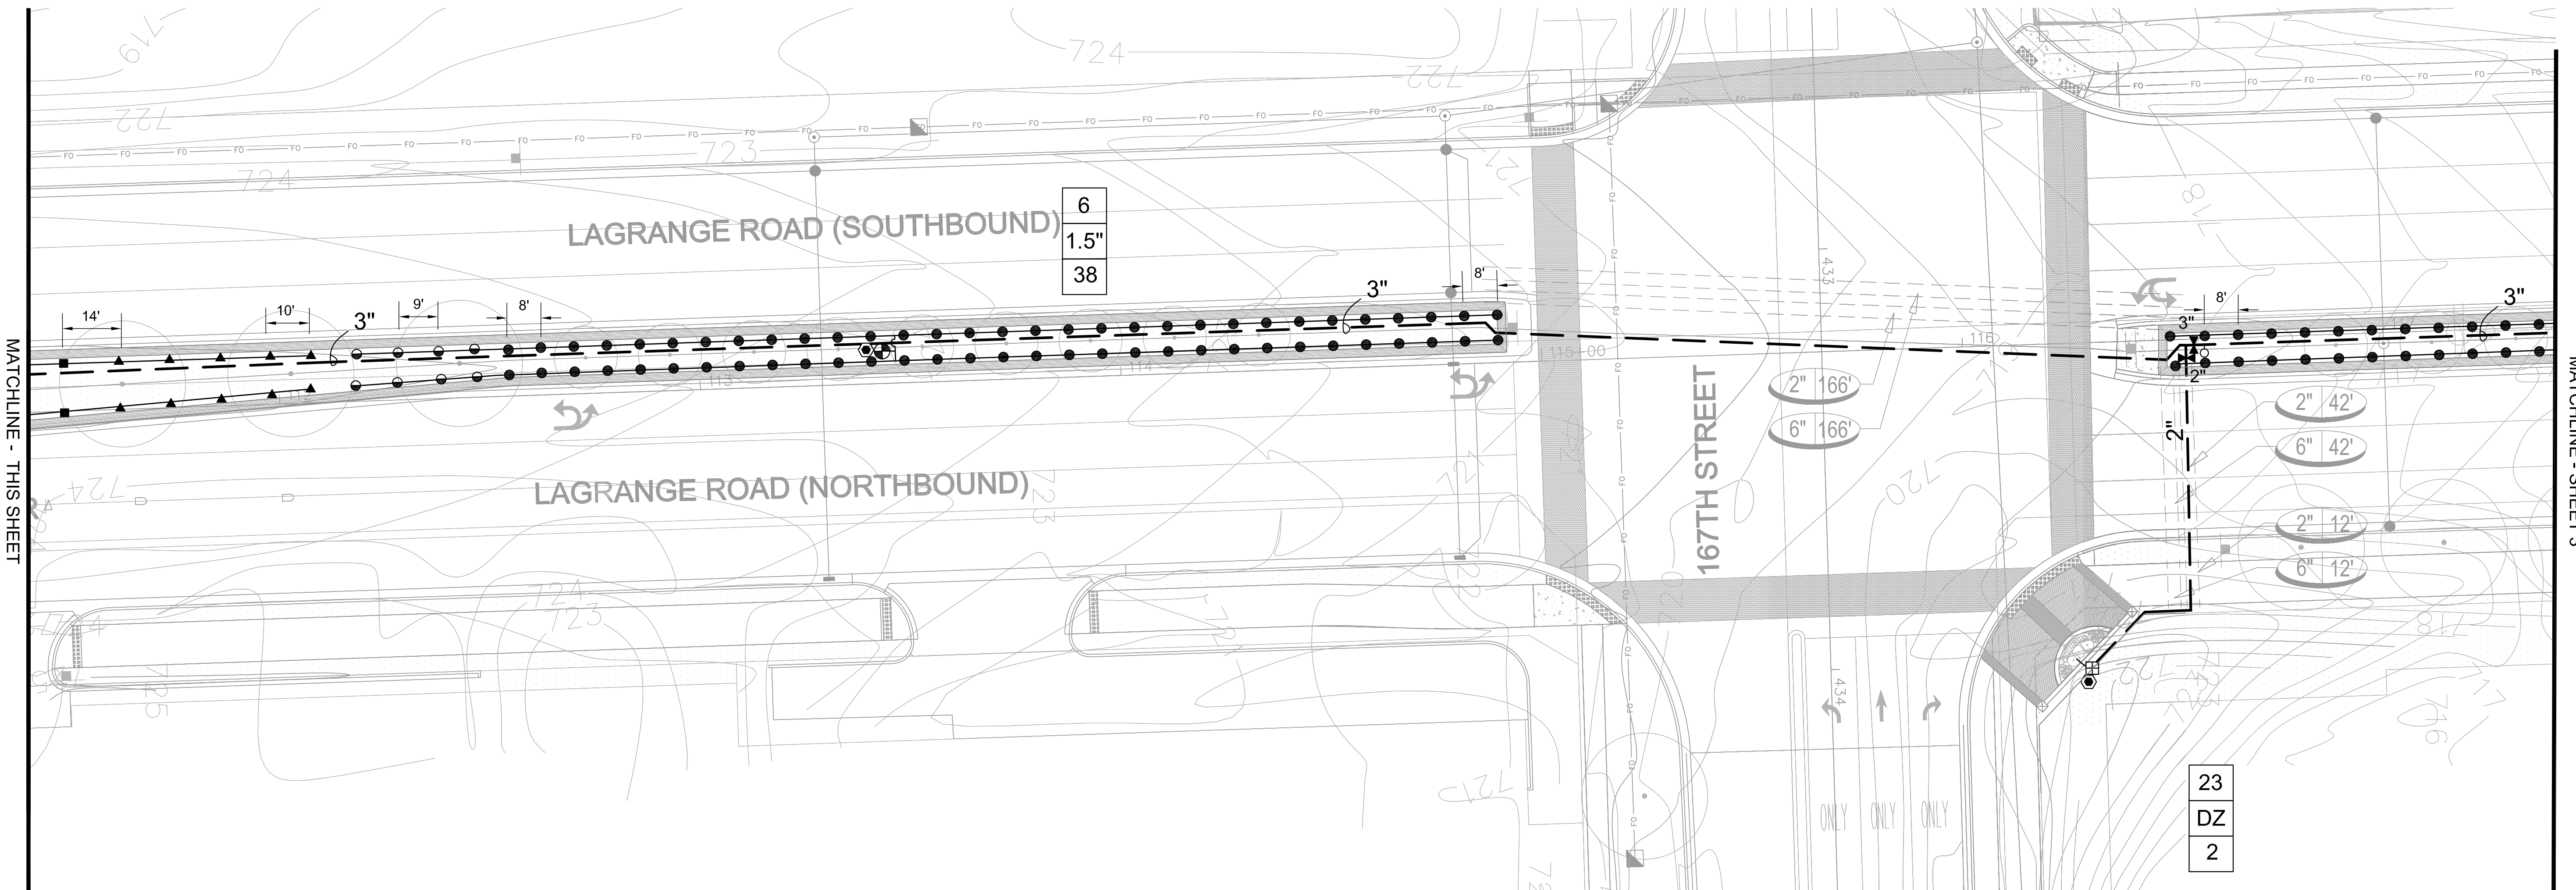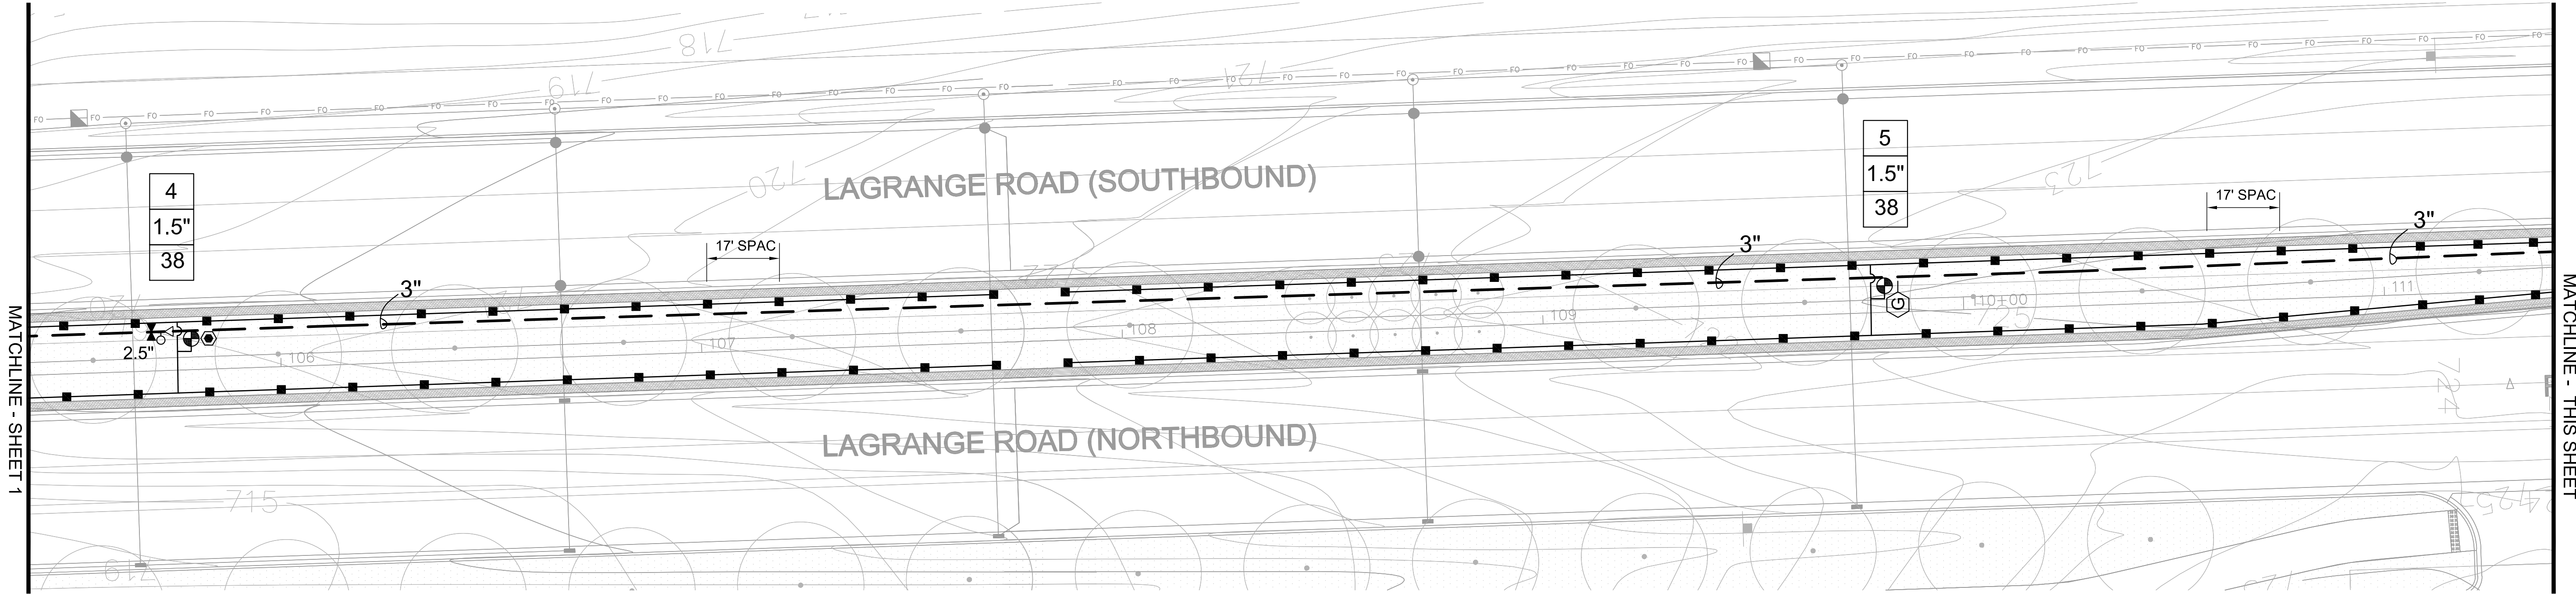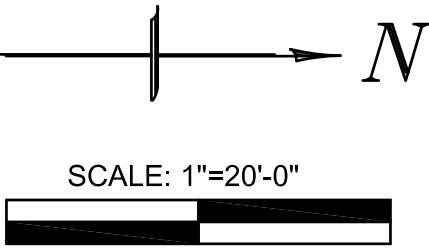

LEGEND			
●	HUNTER 8H SPRAY HEAD 4" PRS30	⌘	LEEMCO MANUAL ISOLATION VALVE
●	HUNTER 10H SPRAY HEAD 4" PRS30	⊙	HUNTER LRC 1" QUICK COUPLER
▬	HUNTER STRIP SPRAY HEAD 4" PRS 30	—	LATERAL PIPE
■	HUNTER MP 2000 ROTATOR 4" PRS40	— 3"	PVC CL200 SDR21 MAINLINE PIPE
▲	HUNTER MP 1000 ROTATOR 4" PRS40	Ⓢ	HUNTER ACC-99D DECODER CONTROLLER
⊕	HUNTER ICV 1.5" ELECTRIC VALVE	⊕	HUNTER SOLAR SYNC WEATHER SENSOR
⊞	HUNTER ICV 1" ELECTRIC VALVE	Ⓢ	FLOW SENSOR
⊞	HUNTER 1" DRIP ZONE VALVE		
		Ⓢ	BOOSTER PUMP STATION
		Ⓢ	FEBCO 825YA BACKFLOW PREVENTER
		Ⓢ	WATER METER (PROVIDED BY CITY)
		Ⓢ	MASTER VALVE
		Ⓢ	BLOW OUT TEE
		Ⓢ	GROUND ROD

CENTRAL

Lawn Sprinklers Inc.

239 King Street • Elk Grove Village, IL 60007 • Phone: (847) 364-6900 • Fax: (847) 364-9774




LAGRANGE ROAD IMPROVEMENTS

ORLAND PARK, ILLINOIS

SEGMENT 1 - 171ST TO 159TH

IRRIGATION AS-BUILT

PROJECT NO.	15780
DESIGNED BY:	KM
DRAWN BY:	KM
CHECKED BY:	JC
DATE:	SEPTEMBER 16, 2016
SCALE:	1" = 20'
SHEET	2

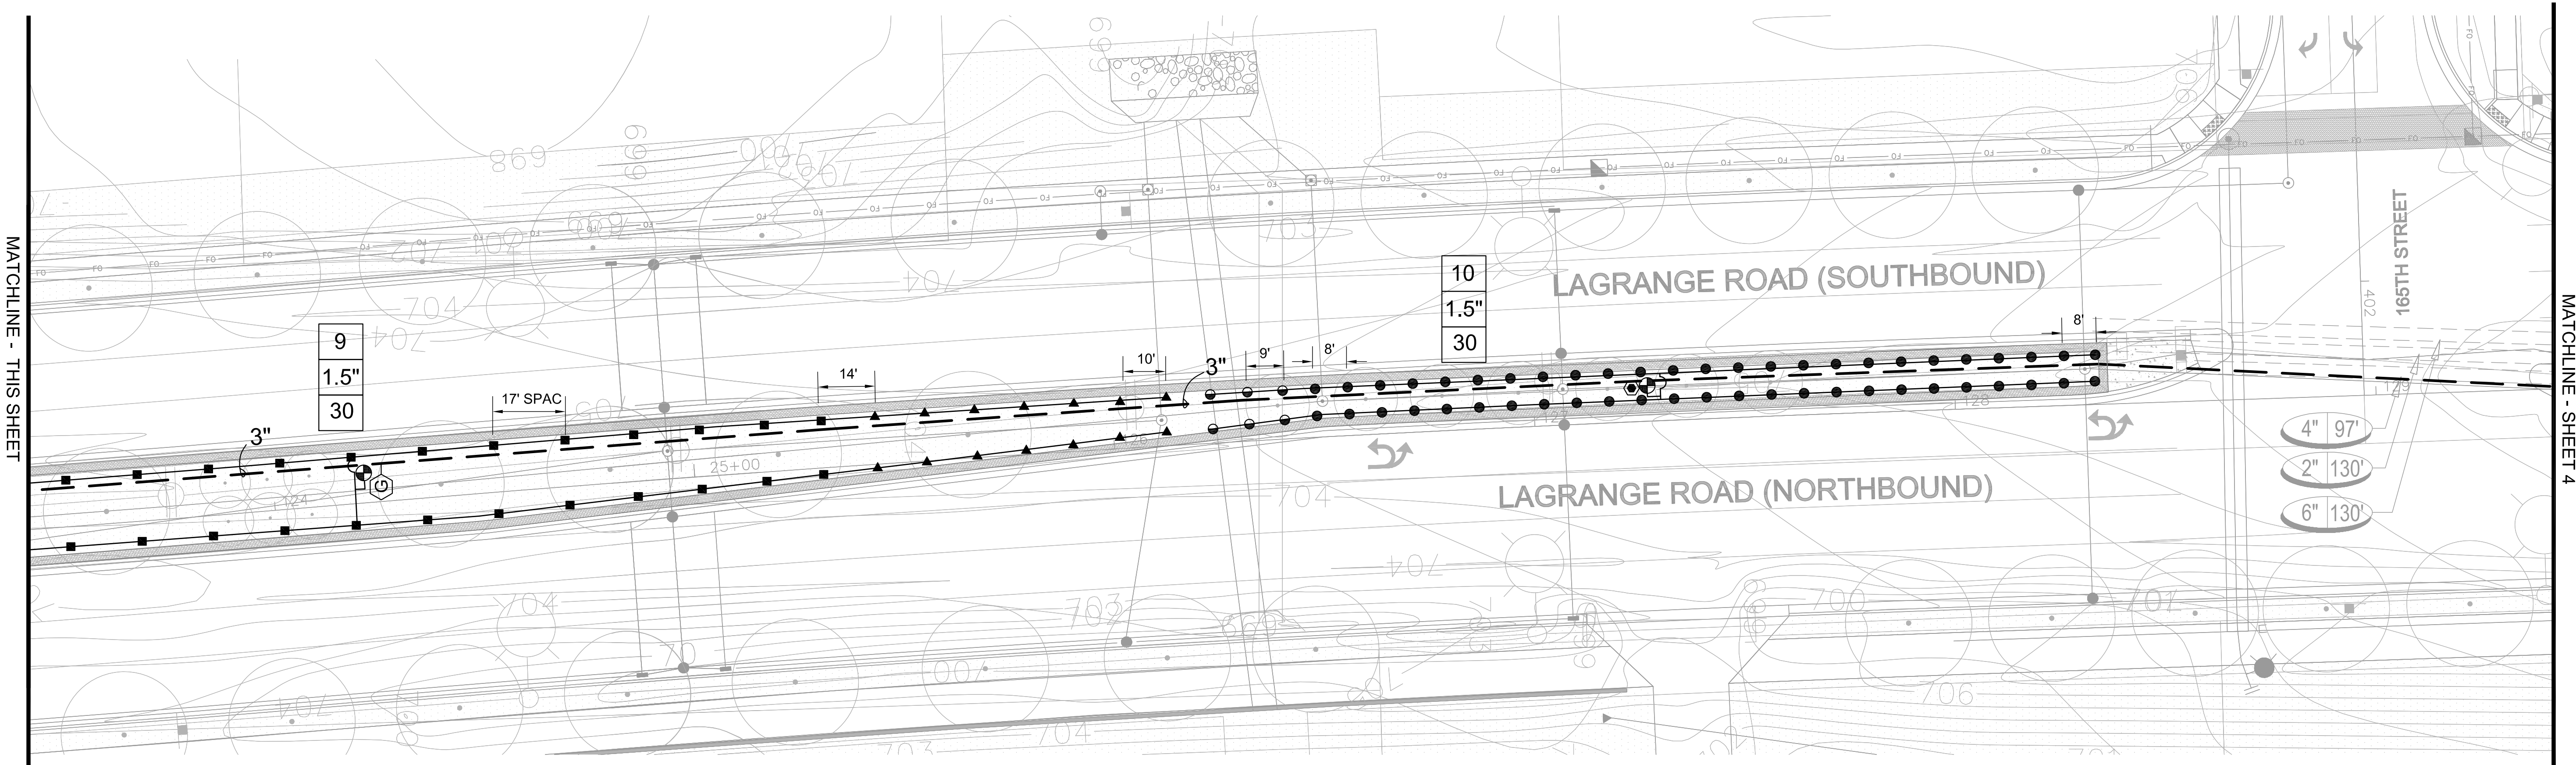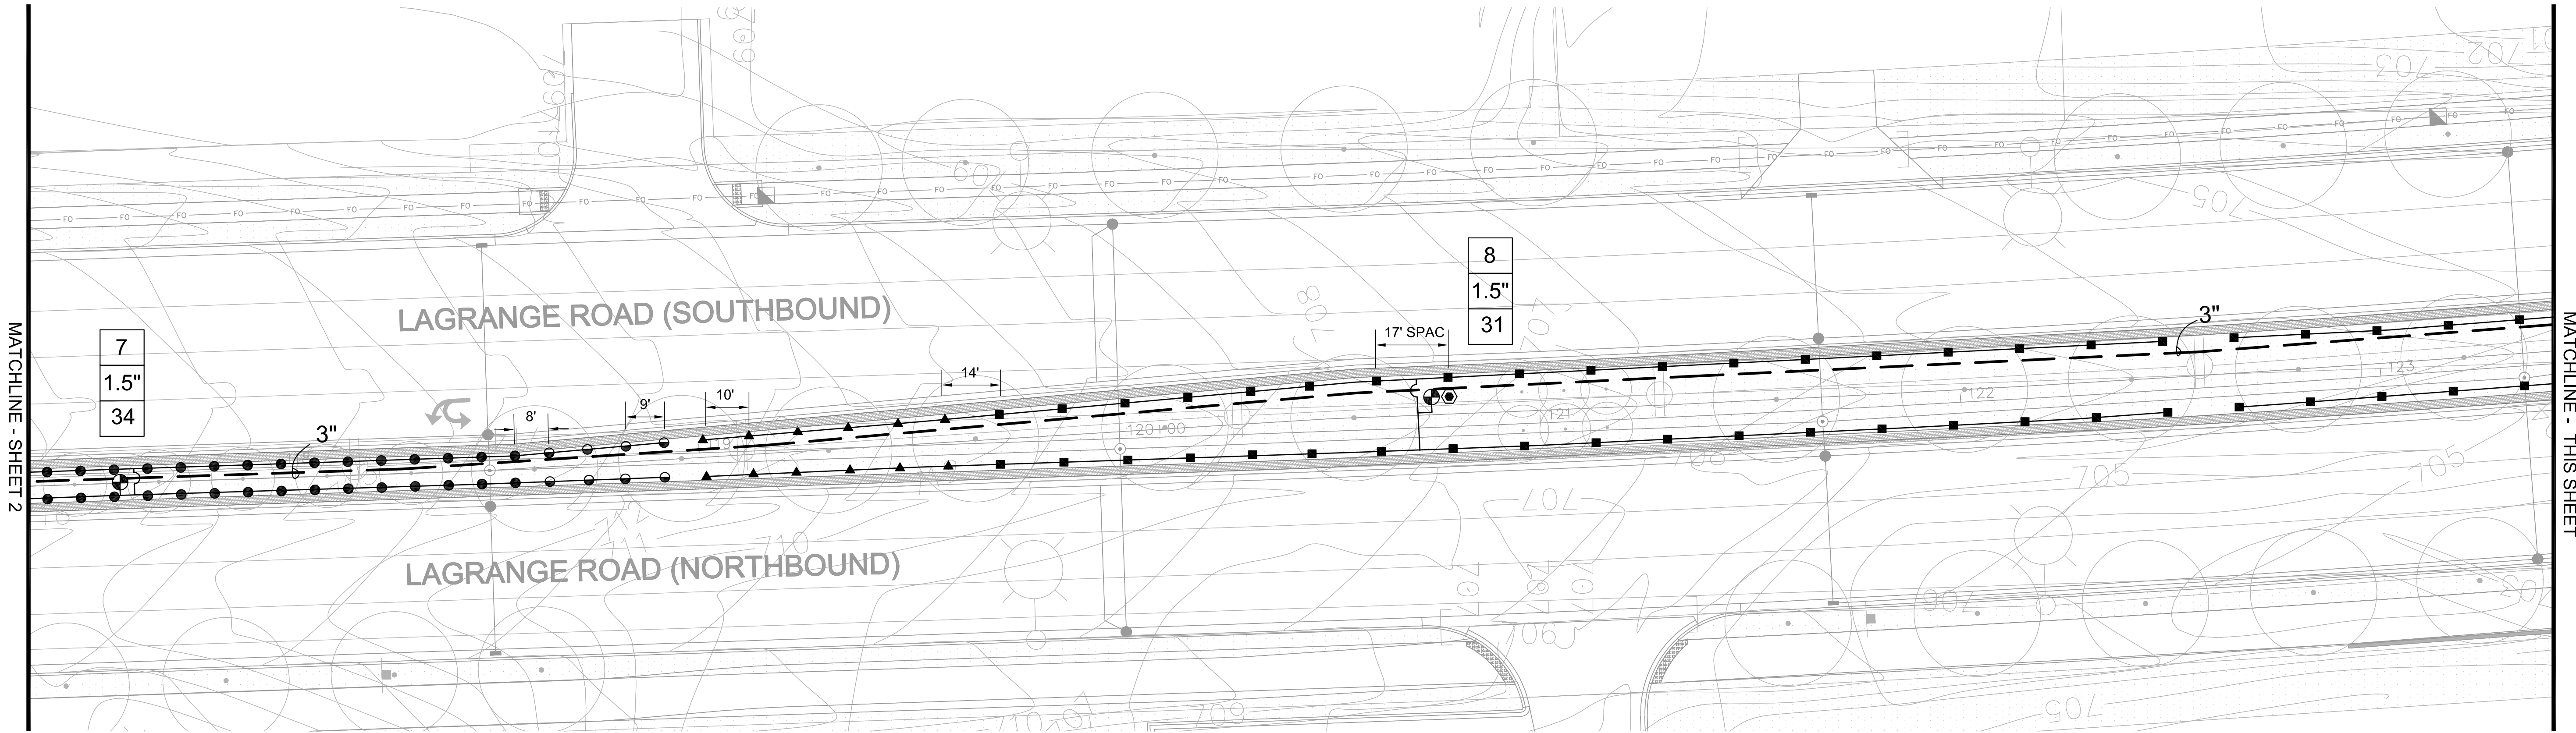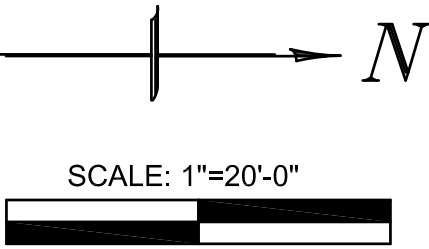




LEGEND			
●	HUNTER 8H SPRAY HEAD 4" PRS30	⌵	LEEMCO MANUAL ISOLATION VALVE
●	HUNTER 10H SPRAY HEAD 4" PRS30	⊙	HUNTER LRC 1" QUICK COUPLER
▬	HUNTER STRIP SPRAY HEAD 4" PRS30	—	LATERAL PIPE
■	HUNTER MP 2000 ROTATOR 4" PRS40	— 3"	PVC CL200 SDR21 MAINLINE PIPE
▲	HUNTER MP 1000 ROTATOR 4" PRS40	⊠	HUNTER ACC-99D DECODER CONTROLLER
⊕	HUNTER ICV 1.5" ELECTRIC VALVE	⬢	HUNTER SOLAR SYNC WEATHER SENSOR
⊞	HUNTER ICV 1" ELECTRIC VALVE	⊞	FLOW SENSOR
⊞	HUNTER 1" DRIP ZONE VALVE		
		Ⓚ	BOOSTER PUMP STATION
		Ⓚ	FEBCO 825YA BACKFLOW PREVENTER
		Ⓚ	WATER METER (PROVIDED BY CITY)
		Ⓚ	MASTER VALVE
		Ⓚ	BLOW OUT TEE
		Ⓚ	GROUND ROD

CENTRAL

Lawn Sprinklers Inc.

239 King Street • Elk Grove Village, IL 60007 • Phone: (847) 364-6900 • Fax: (847) 364-9774

LAGRANGE ROAD IMPROVEMENTS ORLAND PARK, ILLINOIS SEGMENT 1 - 171ST TO 159TH IRRIGATION AS-BUILT		PROJECT NO.	15780
		DESIGNED BY:	KM
		DRAWN BY:	KM
		CHECKED BY:	JC
		DATE:	SEPTEMBER 16, 2016
		SCALE:	1" = 20'
		SHEET	3

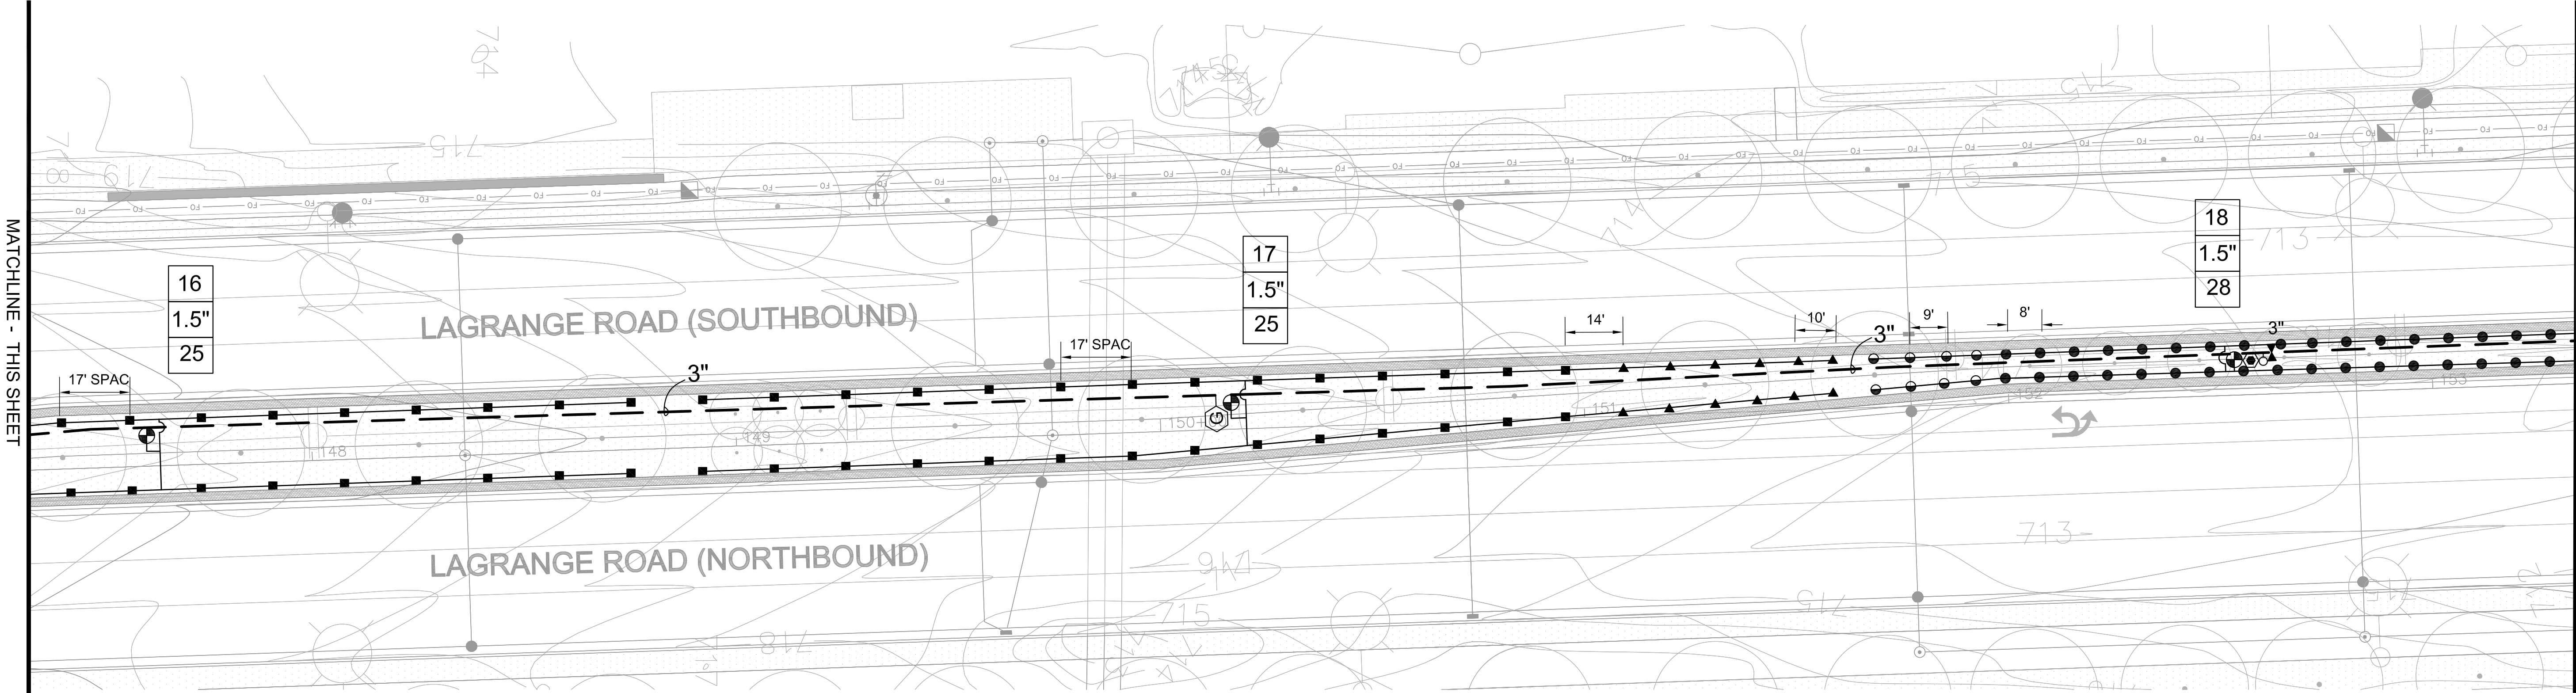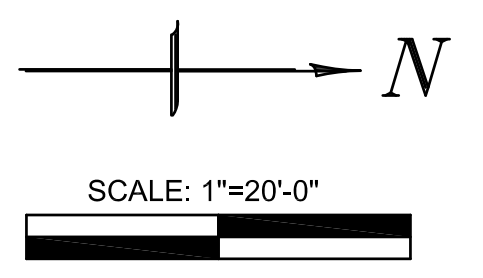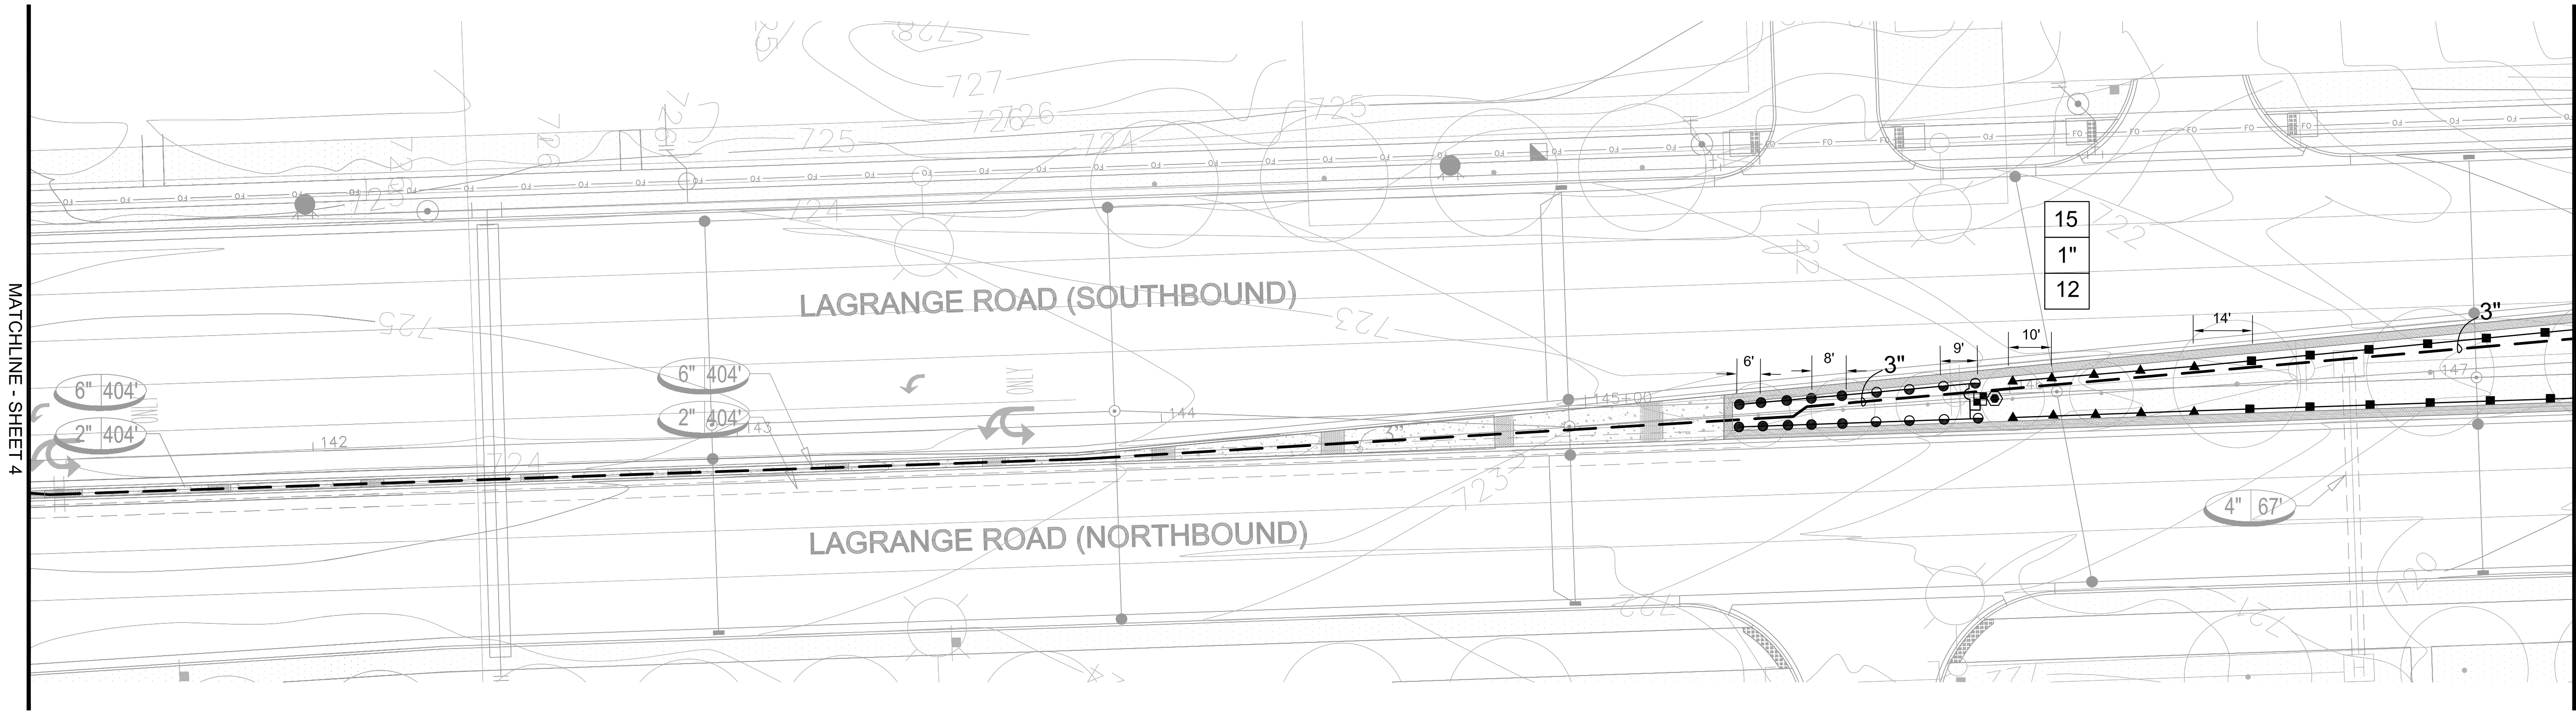

LEGEND			
●	HUNTER 8H SPRAY HEAD 4" PRS30	⌵	LEEMCO MANUAL ISOLATION VALVE
●	HUNTER 10H SPRAY HEAD 4" PRS30	⊙	HUNTER LRC 1" QUICK COUPLER
▬	HUNTER STRIP SPRAY HEAD 4" PRS30	—	LATERAL PIPE
■	HUNTER MP 2000 ROTATOR 4" PRS40	— 3"	PVC CL200 SDR21 MAINLINE PIPE
▲	HUNTER MP 1000 ROTATOR 4" PRS40	Ⓢ	HUNTER ACC-99D DECODER CONTROLLER
⊕	HUNTER ICV 1.5" ELECTRIC VALVE	⊕	HUNTER SOLAR SYNC WEATHER SENSOR
⊕	HUNTER ICV 1" ELECTRIC VALVE	⊕	FLOW SENSOR
⊕	HUNTER 1" DRIP ZONE VALVE		
		Ⓟ	BOOSTER PUMP STATION
		Ⓜ	FEBCO 825YA BACKFLOW PREVENTER
		Ⓜ	WATER METER (PROVIDED BY CITY)
		Ⓜ	MASTER VALVE
		Ⓜ	BLOW OUT TEE
		Ⓜ	GROUND ROD

CENTRAL

Lawn Sprinklers Inc.

239 King Street • Elk Grove Village, IL 60007 • Phone: (847) 364-6900 • Fax: (847) 364-9774




LAGRANGE ROAD IMPROVEMENTS

ORLAND PARK, ILLINOIS

SEGMENT 1 - 171ST TO 159TH

IRRIGATION AS-BUILT

PROJECT NO.	15780
DESIGNED BY:	KM
DRAWN BY:	KM
CHECKED BY:	JC
DATE:	SEPTEMBER 16, 2016
SCALE:	1" = 20'
SHEET	5

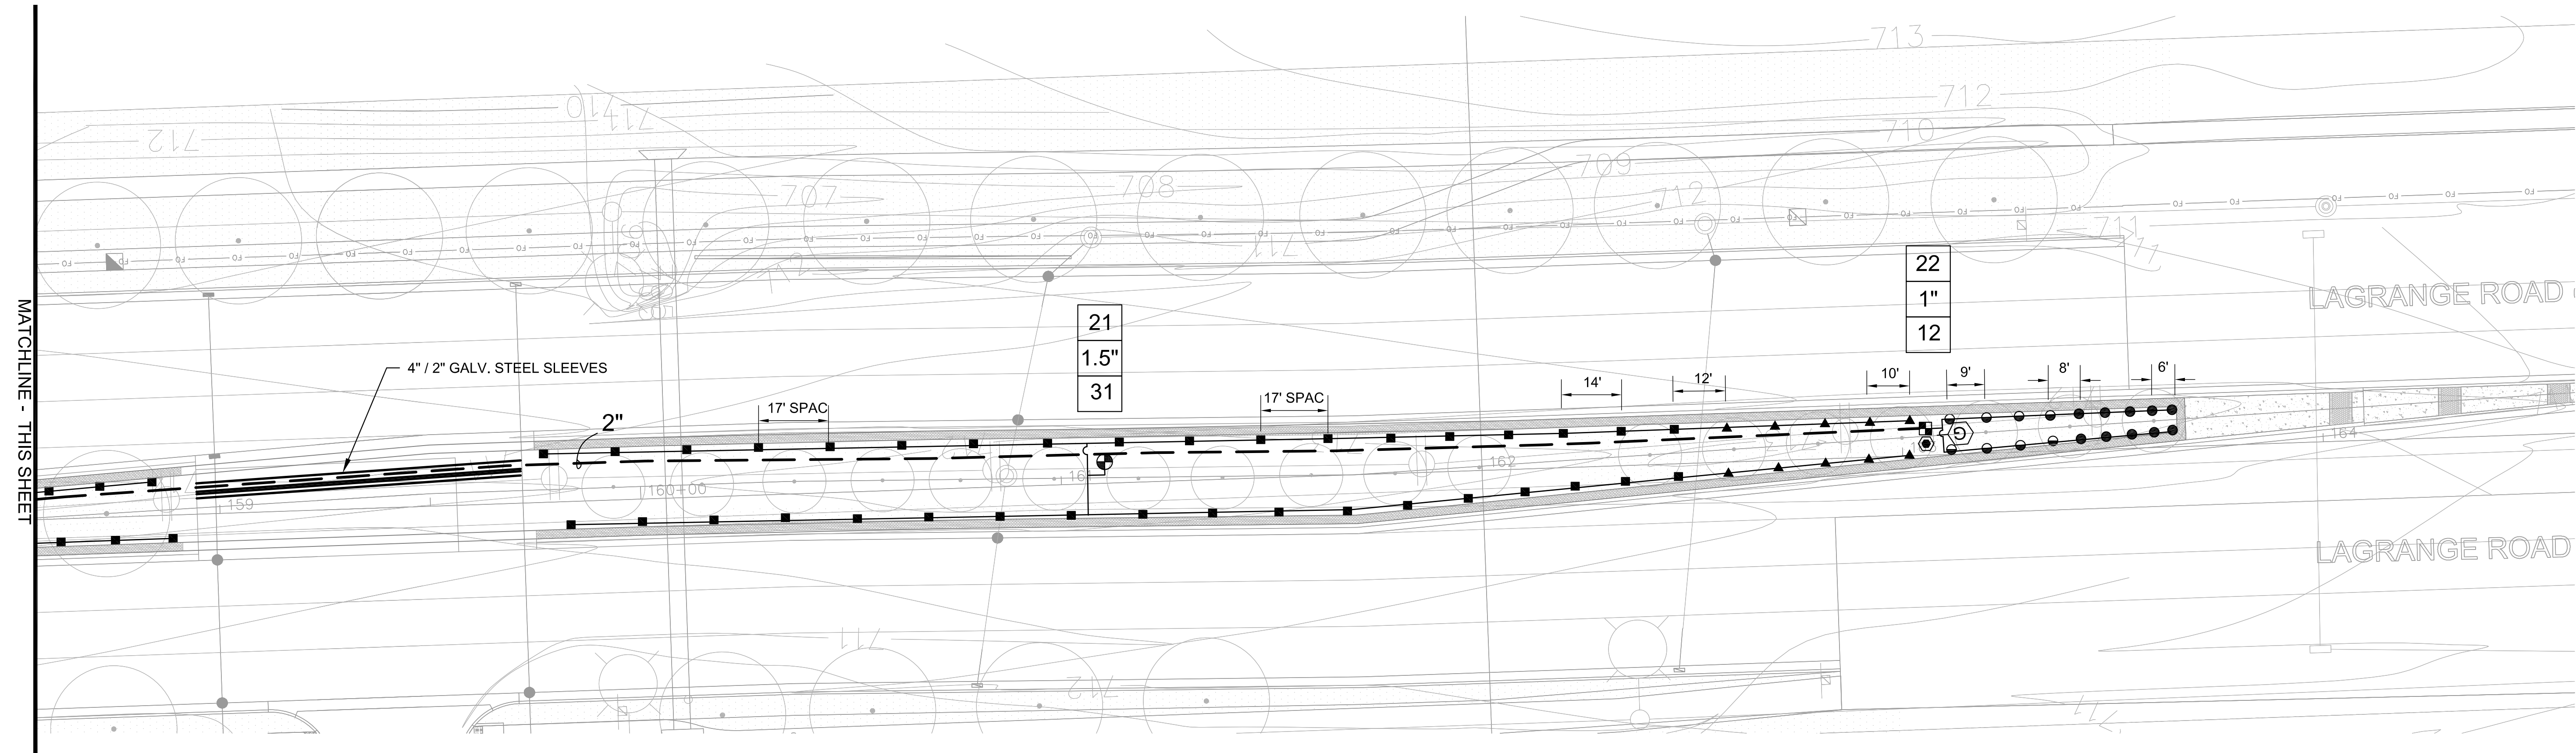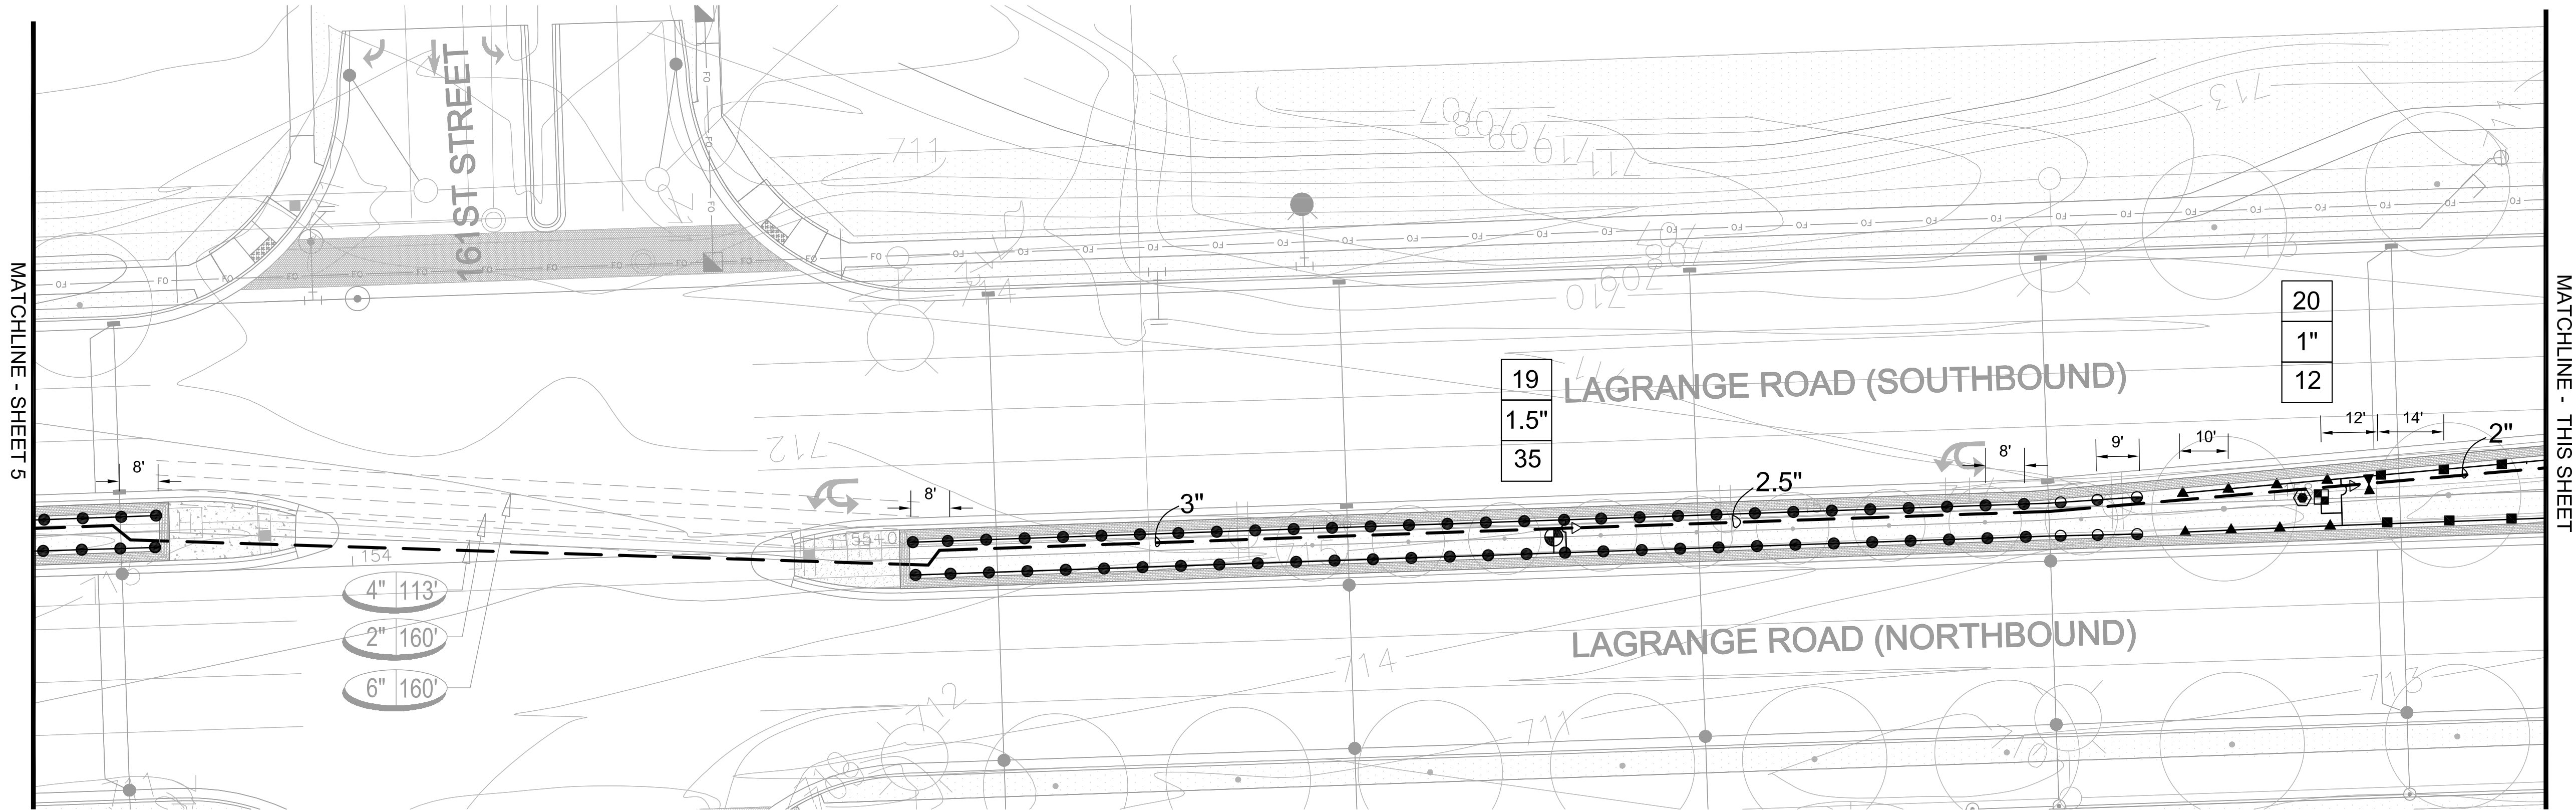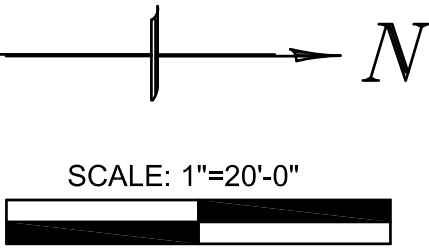

LEGEND			
●	HUNTER 8H SPRAY HEAD 4" PRS30	⌵	LEEMCO MANUAL ISOLATION VALVE
●	HUNTER 10H SPRAY HEAD 4" PRS30	⊙	HUNTER LRC 1" QUICK COUPLER
▬	HUNTER STRIP SPRAY HEAD 4" PRS30	—	LATERAL PIPE
■	HUNTER MP 2000 ROTATOR 4" PRS40	— 3"	PVC CL200 SDR21 MAINLINE PIPE
▲	HUNTER MP 1000 ROTATOR 4" PRS40	Ⓢ	HUNTER ACC-99D DECODER CONTROLLER
⊕	HUNTER ICV 1.5" ELECTRIC VALVE	⊕	HUNTER SOLAR SYNC WEATHER SENSOR
⊞	HUNTER ICV 1" ELECTRIC VALVE	Ⓢ	FLOW SENSOR
⊞	HUNTER 1" DRIP ZONE VALVE		
		Ⓢ	BOOSTER PUMP STATION
		Ⓢ	FEBCO 825YA BACKFLOW PREVENTER
		Ⓢ	WATER METER (PROVIDED BY CITY)
		Ⓢ	MASTER VALVE
		Ⓢ	BLOW OUT TEE
		Ⓢ	GROUND ROD

CENTRAL

Lawn Sprinklers Inc.

239 King Street • Elk Grove Village, IL 60007 • Phone: (847) 364-6900 • Fax: (847) 364-9774

LAGRANGE ROAD IMPROVEMENTS

ORLAND PARK, ILLINOIS

SEGMENT 1 - 171ST TO 159TH

IRRIGATION AS-BUILT

PROJECT NO.	15780
DESIGNED BY:	KM
DRAWN BY:	KM
CHECKED BY:	JC
DATE:	SEPTEMBER 16, 2016
SCALE:	1" = 20'
SHEET	6