


EQUIPMENT SCHEDULE

- 1 6' GRIDDLE
- 2 72" RANGE/WOK
- 3 48" RANGE/WOK
- 4 FRYER
- 5 RANGE STOCK POT
- 6 36" RANGE 6 BURNER
- 7 MEGA TOP SANDWICH (2 DOOR)
- 8 RANGE TANDOR
- 9 NOT USED
- 10 MEGA TOP SANDWICH (2 DOOR)
- 11 5' STAINLESS WORK TABLE
- 12 UNDERCOUNTER REFRIGERATOR
- 13 SANDWICH/PANINI GRILL
- 14 DISPLAY CASE/ICE CREAM
- 15 NOT USED
- 16 DOUGH DIVIDER ROUNDER
- 17 NOT USED
- 18 NOT USED
- 19 JUICER
- 20 BLENDER BAR
- 21 MOBILE WORK TOP PAN RACK
- 22 GREASE INTERCEPTOR
- 23 SUGAR CANE JUICER
- 24 NOT USED
- 25 HAND SINK
- 26 TRASH BIN
- 27 POS STATION
- 28 SHELVING
- 29 WALK-IN COOLER
- 30 3 - COMPARTMENT SINK
- 31 3' S.S. WORK TABLE
- 32 6' S.S. WORK TABLE
- 33 CUSTOM EXHAUST HOOD
- 34 REACH IN COOLER
- 35 48" CLEAN DISHTABLE
- 36 DISH MACHINE, DOOR TYPE

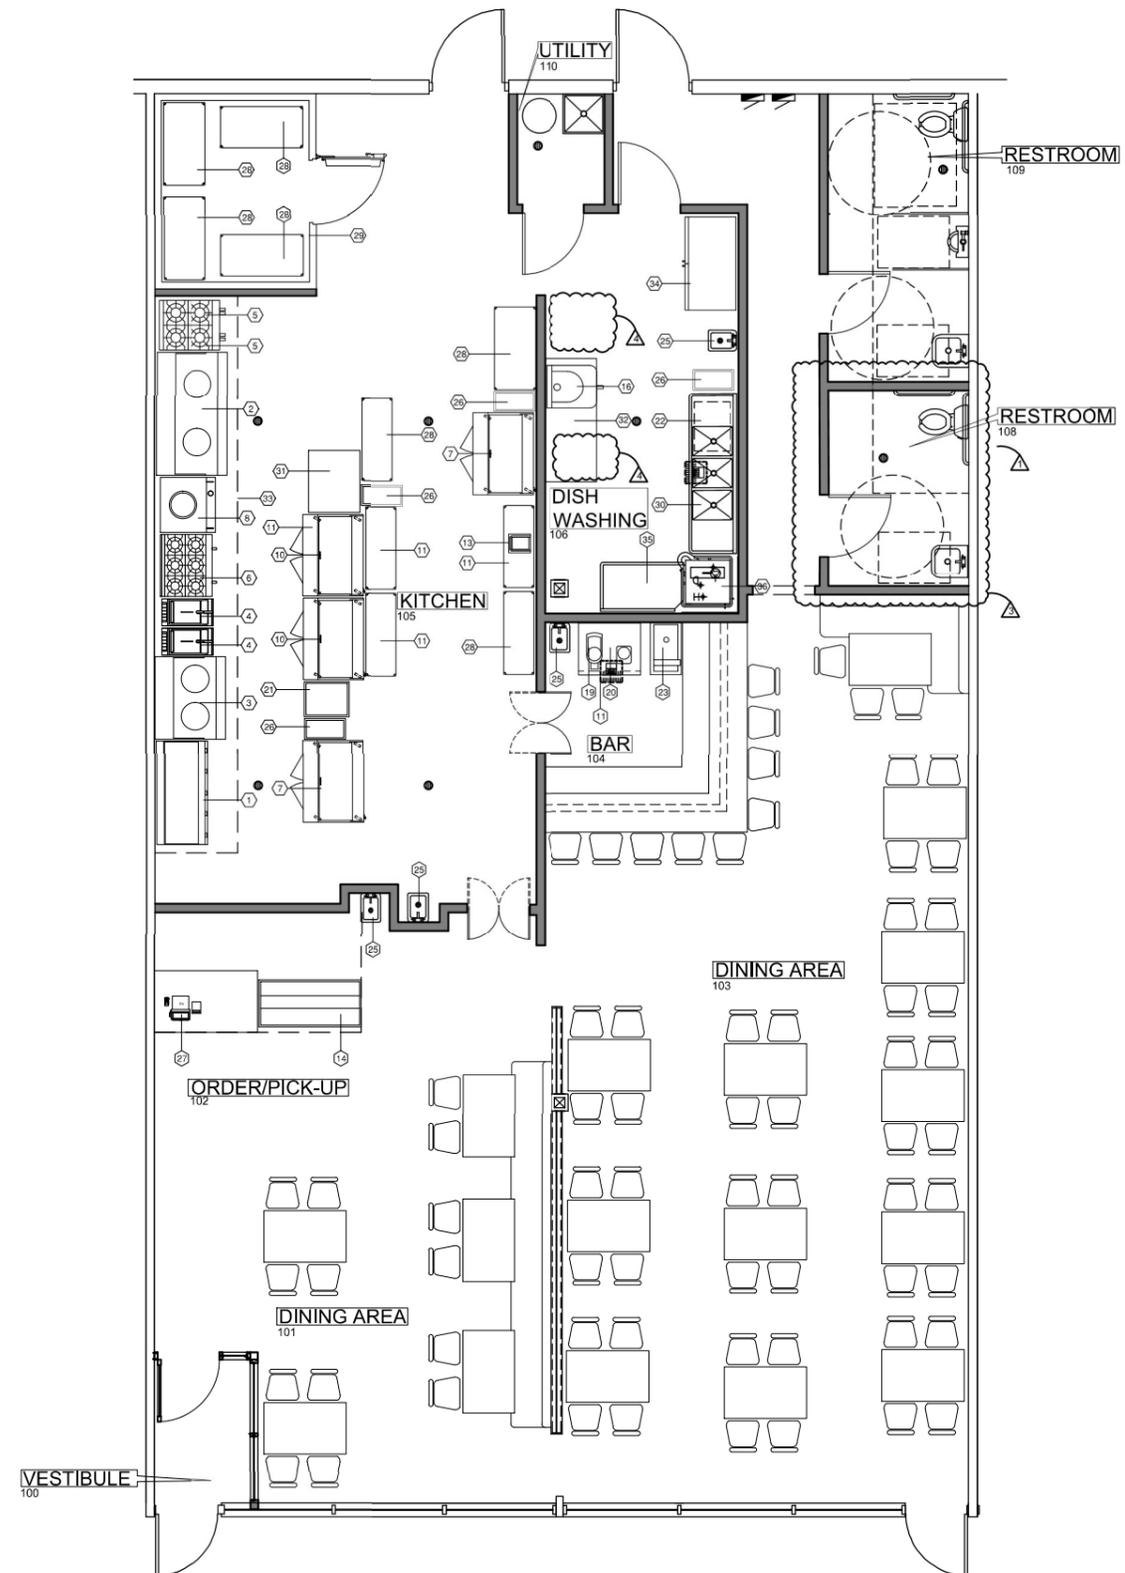

EQUIPMENT AND FURNISHING PLAN

1/4" = 1'-0"

<p>PROJECT: INTERIOR BUILD OUT</p> <div style="text-align: center;"> </div> <p>HONEST RESTAURANT 9178 W. 159th STREET PARK HILL PLAZA ORLAND PARK, IL</p>	<p>BVM DESIGN GROUP, LLC ARCHITECTS DESIGNERS SPACE PLANNERS 9710 WEST 93RD AVENUE ST. JOHN, IN 46373 630-968-6680 EMAIL: bvmdesigngroup@gmail.com WEBSITE: bvmdesigngroup.com MEMBER AMERICAN INSTITUTE OF ARCHITECTS MEMBER ASSOCIATION LICENSED ARCHITECTS © 2024 BVM DESIGN GROUP, LLC</p>
---	--

DATE: PERMIT REVIEW COMMENTS 12-19-2024
PERMIT REVIEW COMMENTS 12-2-2024
PERMIT REVIEW COMMENTS 9-3-2024
TENANT REVISIONS 7-23-2024
RELEASED FOR PERMIT & CONSTRUCTION 5-30-2024

SCALE:	SHEET: FE-1.0
--------	-------------------------