


**LEGEND**

● HUNTER 8H SPRAY HEAD 4" PRS30	◄ LEEMCO MANUAL ISOLATION VALVE	Ⓟ BOOSTER PUMP STATION
● HUNTER 10H SPRAY HEAD 4" PRS30	⊙ HUNTER LRC 1" QUICK COUPLER	Ⓡ FEBCO 825YA BACKFLOW PREVENTER
▬ HUNTER STRIP SPRAY HEAD 4" PRS30	— LATERAL PIPE	Ⓜ WATER METER (PROVIDED BY CITY)
■ HUNTER MP 2000 ROTATOR 4" PRS40	— 3" PVC CL200 SDR21 MAINLINE PIPE	Ⓜ MASTER VALVE
▲ HUNTER MP 1000 ROTATOR 4" PRS40	Ⓢ HUNTER ACC-99D DECODER CONTROLLER	⊙ BLOW OUT TEE
⊕ HUNTER ICV 1.5" ELECTRIC VALVE	⊕ HUNTER SOLAR SYNC WEATHER SENSOR	Ⓢ GROUND ROD
⊕ HUNTER ICV 1" ELECTRIC VALVE	Ⓢ FLOW SENSOR	
⊕ HUNTER 1" DRIP ZONE VALVE		



**CENTRAL**  
Lawn Sprinklers Inc.  
239 King Street • Elk Grove Village, IL 60007 • Phone: (847) 364-6900 • Fax: (847) 364-9774

**LAGRANGE ROAD IMPROVEMENTS**  
**ORLAND PARK, ILLINOIS**  
SEGMENT 1 - 171ST TO 159TH  
IRRIGATION AS-BUILT

PROJECT NO.	15780
DESIGNED BY:	KM
DRAWN BY:	KM
CHECKED BY:	JC
DATE:	SEPTEMBER 16, 2016
SCALE:	1" = 20'
SHEET	1

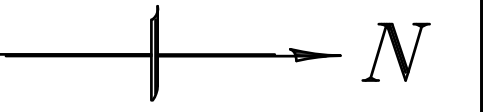

SCALE: 1"=20'-0"

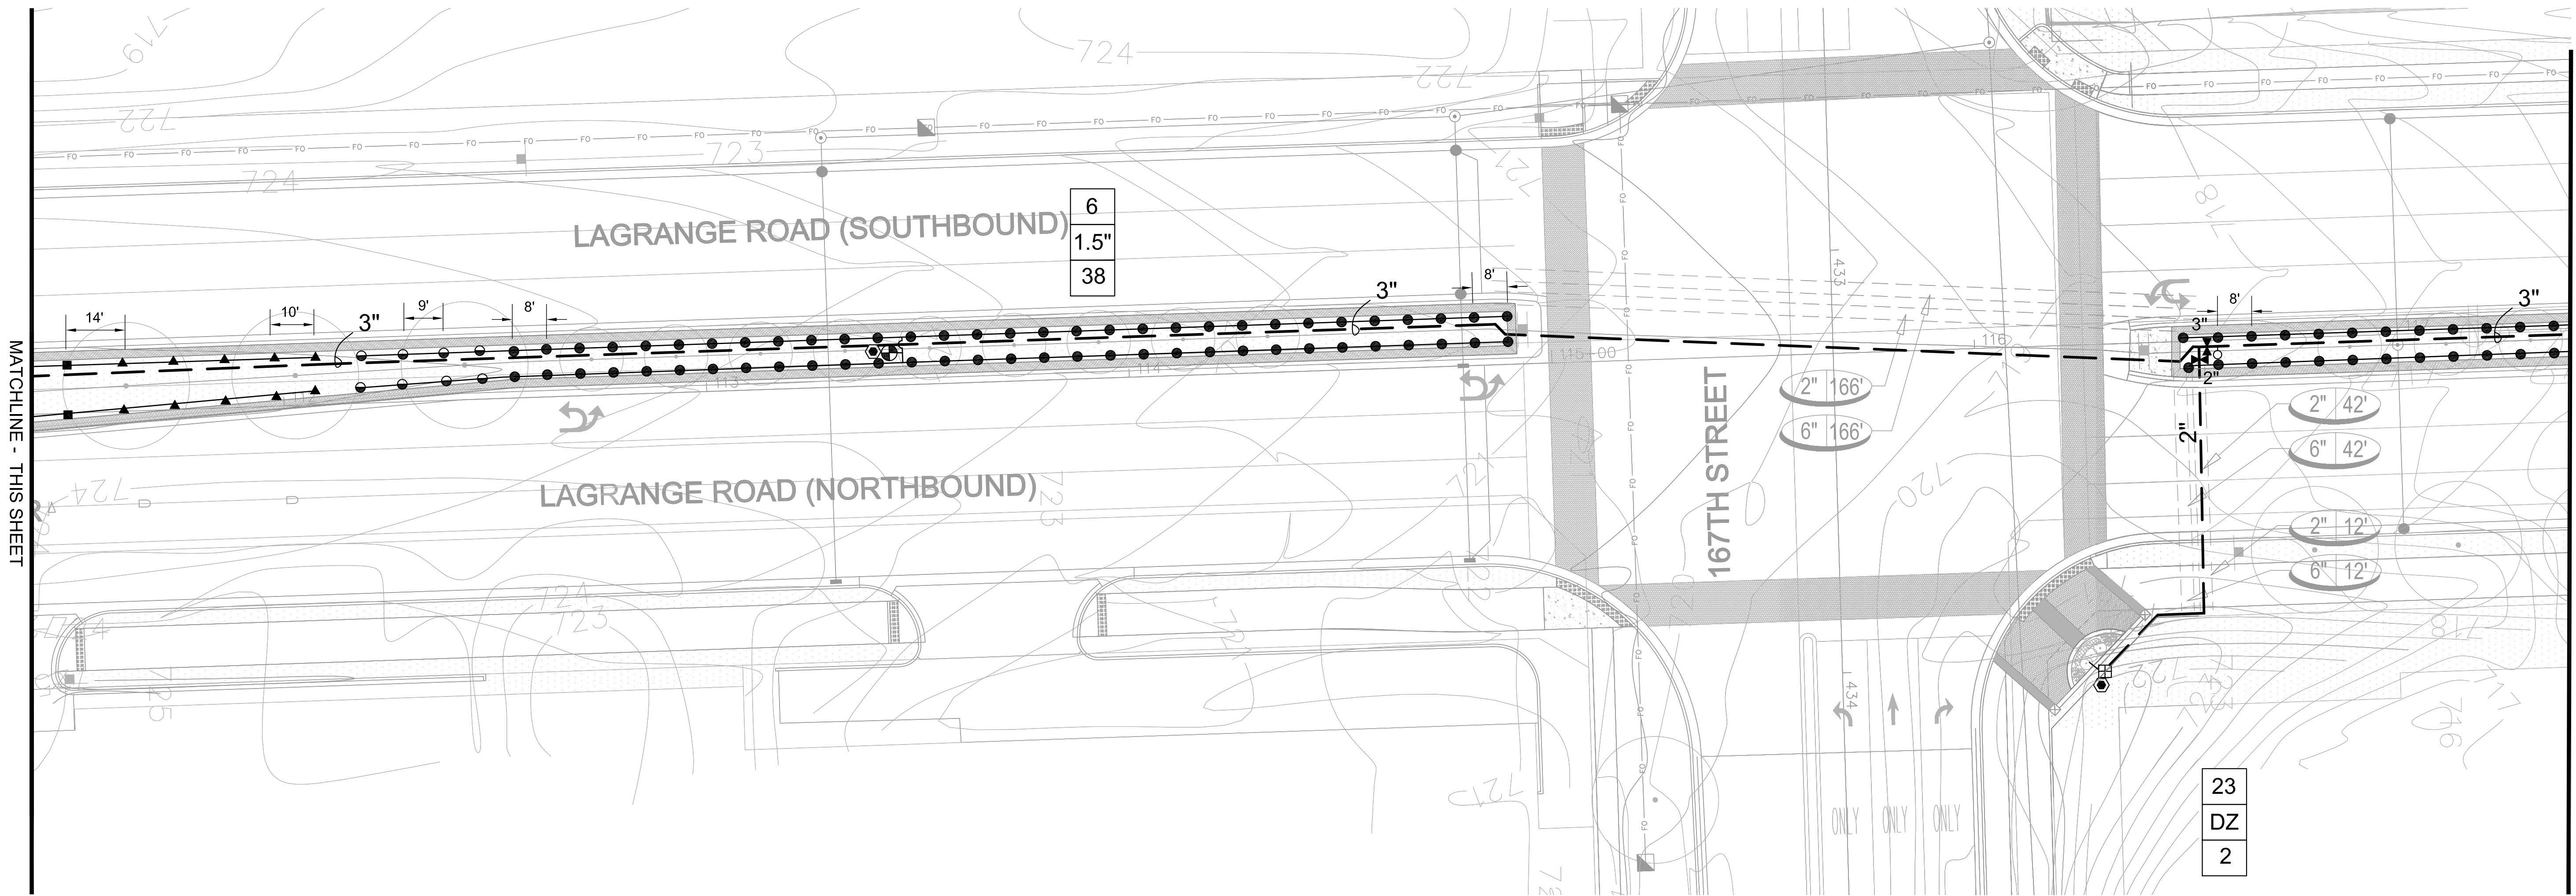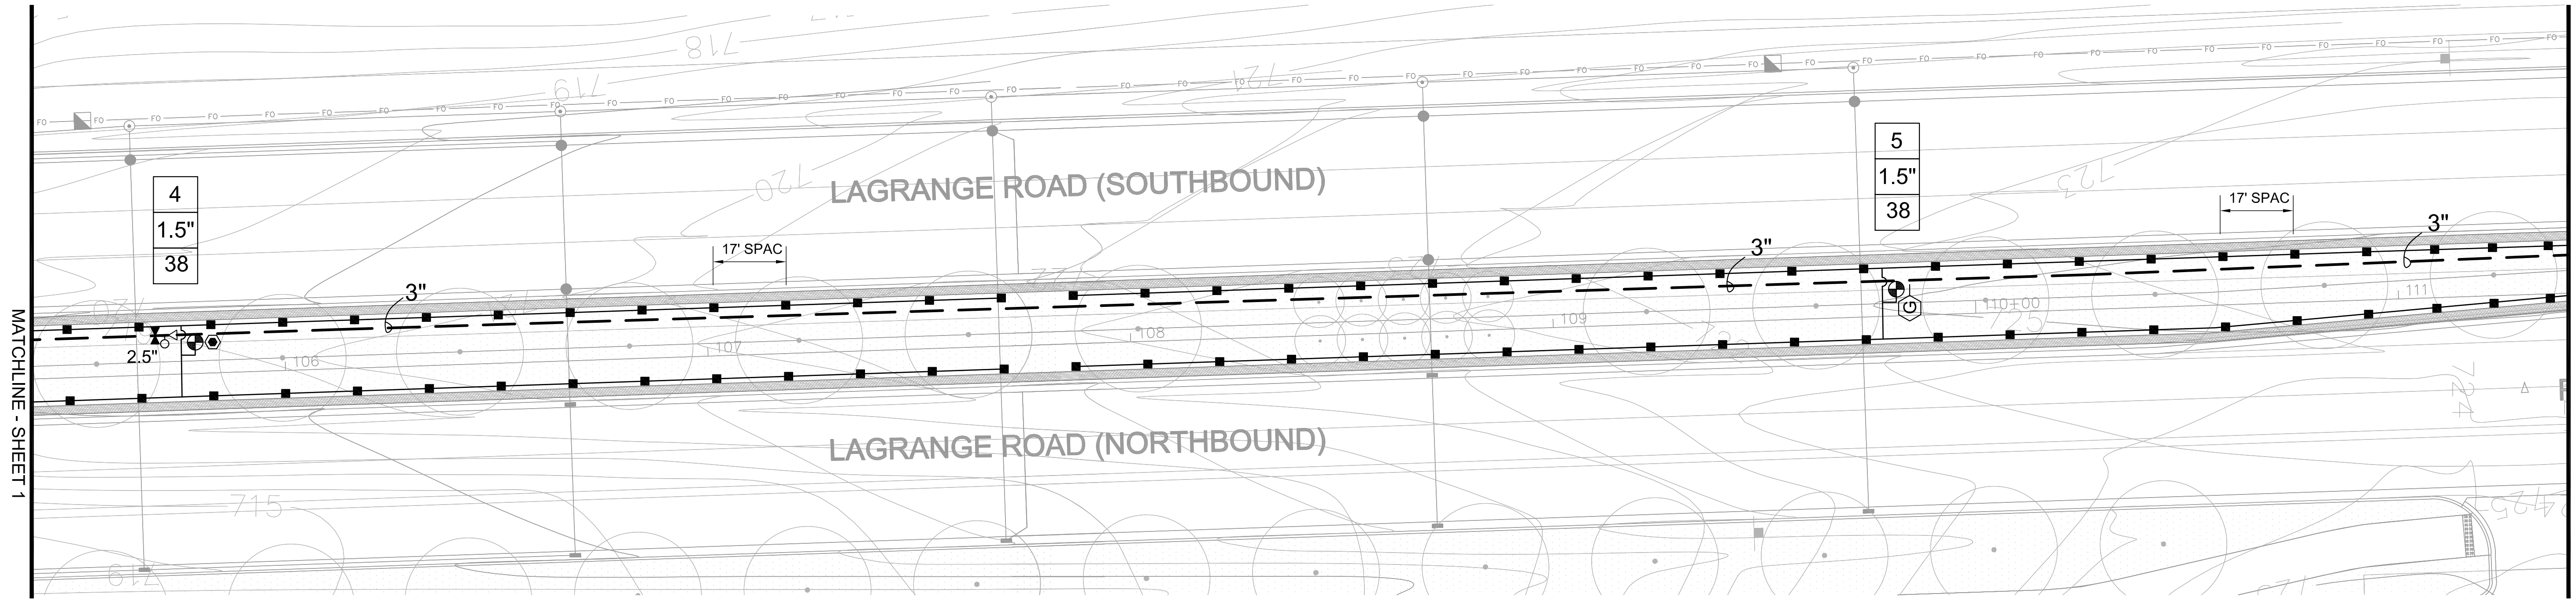

LEGEND

- |                                    |                                     |                                  |
|------------------------------------|-------------------------------------|----------------------------------|
| ● HUNTER 8H SPRAY HEAD 4" PRS30    | ⊠ LEEMCO MANUAL ISOLATION VALVE     | Ⓟ BOOSTER PUMP STATION           |
| ● HUNTER 10H SPRAY HEAD 4" PRS30   | ⊙ HUNTER LRC 1" QUICK COUPLER       | Ⓡ FEBCO 825YA BACKFLOW PREVENTER |
| ▬ HUNTER STRIP SPRAY HEAD 4" PRS30 | — LATERAL PIPE                      | Ⓜ WATER METER (PROVIDED BY CITY) |
| ■ HUNTER MP 2000 ROTATOR 4" PRS40  | — 3" PVC CL200 SDR21 MAINLINE PIPE  | Ⓜ MASTER VALVE                   |
| ▲ HUNTER MP 1000 ROTATOR 4" PRS40  | Ⓢ HUNTER ACC-99D DECODER CONTROLLER | ⊕ BLOW OUT TEE                   |
| ⊕ HUNTER ICV 1.5" ELECTRIC VALVE   | ⊙ HUNTER SOLAR SYNC WEATHER SENSOR  | Ⓧ GROUND ROD                     |
| ⊕ HUNTER ICV 1" ELECTRIC VALVE     | Ⓡ FLOW SENSOR                       |                                  |
| ⊕ HUNTER 1" DRIP ZONE VALVE        |                                     |                                  |



# CENTRAL

Lawn Sprinklers Inc.

239 King Street • Elk Grove Village, IL 60007 • Phone: (847) 364-6900 • Fax: (847) 364-9774

**LAGRANGE ROAD IMPROVEMENTS**  
**ORLAND PARK, ILLINOIS**  
 SEGMENT 1 - 171ST TO 159TH  
 IRRIGATION AS-BUILT

PROJECT NO.	15780
DESIGNED BY:	KM
DRAWN BY:	KM
CHECKED BY:	JC
DATE:	SEPTEMBER 16, 2016
SCALE:	1" = 20'
SHEET	2

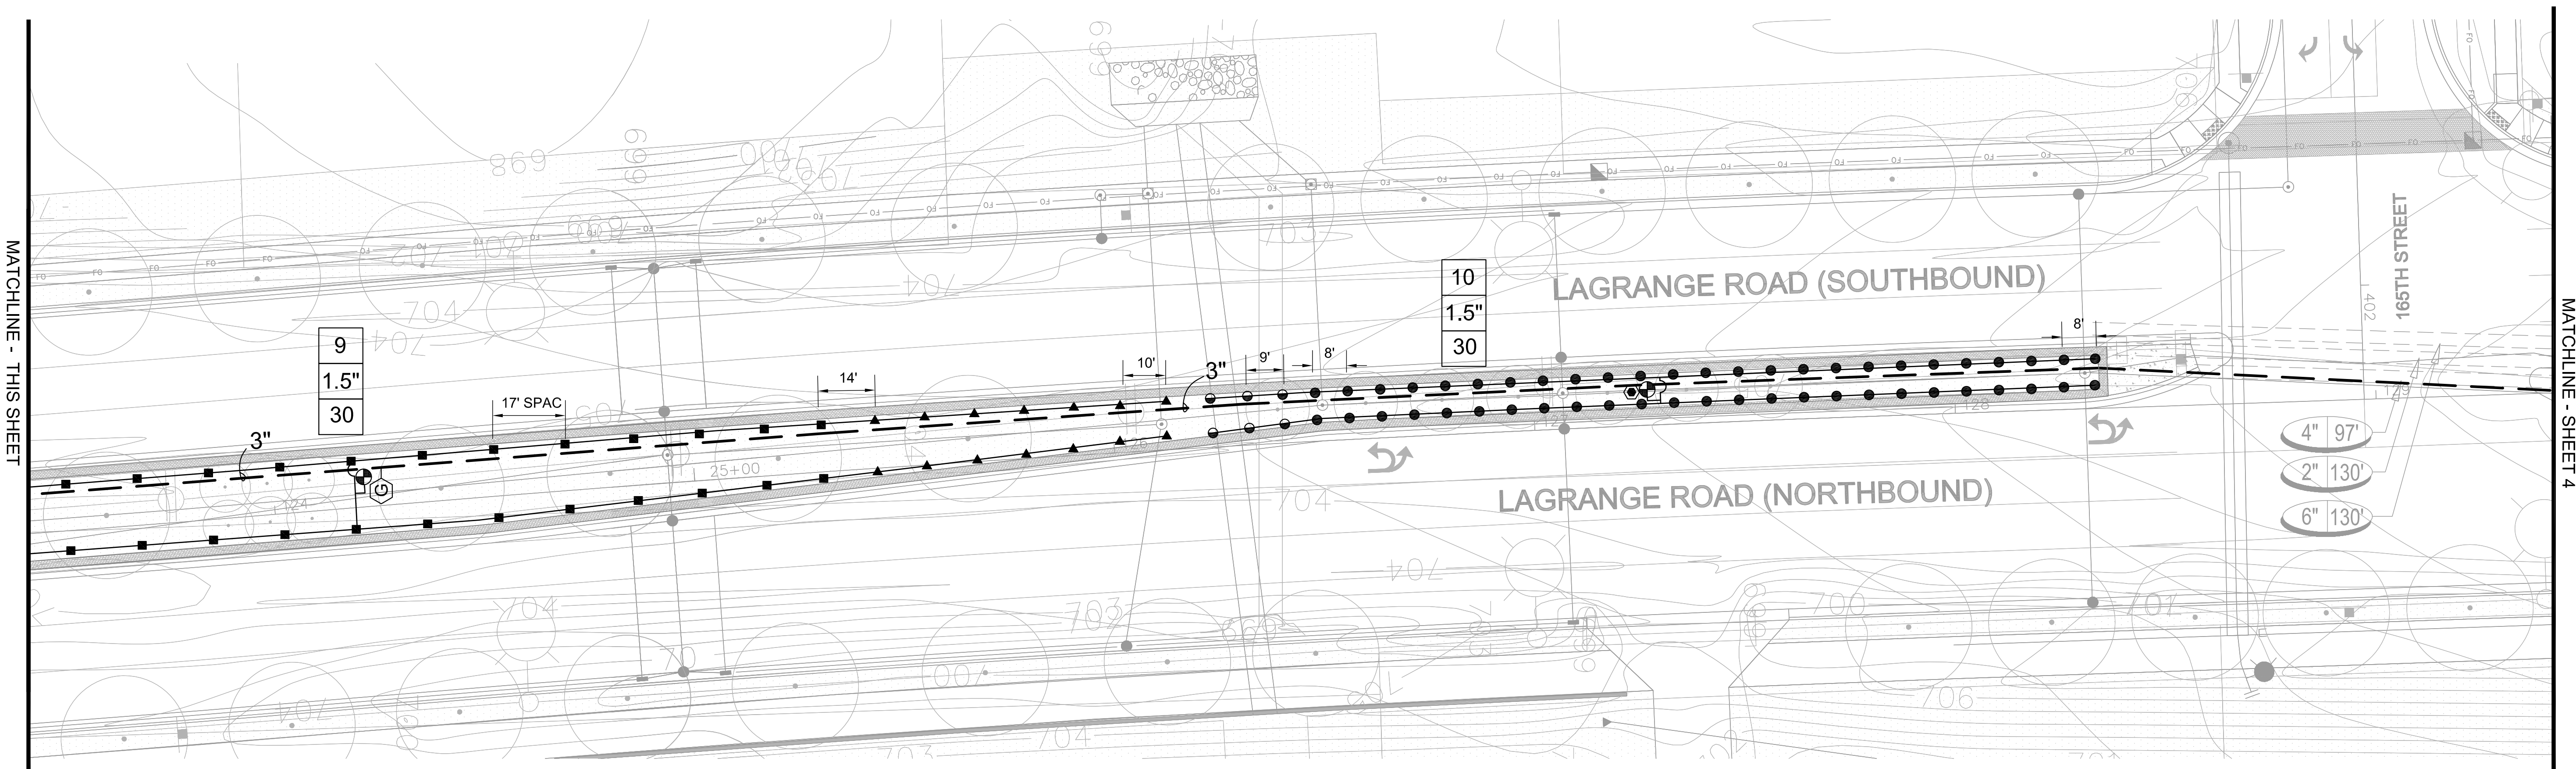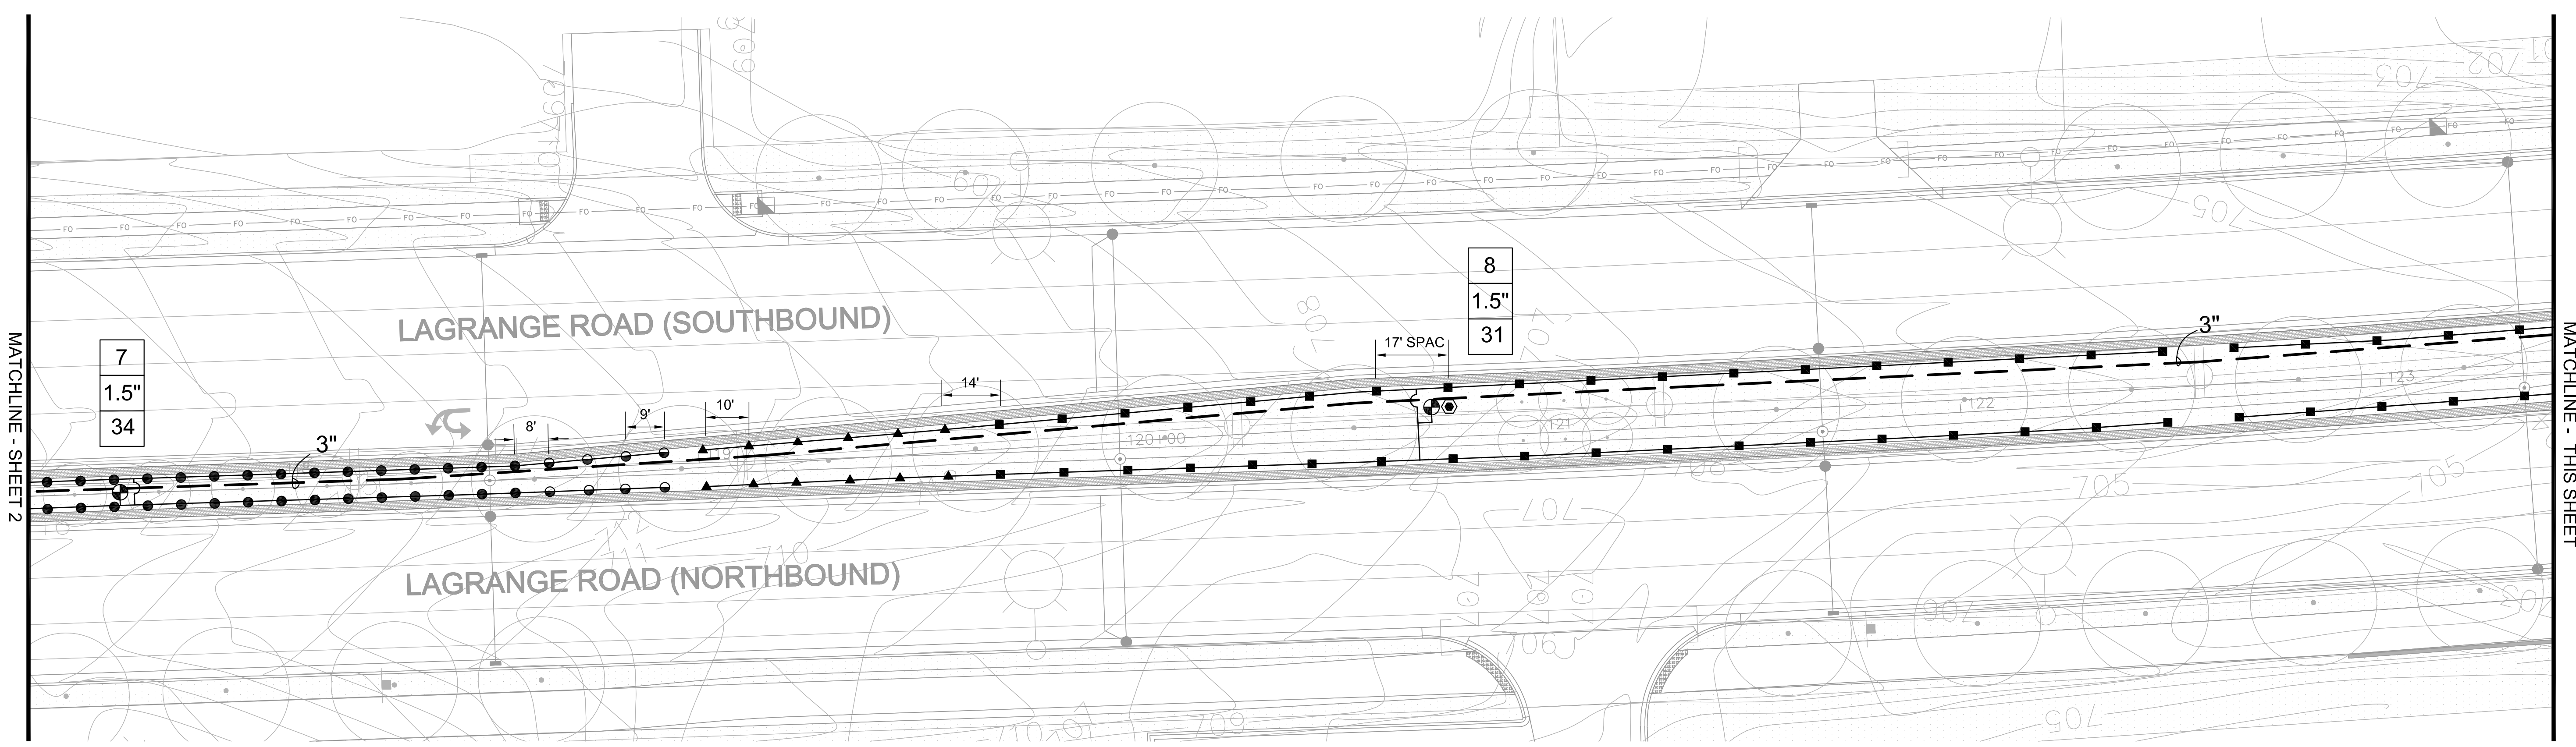

LEGEND



● HUNTER 8H SPRAY HEAD 4" PRS30	◄ LEEMCO MANUAL ISOLATION VALVE	Ⓚ BOOSTER PUMP STATION
● HUNTER 10H SPRAY HEAD 4" PRS30	⊙ HUNTER LRC 1" QUICK COUPLER	Ⓜ FEBCO 825YA BACKFLOW PREVENTER
▬ HUNTER STRIP SPRAY HEAD 4" PRS 30	— LATERAL PIPE	Ⓜ WATER METER ( PROVIDED BY CITY)
■ HUNTER MP 2000 ROTATOR 4" PRS40	3" PVC CL200 SDR21 MAINLINE PIPE	Ⓜ MASTER VALVE
▲ HUNTER MP 1000 ROTATOR 4" PRS40	Ⓚ HUNTER ACC-99D DECODER CONTROLLER	Ⓚ BLOW OUT TEE
⊕ HUNTER ICV 1.5" ELECTRIC VALVE	⊕ HUNTER SOLAR SYNC WEATHER SENSOR	Ⓚ GROUND ROD
■ HUNTER ICV 1" ELECTRIC VALVE	Ⓚ FLOW SENSOR	
Ⓚ HUNTER 1" DRIP ZONE VALVE		

**CENTRAL**  
*Lawn Sprinklers Inc.*

239 King Street • Elk Grove Village, IL 60007 • Phone: (847) 364-6900 • Fax: (847) 364-9774

**LAGRANGE ROAD IMPROVEMENTS**  
**ORLAND PARK, ILLINOIS**  
**SEGMENT 1 - 171ST TO 159TH**  
**IRRIGATION AS-BUILT**

PROJECT NO.	15780
DESIGNED BY:	KM
DRAWN BY:	KM
CHECKED BY:	JC
DATE:	SEPTEMBER 16, 2016
SCALE:	1" = 20'
SHEET	3

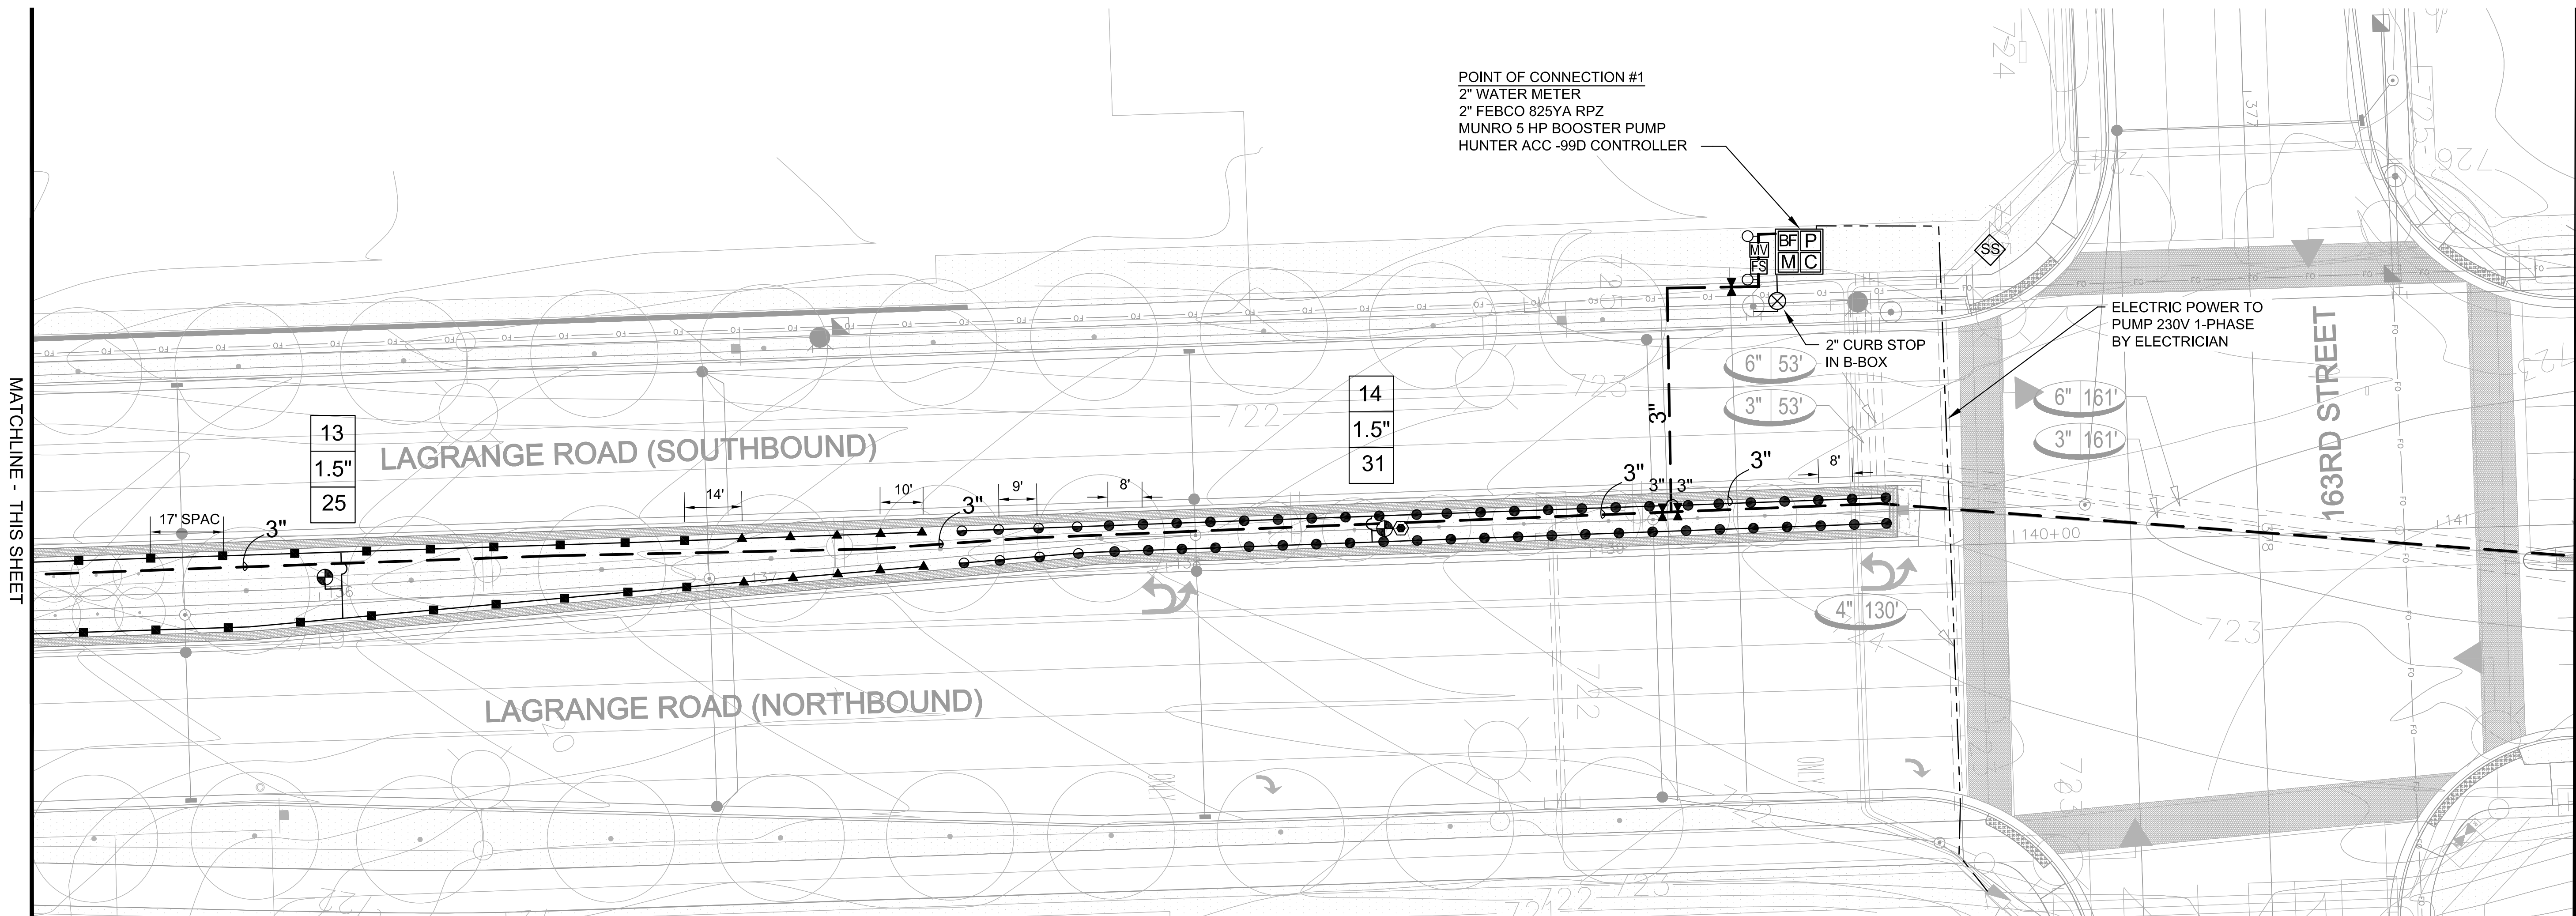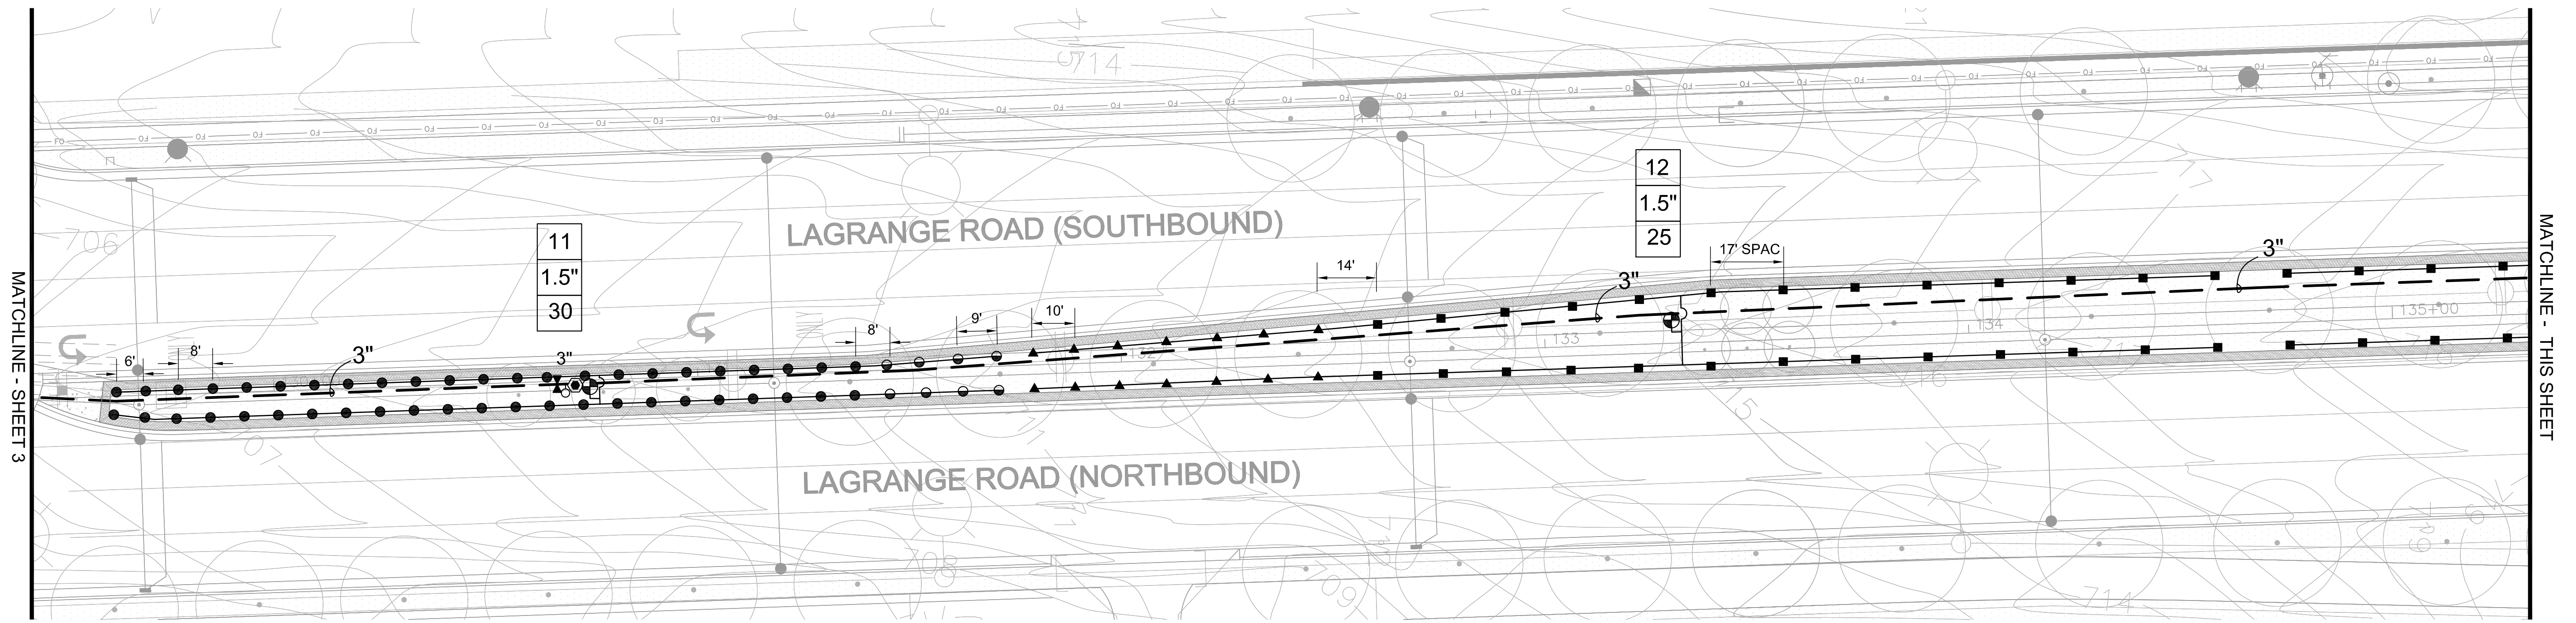

LEGEND



● HUNTER 8H SPRAY HEAD 4" PRS30	⊠ LEEMCO MANUAL ISOLATION VALVE	Ⓜ BOOSTER PUMP STATION
● HUNTER 10H SPRAY HEAD 4" PRS30	⊙ HUNTER LRC 1" QUICK COUPLER	Ⓛ FEBCO 825YA BACKFLOW PREVENTER
▬ HUNTER STRIP SPRAY HEAD 4" PRS 30	— LATERAL PIPE	Ⓜ WATER METER ( PROVIDED BY CITY)
■ HUNTER MP 2000 ROTATOR 4" PRS40	— 3" PVC CL200 SDR21 MAINLINE PIPE	Ⓜ MASTER VALVE
▲ HUNTER MP 1000 ROTATOR 4" PRS40	Ⓜ HUNTER ACC-99D DECODER CONTROLLER	⊙ BLOW OUT TEE
⊙ HUNTER ICV 1.5" ELECTRIC VALVE	Ⓜ HUNTER SOLAR SYNC WEATHER SENSOR	Ⓜ GROUND ROD
■ HUNTER ICV 1" ELECTRIC VALVE	Ⓜ FLOW SENSOR	
Ⓜ HUNTER 1" DRIP ZONE VALVE		

**CENTRAL**  
*Lawn Sprinklers Inc.*

239 King Street • Elk Grove Village, IL 60007 • Phone: (847) 364-6900 • Fax: (847) 364-9774

**LAGRANGE ROAD IMPROVEMENTS**  
**ORLAND PARK, ILLINOIS**  
**SEGMENT 1 - 171ST TO 159TH**  
**IRRIGATION AS-BUILT**

PROJECT NO.	15780
DESIGNED BY:	KM
DRAWN BY:	KM
CHECKED BY:	JC
DATE:	SEPTEMBER 16, 2016
SCALE:	1" = 20'
SHEET	4

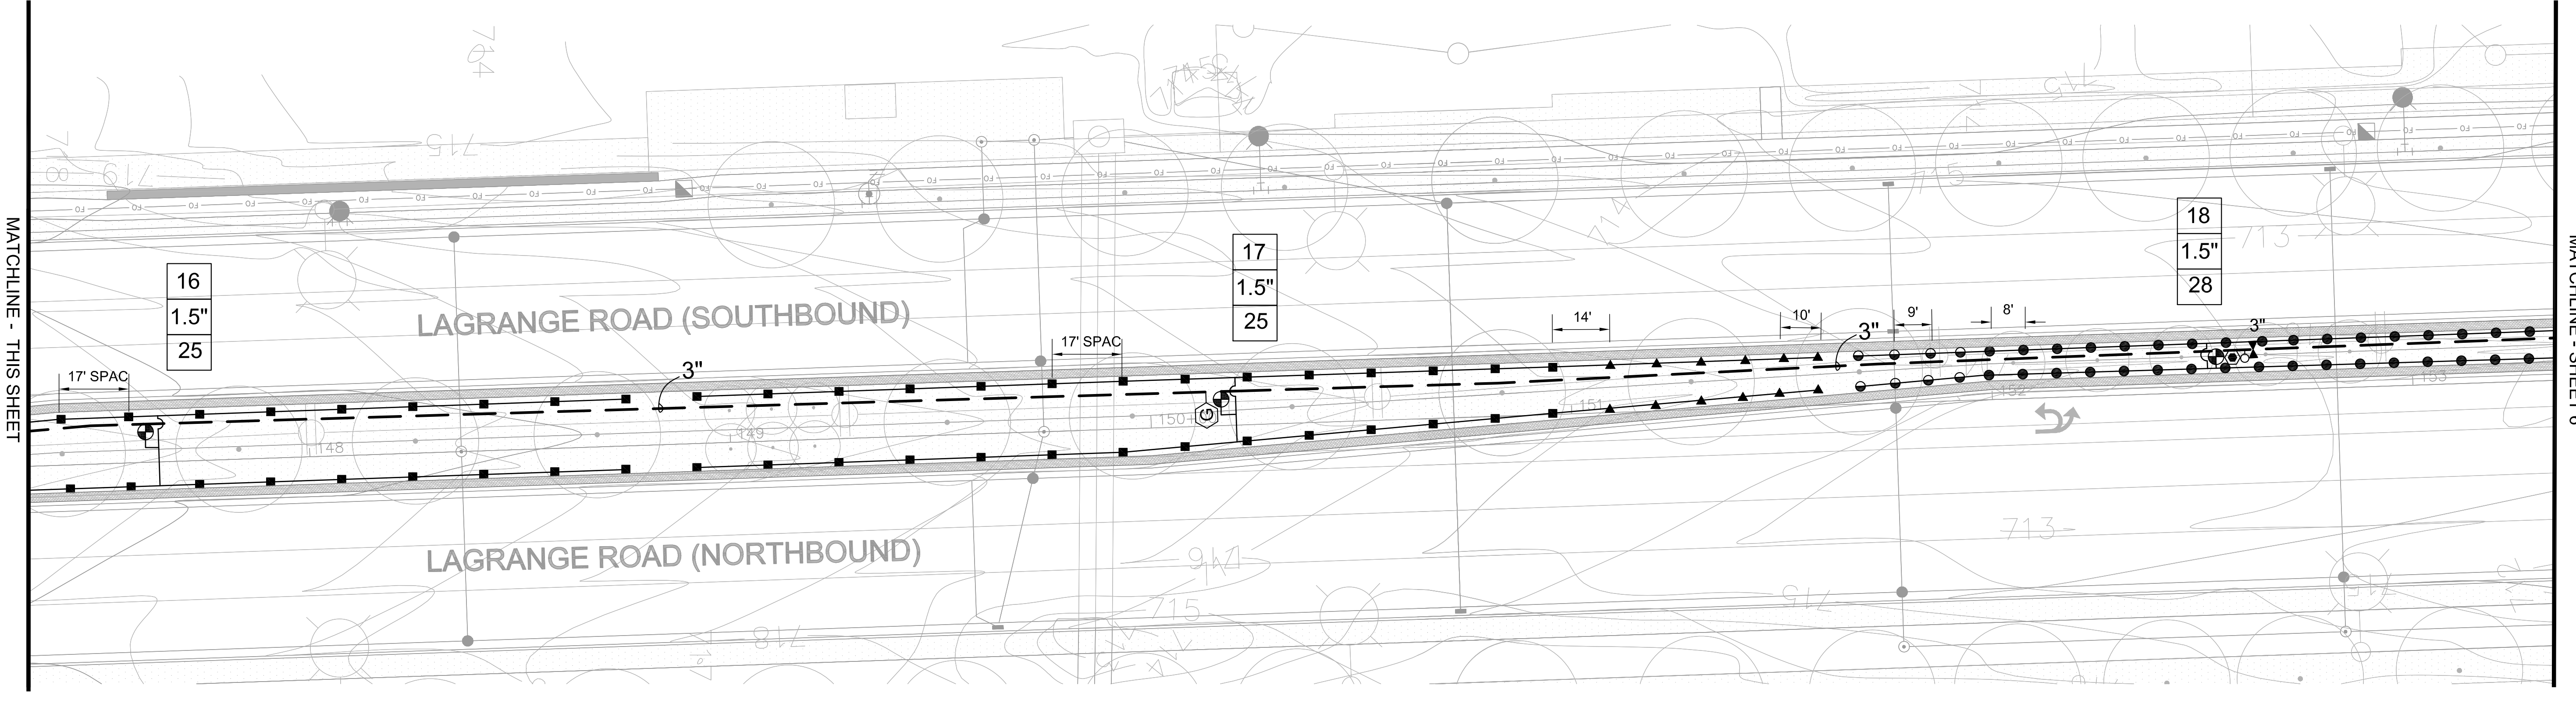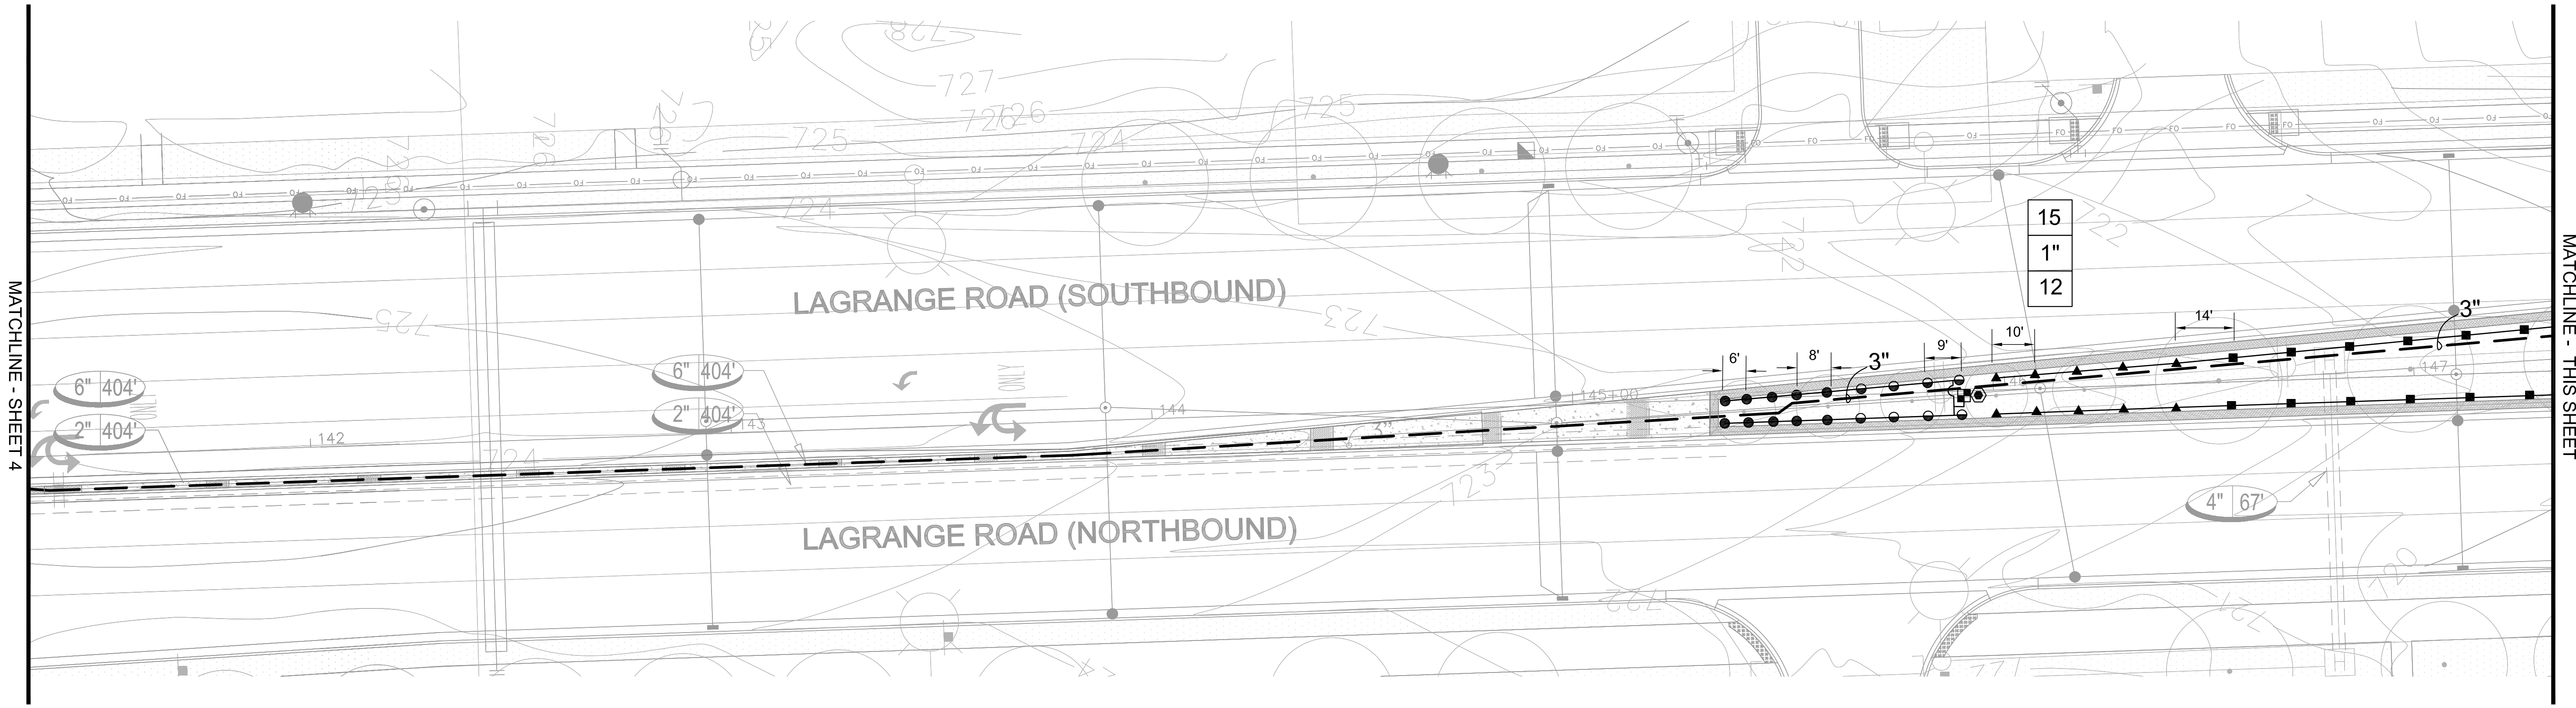


**LEGEND**

● HUNTER 8H SPRAY HEAD 4" PRS30	⊠ LEEMCO MANUAL ISOLATION VALVE	Ⓟ BOOSTER PUMP STATION
● HUNTER 10H SPRAY HEAD 4" PRS30	⊙ HUNTER LRC 1" QUICK COUPLER	Ⓡ FEBCO 825YA BACKFLOW PREVENTER
▬ HUNTER STRIP SPRAY HEAD 4" PRS40	— LATERAL PIPE	Ⓜ WATER METER (PROVIDED BY CITY)
■ HUNTER MP 2000 ROTATOR 4" PRS40	— 3" PVC CL200 SDR21 MAINLINE PIPE	Ⓜ MASTER VALVE
▲ HUNTER MP 1000 ROTATOR 4" PRS40	Ⓢ HUNTER ACC-99D DECODER CONTROLLER	⊙ BLOW OUT TEE
⊕ HUNTER ICV 1.5" ELECTRIC VALVE	⊕ HUNTER SOLAR SYNC WEATHER SENSOR	Ⓢ GROUND ROD
⊕ HUNTER ICV 1" ELECTRIC VALVE	Ⓢ FLOW SENSOR	
⊕ HUNTER 1" DRIP ZONE VALVE		



**CENTRAL**  
 Lawn Sprinklers Inc.  
 239 King Street • Elk Grove Village, IL 60007 • Phone: (847) 364-6900 • Fax: (847) 364-9774

**LAGRANGE ROAD IMPROVEMENTS**  
**ORLAND PARK, ILLINOIS**  
**SEGMENT 1 - 171ST TO 159TH**  
**IRRIGATION AS-BUILT**

PROJECT NO.	15780
DESIGNED BY:	KM
DRAWN BY:	KM
CHECKED BY:	JC
DATE:	SEPTEMBER 16, 2016
SCALE:	1" = 20'
SHEET	5

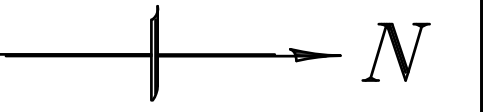

SCALE: 1"=20'-0"

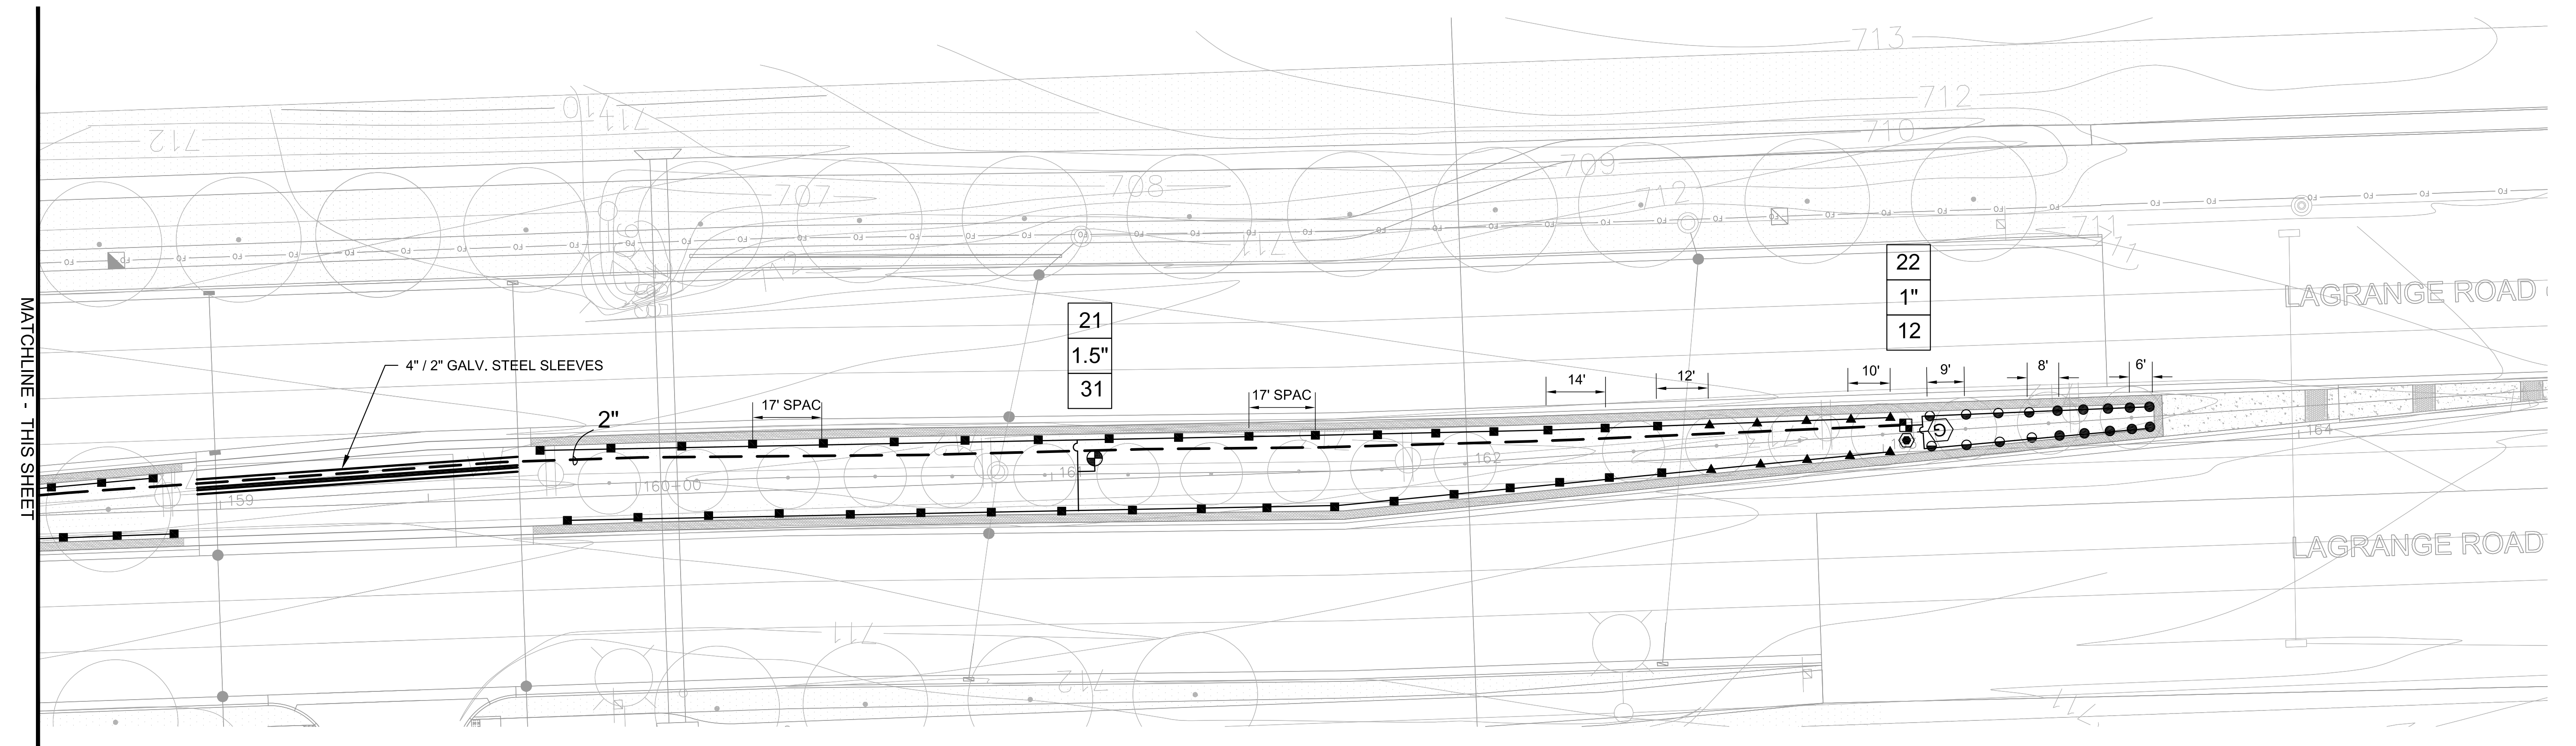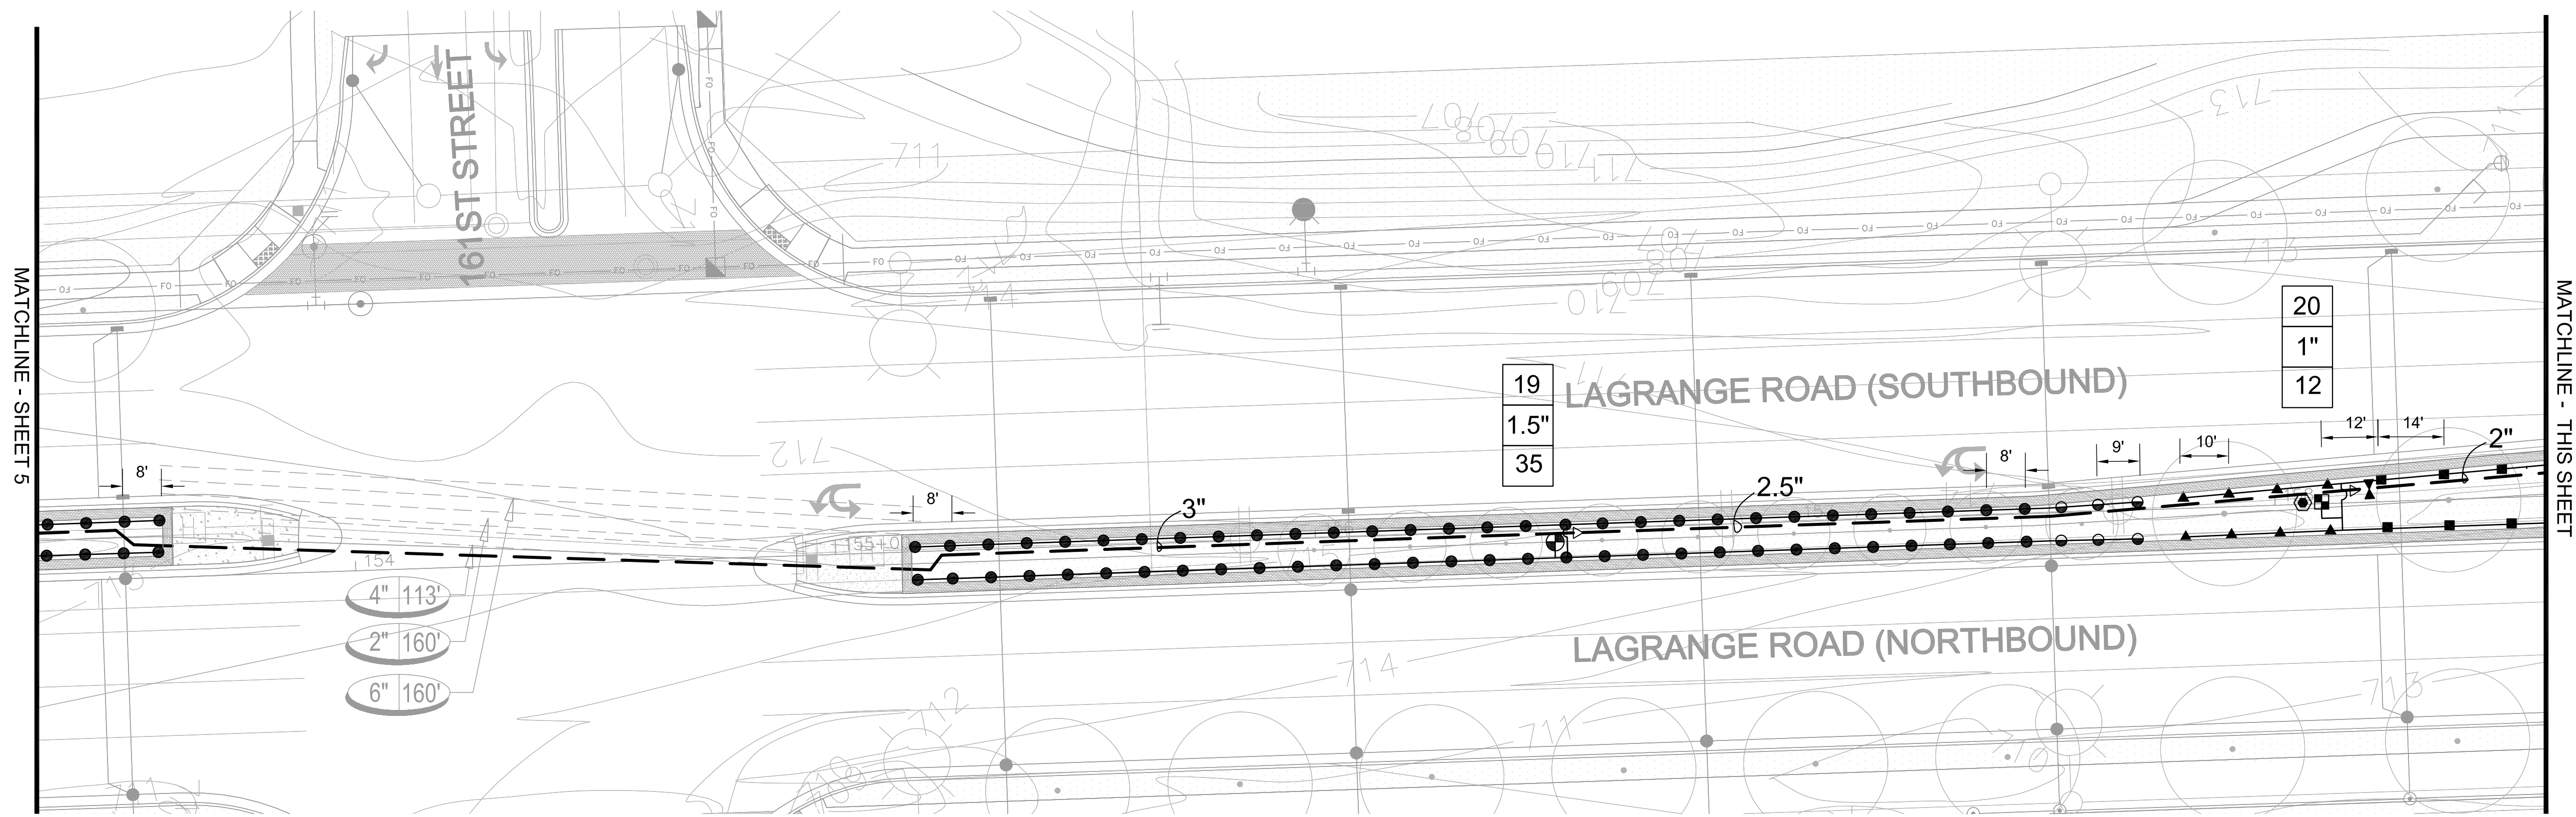

LEGEND

- HUNTER 8H SPRAY HEAD 4" PRS30
- HUNTER 10H SPRAY HEAD 4" PRS30
- HUNTER STRIP SPRAY HEAD 4" PRS 30
- HUNTER MP 2000 ROTATOR 4" PRS40
- ▲ HUNTER MP 1000 ROTATOR 4" PRS40
- ⊕ HUNTER ICV 1.5" ELECTRIC VALVE
- HUNTER ICV 1" ELECTRIC VALVE
- ⊞ HUNTER 1" DRIP ZONE VALVE
- ◄ LEEMCO MANUAL ISOLATION VALVE
- ⊙ HUNTER LRC 1" QUICK COUPLER
- LATERAL PIPE
- 3" PVC CL200 SDR21 MAINLINE PIPE
- ⓐ HUNTER ACC-99D DECODER CONTROLLER
- ⊕ HUNTER SOLAR SYNC WEATHER SENSOR
- ⓐ FLOW SENSOR
- ⓐ BOOSTER PUMP STATION
- ⓐ FEBCO 825YA BACKFLOW PREVENTER
- ⓐ WATER METER (PROVIDED BY CITY)
- ⓐ MASTER VALVE
- ⓐ BLOW OUT TEE
- ⓐ GROUND ROD

# CENTRAL

Lawn Sprinklers Inc.

239 King Street • Elk Grove Village, IL 60007 • Phone: (847) 364-6900 • Fax: (847) 364-9774

**LAGRANGE ROAD IMPROVEMENTS**  
**ORLAND PARK, ILLINOIS**  
 SEGMENT 1 - 171ST TO 159TH  
 IRRIGATION AS-BUILT

PROJECT NO.	15780
DESIGNED BY:	KM
DRAWN BY:	KM
CHECKED BY:	JC
DATE:	SEPTEMBER 16, 2016
SCALE:	1" = 20'
SHEET	6