

MATERIAL SCHEDULE

Proposed Site Landscape Improvements (Sheets L1 and L2)
 From: [unclear] Date: [unclear]

Item No.	Description	Quantity	Unit	Notes
1	15-MOHICAN VIBURNUM 8' H	10	PLANT	
2	1-AUSTRIAN PINE 18' H	10	PLANT	
3	4-MOHICAN VIBURNUM 8' H	10	PLANT	
4	3-AUSTRIAN PINE 13' H	10	PLANT	
5	2-DWARF WINGED EUONYMUS 4' H	10	PLANT	
6	4-GREEN COLORADO SPRUCE 18' H	10	PLANT	
7	3-RIVER BIRCH 22' H CLUMP	10	PLANT	
8	1-ARROWWOOD VIBURNUM 8' H	10	PLANT	
9	3-AUSTRIAN PINE 18' H	10	PLANT	

Item No.	Description	Quantity	Unit	Notes
10	LOW PROFILE MISC PRAIRIE GRASS MIX W/ EXCELSION EROSION BLANKET (PROPOSED 8-23-08)	10	SQ YD	
11	TURF	10	SQ YD	

Item No.	Description	Quantity	Unit	Notes
12	1-RED SUNSET RED MAPLE 3' CALIPER (PROPOSED 8-20-08)	10	PLANT	
13	1-RIVER BIRCH 22' H CLUMP	10	PLANT	
14	1-4-RIVER BIRCH 22' H CLUMP	10	PLANT	
15	1-4-RIVER BIRCH 22' H CLUMP	10	PLANT	

BOARD APPROVED

2008-0689

11-3-08

IONS ✓

IONS

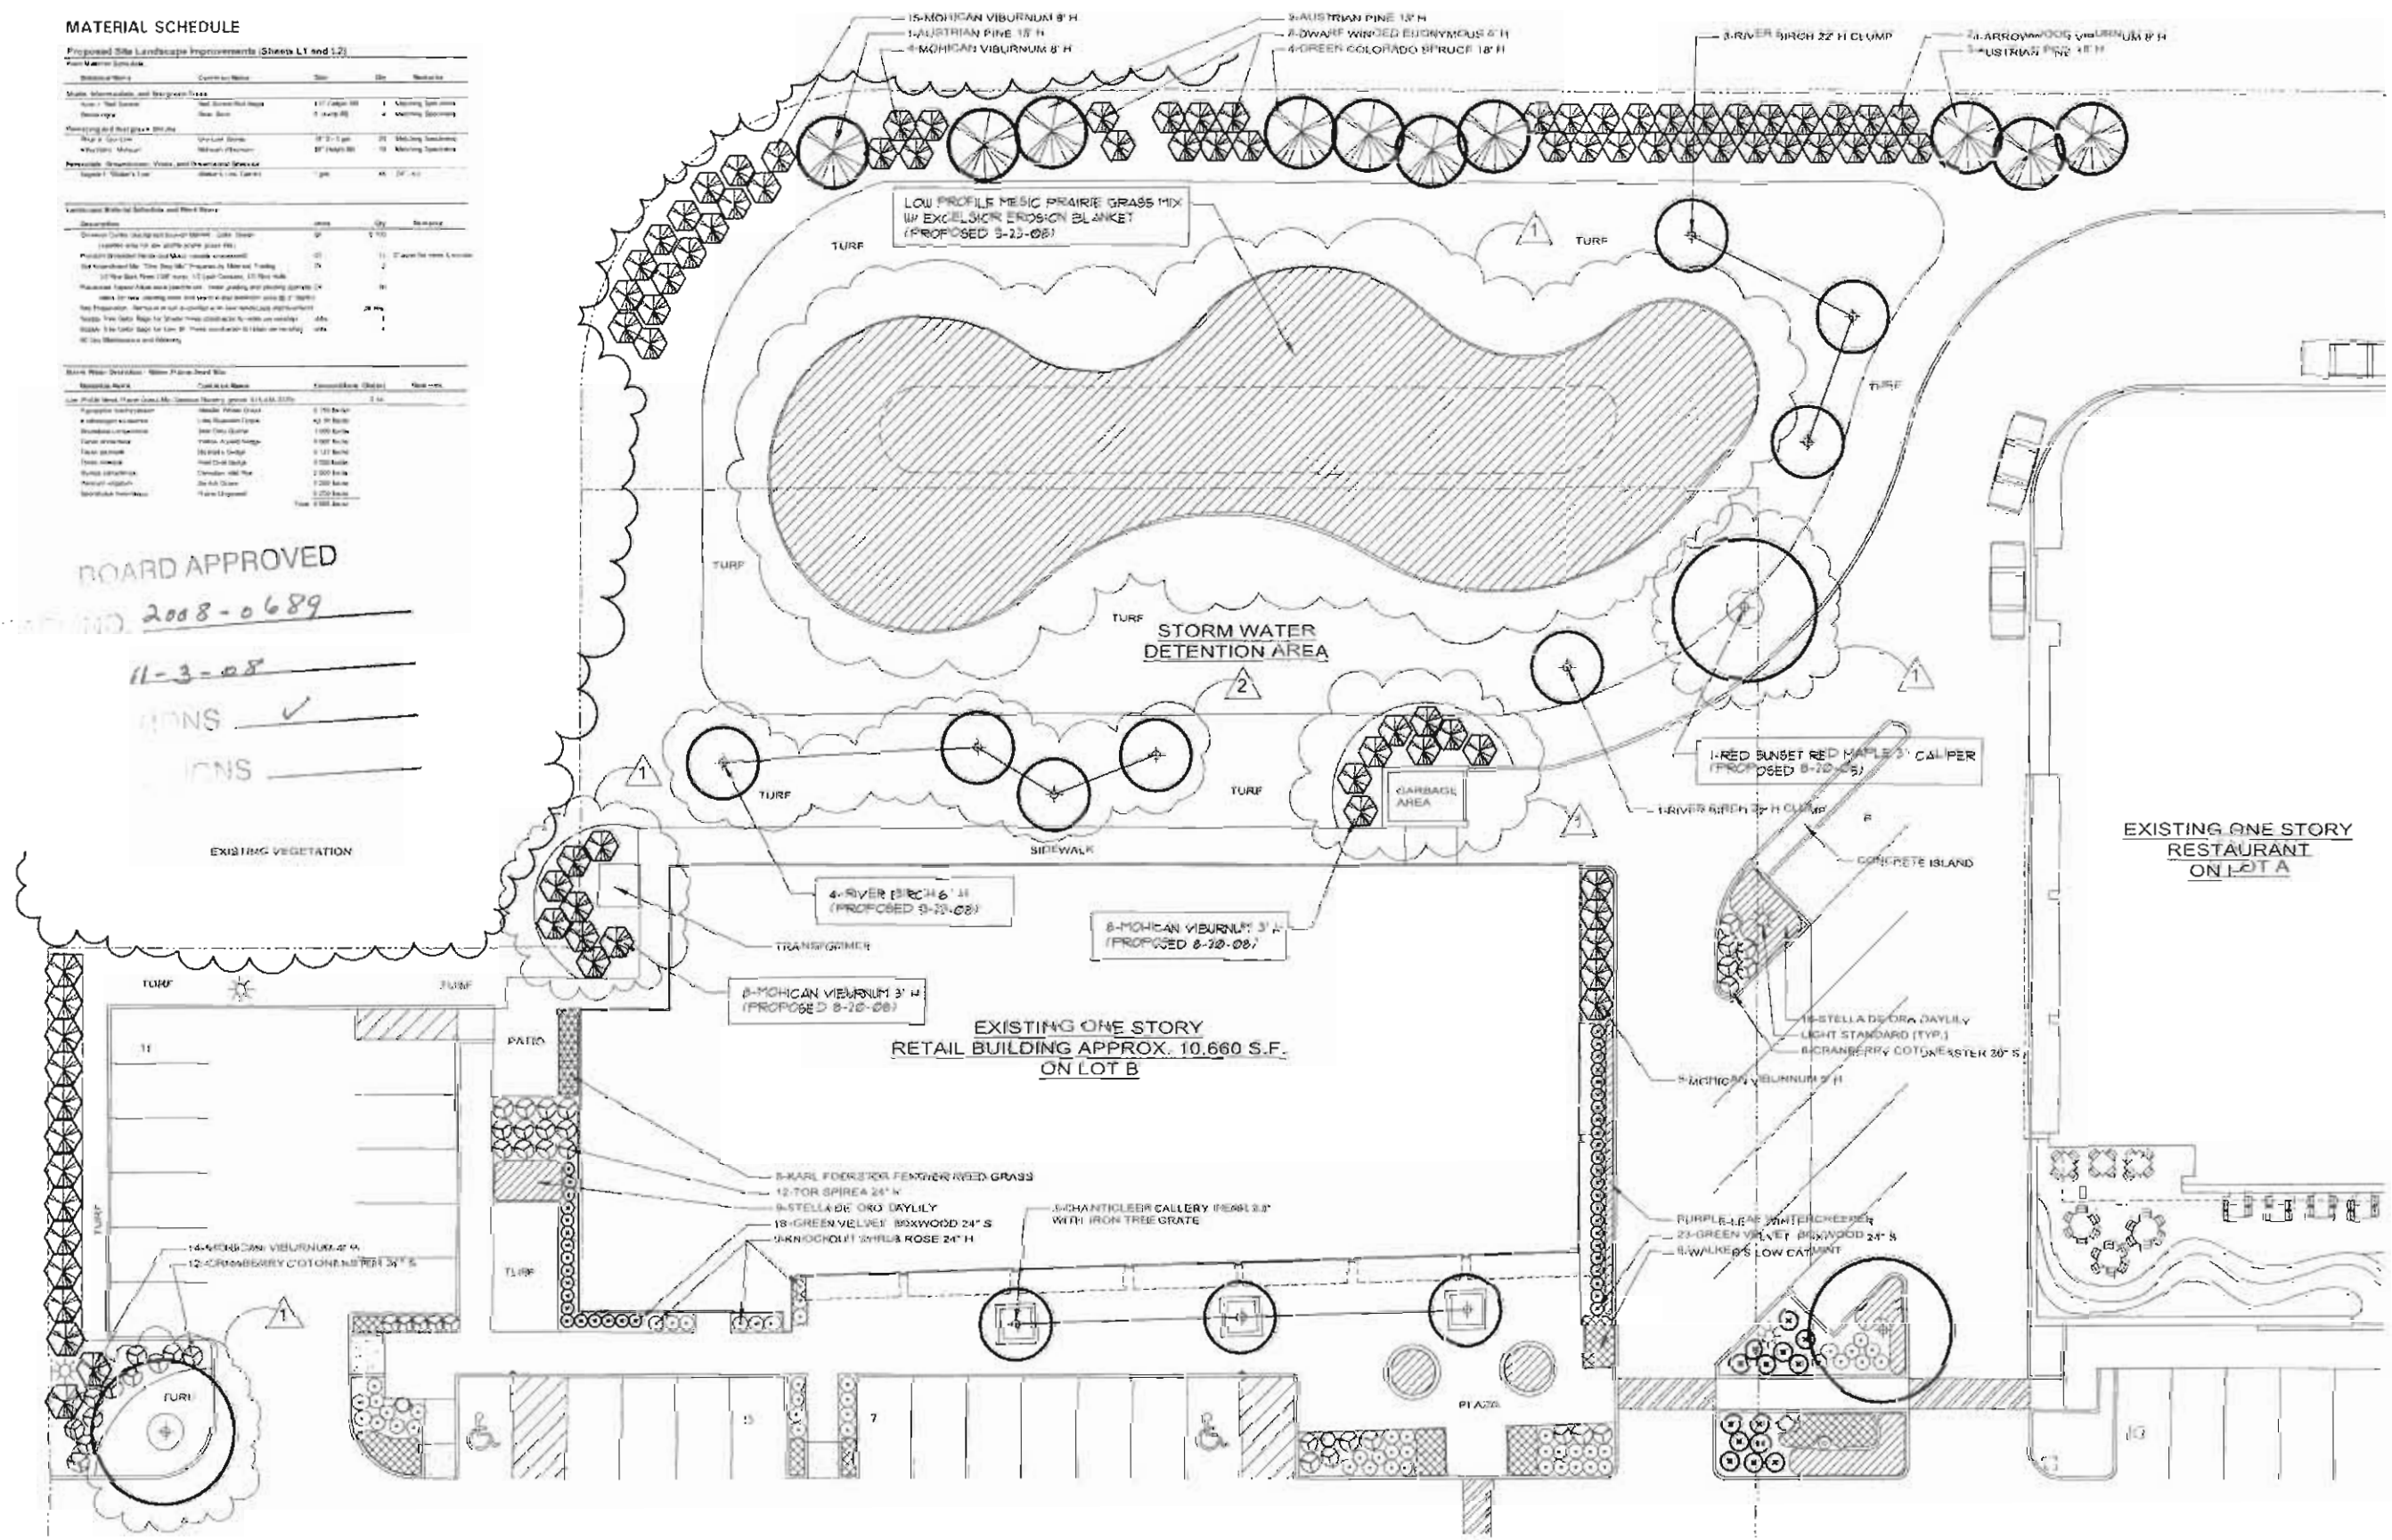

LANDSCAPE DEVELOPMENT PLAN - "AS-BUILT" CONDITIONS
 SCALE: 1" = 10'-0"